

RAY 120908 SIE  
MOR  
MAC  
STL



**SIENNA ENVIRONMENTAL TECHNOLOGIES, LLC**

429 Franklin St. · Suite 102 · Buffalo, NY 14202 · Ph: 716-332-3134 · Fax: 716-332-3136

December 31, 2008

Mr. Jeffrey Robbins  
C&S Engineers  
499 Colonel Eileen Collins Boulevard  
Syracuse, New York 13212

**Re: Summary of Asbestos Containing Materials by Building  
Upgrade Electrical Distribution System – Various Buildings  
SUCF Project No. 12290  
SUNY Potsdam  
Potsdam, New York**

FLG SRV  
CAR KNO  
KEL  
TIM  
STW  
CRM  
SAT  
THA  
DUW  
SIS  
BRI  
BAR  
MER  
MAX  
LEH  
CRN

Dear Mr. Robbins:

Enclosed please find a copy of the summary of asbestos containing materials in client-defined areas of twenty two buildings on the SUNY Potsdam campus located at 44 Pierrepont Avenue, Potsdam, New York. A comprehensive pre-renovation asbestos and lead inspection report shall be sent as a separate document after all results are evaluated in our office.

If after reviewing this summary you have any questions, or if we can be of assistance in any other way, please do not hesitate to call. Thank you for the opportunity to be of service to C&S Engineers and SUNY Potsdam.

Sincerely,

Susanne Kelley  
President



## Summary of Asbestos Containing Materials

### Introduction

Sienna Environmental Technologies was retained by C&S Engineers to perform an investigation of select areas of twenty two buildings on the SUNY Potsdam Campus in Potsdam, New York for the presence of suspect asbestos-containing materials. The inspection was limited to suspect materials present at client-defined locations of the buildings to be disturbed during the proposed renovation of the electrical distribution systems.

Sienna was charged with:

- \* Locating suspect asbestos containing materials at client defined locations
- \* Sampling of these materials to ascertain asbestos content
- \* Identifying the locations, quantities and conditions of confirmed asbestos containing materials

Samples were analyzed using PLM, Polarized Light Microscopy in accordance with NYS DOH ELAP Item #198.1 and/or #198.6. For materials classified as non-friable organically bound materials (NOBs), additional analysis was performed under Transmission Electron Microscopy (TEM) in accordance with NYS DOH ELAP Item #198.4. The results of the analyses confirmed whether or not a suspect material contained asbestos.



### Executive summary

The asbestos survey included identification, sampling, analysis and quantification of suspect materials within client defined areas of twenty two buildings located on the SUNY Potsdam campus which may be disturbed by current renovation plans.

#### A. Suspect asbestos-containing materials

The inspection was conducted between December 9, 2008 and December 17, 2008 and revealed the following materials as requiring sampling and analysis:

##### Raymond Hall

HAN Number	Description
RAY-100A / 200A	Drywall
RAY-100B / 200B	Drywall joint compound
RAY-101	Cinder block mortar
RAY-201	1x1 Spline dot and fissure ceiling tile
RAY-202	2x2 dot and texture ceiling tile

##### Morey Hall

HAN Number	Description
MOR-100A / 200A	Sand finish plaster skim coat
MOR-100B / 200B	Sand finish plaster base coat
MOR-101A / 202A	Smooth plaster skim coat
MOR-101B / 202B	Smooth plaster base coat
MOR-102A / 201A	Drywall
MOR-102B / 201B	Drywall joint compound

##### MacVicar Hall

HAN Number	Description
MCV-100A / 200A	Sand finish plaster skim coat
MCV-100B / 200B	Sand finish plaster base coat
MCV-201A	Ceiling smooth plaster skim coat
MCV-201B	Ceiling smooth plaster base coat

##### Stillman Hall

HAN Number	Description
STL-100A / 200A	Drywall
STL-100B / 200B	Drywall joint compound
STL-201	2x2 dot and large fissure ceiling tile



# SIENNA ENVIRONMENTAL TECHNOLOGIES, LLC

429 Franklin St. · Suite 102 · Buffalo, NY 14202 · Ph: 716-332-3134 · Fax: 716-332-3136

## Flagg Hall

HAN Number	Description
FLG-100	Cinder block mortar
FLG-101A / 201A	Plaster skim coat
FLG-101B / 201B	Plaster base coat
FLG-102A	Drywall
FLG-102B	Drywall joint compound
FLG-200	2x2 dot and texture ceiling tile
FLG-202	Popcorn ceiling finish
FLG-300	Brick floor mortar
FLG-400A	Cloth on mud fitting
FLG-400B	Mud fitting
FLG-600	Vibration dampener

## Carson Hall

HAN Number	Description
CAR-100A / 200A	Drywall
CAR-100B / 200B	Drywall joint compound
CAR-101	Cinder block mortar
CAR-102A	Plaster skim coat
CAR-102B	Plaster base coat
CAR-201	2x2 large fissure ceiling tile
CAR-202A	Textured plaster skim coat
CAR-202B	Textured plaster base coat

## Kellas Hall

HAN Number	Description
KEL-100	Cinder block mortar
KEL-101	Brick mortar
KEL-102A / 200A	Plaster skim coat
KEL-102B / 200B	Plaster base coat
KEL-103A	Drywall
KEL-103B	Drywall joint compound
KEL-201	2x4 ceiling tile
KEL-500	Spray-on Insulation

## Timmerman Hall

HAN Number	Description
TIM-100A / 200A	Plaster skim coat
TIM-100B / 200B	Plaster base coat
TIM-101	Cinder block mortar
TIM-102A	Grout of 2x2 ceramic tile
TIM-102B	Mortar of 2x2 ceramic tile



**Stowell Hall**

HAN Number	Description
STO-100	Cinder block mortar
STO-101	Glazed block mortar
STO-102	Cementitious panel
STO-103A / 202A	Plaster skim coat
STO-103B / 202B	Plaster base coat
STO-104	Mortar of white brick
STO-200	2x4 dot and fissure ceiling tile
STO-201	2x4 dot ceiling tile

**Crumb Library**

HAN Number	Description
CRU-100A	Plaster skim coat
CRU-100B	Plaster base coat
CRU-101	Cinder block mortar
CRU-102	Brick mortar
CRU-200	1x1 dot and fissure ceiling tile
CRU-201	2x2 dot and texture ceiling tile

**Satterlee Hall**

HAN Number	Description
SAT-100A / 201A	Plaster skim coat
SAT-100B / 201B	Plaster base coat
SAT-101A	Sand plaster skim coat
SAT-101B	Sand plaster base coat
SAT-102	Glazed block mortar
SAT-103	Cinder block mortar
SAT-104A	Drywall
SAT-104B	Drywall joint compound
SAT-200	1x1 splined ceiling tile
SAT-202	1x1 textured ceiling tile
SAT-203	2x2 dot and texture ceiling tile
SAT-204	2x2 dot ceiling tile

**Thatcher Hall**

HAN Number	Description
THA-100	Cinder block mortar
THA-101A	Grout of ceramic tile
THA-101B	Thinset of ceramic tile
THA-102A	Plaster skim coat
THA-102B	Plaster base coat
THA-200	1x1 fissure ceiling tile
THA-201	2x2 Gypsum ceiling tile



# SIENNA ENVIRONMENTAL TECHNOLOGIES, LLC

429 Franklin St. · Suite 102 · Buffalo, NY 14202 · Ph: 716-332-3134 · Fax: 716-332-3136

## Dunn Hall

HAN Number	Description
DUN-100A	Drywall
DUN-100B	Drywall joint compound
DUN-101	Glazed block mortar
DUN-200	2x2 dot ceiling tile
DUN-201A	1x1 dot ceiling tile
DUN-201B	Glue daub of 201A
DUN-202	2x2 large dot ceiling tile
DUN-203A	Plaster skim coat
DUN-203B	Plaster base coat
DUN-204	Textured finish
DUN-300	Terrazzo

## Sisson Hall

HAN Number	Description
SIS-100A	Plaster skim coat
SIS-100B	Plaster base coat
SIS-101	Lightweight concrete
SIS-102	Wallpaper
SIS-200	Insulation material
SIS-201A	1x1 texture ceiling tile
SIS-201B	Glue daub of 201A
SIS-202	2x2 dot ceiling tile
SIS-203	Texture ceiling

## Brainerd Hall

HAN Number	Description
BRA-100A / 202A	Plaster skim coat
BRA-100B / 202B	Plaster base coat
BRA-101	Cinder block mortar
BRA-200	2x4 dot ceiling tile
BRA-201	Popcorn ceiling finish
BRA-203A	Drywall
BRA-203B	Drywall joint compound
BRA-300	Brick mortar



# SIENNA ENVIRONMENTAL TECHNOLOGIES, LLC

429 Franklin St. · Suite 102 · Buffalo, NY 14202 · Ph: 716-332-3134 · Fax: 716-332-3136

## Barrington Student Union


HAN Number	Description
BAR-100A	Plaster skim coat
BAR-100B	Plaster base coat
BAR-101A	Drywall
BAR-101B	Drywall joint compound
BAR-102	Wallpaper
BAR-103	Cinder block mortar
BAR-200	2x4 dot and fissure ceiling tile
BAR-201	2x2 dot and fissure ceiling tile
BAR-202	2x2 smooth ceiling tile
BAR-203	1x1 ceiling tile
BAR-204	Popcorn ceiling finish

## Merritt Hall

HAN Number	Description
MER-100A / 200A	Plaster skim coat
MER-100B / 200B	Plaster base coat
MER-101	Glazed block mortar
MER-102A	Drywall
MER-102B	Drywall joint compound
MER-103A	Grout of ceramic tile
MER-103B	Thinset of ceramic tile
MER-104	Cinder block mortar
MER-105	Textured wall finish
MER-201A	1x1 dot ceiling tile
MER-201B	Glue daub of 201A
MER-202	2x2 cementitious ceiling tile
MER-203	2x2 dot and fissure ceiling tile
MER-300A	18x6 black floor tile
MER-300B	Black mastic of 300A
MER-301	Terrazzo

## Maxcy Hall

HAN Number	Description
MAX-100	Cinder block mortar
MAX-101	Brick mortar
MAX-200	2x4 dot ceiling tile
MAX-201	Popcorn ceiling finish

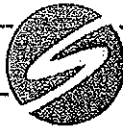

# SIENNA ENVIRONMENTAL TECHNOLOGIES, LLC

429 Franklin St. · Suite 102 · Buffalo, NY 14202 · Ph: 716-332-3134 · Fax: 716-332-3136

## Lehmann Dining Hall

HAN Number	Description
LEH-100A	Drywall
LEH-100B	Drywall joint compound

## Crane Music Complex

HAN Number	Description
CRA-100	Cinder block mortar
CRA-101A	Drywall
CRA-101B	Drywall joint compound
CRA-102	Cementitious wall board

## Heating Plant / Service Center

HAN Number	Description
HPL-100	Cinder block mortar
HPL-101	Brick mortar

## Knowles Dining Hall

HAN Number	Description
KNO-100	Brick mortar





**B. Confirmed asbestos-containing materials**

Sampling and analysis of the suspect materials under Polarized Light Microscopy, and where necessary under Transmission Electron Microscopy, confirmed the following materials as asbestos containing building materials (laboratory reports and chains of custody are attached):

**Raymond Hall**

Material #	Description - Component	Condition
RAY-100B/200B	Drywall joint compound – Walls and ceilings	I

**Morey Hall**

- All samples were analyzed as less than 1% asbestos. Materials are considered asbestos-containing when they are analyzed as greater than 1% asbestos.

**MacVicar Hall**

- All samples were analyzed as less than 1% asbestos. Materials are considered asbestos-containing when they are analyzed as greater than 1% asbestos.

**Stillman Hall**

- All samples were analyzed as less than 1% asbestos. Materials are considered asbestos-containing when they are analyzed as greater than 1% asbestos.

**Flagg Hall**

- All samples were analyzed as less than 1% asbestos. Materials are considered asbestos-containing when they are analyzed as greater than 1% asbestos.

**Carson Hall**

Material #	Description - Component	Condition
CAR-202A	Textured plaster skim coat – Ceilings	I

**Kelias Hall**

- All samples were analyzed as less than 1% asbestos. Materials are considered asbestos-containing when they are analyzed as greater than 1% asbestos.

**Timmerman Hall**

- All samples were analyzed as less than 1% asbestos. Materials are considered asbestos-containing when they are analyzed as greater than 1% asbestos.



**Stowell Hall**

Material #	Description - Component	Condition
STO-102	Cementitious panel – Room 116 walls	I

**Crumb Library**

- All samples were analyzed as less than 1% asbestos. Materials are considered asbestos-containing when they are analyzed as greater than 1% asbestos.

**Satterlee Hall**

- All samples were analyzed as less than 1% asbestos. Materials are considered asbestos-containing when they are analyzed as greater than 1% asbestos.

**Thatcher Hall**

- All samples were analyzed as less than 1% asbestos. Materials are considered asbestos-containing when they are analyzed as greater than 1% asbestos.

**Dunn Hall**

- All samples were analyzed as less than 1% asbestos. Materials are considered asbestos-containing when they are analyzed as greater than 1% asbestos.

**Slsson Hall**

- All samples were analyzed as less than 1% asbestos. Materials are considered asbestos-containing when they are analyzed as greater than 1% asbestos.

**Brainerd Hall**

- All samples were analyzed as less than 1% asbestos. Materials are considered asbestos-containing when they are analyzed as greater than 1% asbestos.

**Barrington Student Union**

- All samples were analyzed as less than 1% asbestos. Materials are considered asbestos-containing when they are analyzed as greater than 1% asbestos.

**Merritt Hall**

Material #	Description - Component	Condition
MER-202	2x2 Cementitious ceiling tile – Ceiling over pool	I
MER-300A/300B	18x6 Floor tile and mastic – Women's locker room	I



# SIENNA ENVIRONMENTAL TECHNOLOGIES, LLC

429 Franklin St. · Suite 102 · Buffalo, NY 14202 · Ph: 716-332-3134 · Fax: 716-332-3136

## Maxcy Hall

- All samples were analyzed as less than 1% asbestos. Materials are considered asbestos-containing when they are analyzed as greater than 1% asbestos.

## Lehmann Dining Hall

- All samples were analyzed as less than 1% asbestos. Materials are considered asbestos-containing when they are analyzed as greater than 1% asbestos.

## Crane Music Complex

Material #	Description - Component	Condition
CRA-102	Transite wall board – Snell upper level control rooms	I

*Asbestos?*

## Heating Plant / Service Center

- All samples were analyzed as less than 1% asbestos. Materials are considered asbestos-containing when they are analyzed as greater than 1% asbestos.

## Knowles Dining Hall

- All samples were analyzed as less than 1% asbestos. Materials are considered asbestos-containing when they are analyzed as greater than 1% asbestos.

Condition Notes: I = Intact D = Damaged SD = Significantly Damaged



# SIENNA ENVIRONMENTAL TECHNOLOGIES, LLC

429 Franklin St. · Suite 102 · Buffalo, NY 14202 · Ph: 716-332-3134 · Fax: 716-332-3136

## LABORATORY REPORT

Attn: Jeffrey Robbins  
C & S Engineers  
499 Col. Eileen Collins Blvd  
Syracuse, NY 13212

Date Received: 12/12/2008

Date Analyzed: 12/18/2008

Sienna ID: P145

Phone: 315-455-2000

Fax: 315-455-9667

Project: SET954 Raymond Hall

### Polarized Light Microscopy (PLM) by NY State ELAP Method 198.1

Sample	Description	Location	% Fibrous	% Non-Fibrous	% Asbestos Type
1209-RAY-100A-1 P145-1	Gray, Fibrous, Non-Homogenous	Drywall - 8th Floor	20%	80%	NAD
1209-RAY-100A-2 P145-2	Gray, Fibrous, Non-Homogenous	Drywall - 7th Floor	20%	80%	NAD
1209-RAY-100B-1 P145-3	White, Fibrous, Homogenous	Joint Compound - 8th Floor	0%	100%	NAD
1209-RAY-100B-2 P145-4	White, Non-Fibrous, Homogenous	Joint Compound - 7th Floor	5%	95%	NAD
1209-RAY-100B-3 P145-5	White, Non-Fibrous, Homogenous	Joint Compound - 5th Floor	0%	100%	NAD
1209-RAY-100B-4 P145-6	White, Non-Fibrous, Homogenous	Joint Compound - 4th Floor	5%	95%	NAD
1209-RAY-100B-5 P145-7	White, Non-Fibrous, Homogenous	Joint Compound - 2nd Floor	5%	95%	1.8% Chrysotile
1209-RAY-101-1 P145-8	Gray, Non-Fibrous, Homogenous	Cinder Block Mortar - 6th Floor	0%	100%	NAD
1209-RAY-101-2 P145-9	Gray, Non-Fibrous, Homogenous	Cinder Block Mortar - 5th Floor	0%	100%	NAD
1209-RAY-200B-1 P145-10	White, Non-Fibrous, Homogenous	Celling Joint Comp - 8th Floor Kitchen	0%	100%	NAD
1209-RAY-200B-2 P145-11	White, Non-Fibrous, Homogenous	Celling Joint Comp - 1st Floor	0%	100%	NAD
1209-RAY-201-1 P145-12	Gray, Fibrous, Homogenous	1x1 Spline Dot & Fissure - 6th Floor	80%	20%	NAD
1209-RAY-201-2 P145-13	Gray, Fibrous, Homogenous	1x1 Spline Dot & Fissure - 6th Floor	75%	25%	NAD

Tracy Skalski  
Analyst(s)

Approved Signatory

Disclaimers: NAD = No asbestos detected. Results relate only to samples provided by client. This report shall not be reproduced, except in full, without written approval by Sienna. Samples analyzed as NAD or Trace (<1%) cannot be guaranteed. Quantitative transmission electron microscopy is currently the only reliable method that can be used to determine if this material can be considered or treated as non-asbestos containing. Analysis performed by Sienna Environmental Technologies, NY ELAP #11727.



# SIENNA ENVIRONMENTAL TECHNOLOGIES, LLC

429 Franklin St. · Suite 102 · Buffalo, NY 14202 · Ph: 716-332-3134 · Fax: 716-332-3136

## LABORATORY REPORT

Attn: Jeffrey Robbins  
C & S Engineers  
499 Col. Eileen Collins Blvd  
Syracuse, NY 13212

Date Received: 12/12/2008

Date Analyzed: 12/18/2008

Sienna ID: P145

Phone: 315-455-2000 Fax: 315-455-9667

Project: SET954 Raymond Hall

### Polarized Light Microscopy (PLM) by NY State ELAP Method 198.1

Sample	Description	Location	% Fibrous	% Non-Fibrous	% Asbestos Type
1209-RAY-202-1 P145-14	Gray, Fibrous, Homogenous	2x2 Dot & Texture CT - 6th Floor	30%	70%	NAD
1209-RAY-202-2 P145-15	Gray, Fibrous, Homogenous	2x2 Dot & Texture CT - 6th Floor	30%	70%	NAD

Tracy Skalski  
Analyst(s)

Approved Signatory

Disclaimers: NAD = No asbestos detected. Results relate only to samples provided by client. This report shall not be reproduced, except in full, without written approval by Sienna. Samples analyzed as NAD or Trace (<1%) cannot be guaranteed. Quantitative transmission electron microscopy is currently the only reliable method that can be used to determine if this material can be considered or treated as non-asbestos containing. Analysis performed by Sienna Environmental Technologies, NY ELAP #11727.

# SIENNA ENVIRONMENTAL TECHNOLOGIES, LLC

429 Franklin Street, Suite 102  
Buffalo, NY 14202

Phone 716-332-3134  
Fax 716-332-3136

## Chain of Custody Document

Fax Report to: \_\_\_\_\_

Client/Contact: <u>C/S Engineers</u> <u>Jeffrey Robbins</u>	Turn around (circle) RUSH 48 Hour 24 Hour 72 Hour
Building/Location: <u>RAYMOND HALL</u>	
Job #: <u>SET054</u> Total # Samples: <u>15</u>	

PLM     TEM     AAS     OTHER

Sample #	Description of Sample	Location of Sample	Notes
1209-RAY-100A-1	Dry wall	8th floor	1
1209-RAY-100A-2	Dry wall	7th floor	2
1209-RAY-100B-1	Joint compound	8th floor	3
1209-RAY-100B-2	Joint compound	7th floor	4
1209-RAY-100B-3	Joint compound	5th floor	5
1209-RAY-100B-4	Joint compound	4th floor	6
1209-RAY-100B-5	Joint compound	2nd floor	7
1209-RAY-101-1	Cinder block mortar	6th floor	8
1209-RAY-101-2	Cinder block mortar	5th floor	9
1209-RAY-200B-1	ceiling joint comp.	8th floor kitchen	10
1209-RAY-200B-2	ceiling joint comp.	1st floor	11
1209-RAY-201-1	1'x1' spline dot & fissure	6th floor	12
1209-RAY-201-2	1'x1' spline dot & fissure	6th floor	13
1209-RAY-202-1	2'x2' dot & Texture CT	6th floor	14
1209-RAY-202-2	2'x2' dot & Texture CT	6th floor	15

Notes: \_\_\_\_\_

Sienna Environmental  
Technologies  
 Accept  
 Reject

Sampled By: Paul J. Mainz Date: 12/9/08

Relinquished By: Paul J. Mainz Date: 12/10/08

Received By: [Signature] Date: 12/12/08

PJMS

P145



# SIENNA ENVIRONMENTAL TECHNOLOGIES, LLC

429 Franklin St. · Suite 102 · Buffalo, NY 14202 · Ph: 716-332-3134 · Fax: 716-332-3136

## LABORATORY REPORT

Attn: Jeffrey Robbins  
C & S Engineers  
499 Col. Eileen Collins Blvd  
Syracuse, NY 13212  
Phone: 315-455-2000 Fax: 315-455-9667  
Project: SET954 SUNY Potsdam Morey Hall

Date Received: 12/12/2008  
Date Analyzed: 12/18/2008  
Sienna ID: P144

### Polarized Light Microscopy (PLM) by NY State ELAP Method 198.1

Sample	Description	Location	% Fibrous	% Non-Fibrous	% Asbestos Type
1210-MOR-100A-1 P144-1	Tan, Non-Fibrous, Homogenous	Sand Finish Plaster Skim Coat - 2nd Floor Hall	0%	100%	NAD
1210-MOR-100A-2 P144-2	Tan, Non-Fibrous, Homogenous	Sand Finish Plaster Skim Coat - 2nd Floor Hall	0%	100%	NAD
1210-MOR-100A-3 P144-3	Tan, Non-Fibrous, Homogenous	Sand Finish Plaster Skim Coat - 1st Floor Hall	0%	100%	NAD
1210-MOR-200A-1 P144-4	Tan, Non-Fibrous, Homogenous	Sand Finish Plaster Skim Coat - Room 202	5%	95%	NAD
1210-MOR-200A-2 P144-5	Tan, Non-Fibrous, Homogenous	Sand Finish Plaster Skim Coat - Room 224	0%	100%	NAD
1210-MOR-100B-1 P144-6	Gray, Non-Fibrous, Homogenous	Sand Finish Plaster Base Coat - 2nd Floor Hall	0%	100%	NAD
1210-MOR-100B-2 P144-7	Gray, Non-Fibrous, Homogenous	Sand Finish Plaster Base Coat - 2nd Floor Hall	0%	100%	NAD
1210-MOR-100B-3 P144-8	Gray, Non-Fibrous, Homogenous	Sand Finish Plaster Base Coat - 1st Floor Hall	0%	100%	NAD
1210-MOR-200B-1 P144-9	Gray, Non-Fibrous, Homogenous	Sand Finish Plaster Base Coat - Room 202	0%	100%	NAD

Julia McKenzie, Tracy Skalski  
Analyst(s)

Approved Signatory

Disclaimers: NAD = No asbestos detected. Results relate only to samples provided by client. This report shall not be reproduced, except in full, without written approval by Sienna. Samples analyzed as NAD or Trace (<1%) cannot be guaranteed. Quantitative transmission electron microscopy is currently the only reliable method that can be used to determine if this material can be considered or treated as non-asbestos containing. Analysis performed by Sienna Environmental Technologies, NY ELAP #11727.



**LABORATORY REPORT**

Attn: Jeffrey Robbins  
 C & S Engineers  
 499 Col. Eileen Collins Blvd  
 Syracuse, NY 13212  
 Phone: 315-455-2000 Fax: 315-455-9667  
 Project: SET954 SUNY Potsdam Morey Hall

Date Received: 12/12/2008  
 Date Analyzed: 12/18/2008  
 Sienna ID: P144

**Polarized Light Microscopy (PLM)  
 by NY State ELAP Method 198.1**

Sample	Description	Location	% Fibrous	% Non-Fibrous	% Asbestos Type
1210-MOR-200B-2 P144-10	Gray, Non-Fibrous, Homogenous	Sand Finish Plaster Base Coat - Room 224	0%	100%	NAD
1210-MOR-101A-1 P144-11	White, Non-Fibrous, Homogenous	Smooth Plaster Skim Coat - Room 202	0%	100%	NAD
1210-MOR-101A-2 P144-12	White, Non-Fibrous, Homogenous	Smooth Plaster Skim Coat - 1st Floor Mens Room	0%	100%	NAD
1210-MOR-202A-1 P144-13	White, Non-Fibrous, Homogenous	Smooth Plaster Skim Coat - 1st Floor Ladies Room	0%	100%	NAD
1210-MOR-101B-1 P144-14	Gray, Non-Fibrous, Homogenous	Smooth Plaster Base Coat - Room 202	5%	95%	NAD
1210-MOR-101B-2 P144-15	Gray, Non-Fibrous, Homogenous	Smooth Plaster Base Coat - 1st Floor Mens Room	0%	100%	NAD
1210-MOR-202B-1 P144-16	Gray, Non-Fibrous, Homogenous	Smooth Plaster Base Coat - 1st Floor Ladies Room	0%	100%	NAD
1210-MOR-102A-1 P144-17	White, Fibrous, Non-Homogenous	Drywall - Room 253	5%	95%	NAD
1210-MOR-201A-1 P144-18	Gray, Fibrous, Non-Homogenous	Drywall - Room 253	10%	90%	NAD

Julia McKenzie, Tracy Skalski  
 Analyst(s)

Approved Signatory

Disclaimers: NAD = No asbestos detected. Results relate only to samples provided by client. This report shall not be reproduced, except in full, without written approval by Sienna. Samples analyzed as NAD or Trace (<1%) cannot be guaranteed. Quantitative transmission electron microscopy is currently the only reliable method that can be used to determine if this material can be considered or treated as non-asbestos containing. Analysis performed by Sienna Environmental Technologies, NY ELAP #11727.





# SIENNA ENVIRONMENTAL TECHNOLOGIES, LLC

429 Franklin St. · Suite 102 · Buffalo, NY 14202 · Ph: 716-332-3134 · Fax: 716-332-3136

## LABORATORY REPORT

Attn: Jeffrey Robbins  
C & S Engineers  
499 Col. Eileen Collins Blvd  
Syracuse, NY 13212  
Phone: 315-455-2000 Fax: 315-455-9667  
Project: SET954 SUNY Potsdam **Morey Hall**

Date Received: 12/12/2008  
Date Analyzed: 12/18/2008  
Sienna ID: P144

### Polarized Light Microscopy (PLM) by NY State ELAP Method 198.1

Sample	Description	Location	% Fibrous	% Non-Fibrous	% Asbestos Type
1210-MOR-102B-1 P144-19	Tan, Non-Fibrous, Homogenous	Joint Compound - Room 253	0%	100%	NAD
1210-MOR-102B-2 P144-20	Tan, Non-Fibrous, Homogenous	Joint Compound - 1st Floor Hall	5%	95%	NAD
1210-MOR-201B-1 P144-21	Tan, Non-Fibrous, Homogenous	Joint Compound - Room 253	5%	95%	NAD
1210-MOR-201B-2 P144-22	Tan, Non-Fibrous, Homogenous	Joint Compound - Room 253	5%	95%	Trace Chrysotile

Julia McKenzie, Tracy Skalski  
Analyst(s)

Approved Signatory

Disclaimers: NAD = No asbestos detected. Results relate only to samples provided by client. This report shall not be reproduced, except in full, without written approval by Sienna. Samples analyzed as NAD or Trace (<1%) cannot be guaranteed. Quantitative transmission electron microscopy is currently the only reliable method that can be used to determine if this material can be considered or treated as non-asbestos containing. Analysis performed by Sienna Environmental Technologies, NY ELAP #11727.

# SIENNA ENVIRONMENTAL TECHNOLOGIES, LLC

429 Franklin Street, Suite 102  
Buffalo, NY 14202

Phone 716-332-3134  
Fax 716-332-3136

## Chain of Custody Document

Fax Report to: \_\_\_\_\_

Client/Contact: <u>C&amp;S Engineers / Jeffrey Robbins</u>	Turn around (circle) RUSH 48 Hour 24 Hour 72 Hour
Building/Location: <u>Morey Hall, SUNY Potsdam</u>	
Job #: <u>SET954</u> Total # Samples: <u>22</u>	

PLM     TEM     AAS     OTHER

Sample #	Description of Sample	Location of Sample	Notes
1210-MOR-100A-1	Sand finish plaster skim coat	2nd floor hall	P144-1
1210-MOR-100A-2	Sand finish plaster skim coat	2nd floor hall	-2
1210-MOR-100A-3	Sand finish plaster skim coat	1st floor hall	-3
1210-MOR-200A-1	Sand finish plaster skim coat	Room 202	-4
1210-MOR-200A-2	Sand finish plaster skim coat	Room 224	-5
1210-MOR-100B-1	Sand finish plaster base coat	2nd floor hall	-6
1210-MOR-100B-2	Sand finish plaster base coat	2nd floor hall	-7
1210-MOR-100B-3	Sand finish plaster base coat	1st floor hall	-8
1210-MOR-200B-1	Sand finish plaster base coat	Room 202	-9
1210-MOR-200B-2	Sand finish plaster base coat	Room 224	-10
1210-MOR-101A-1	Smooth plaster skim coat	Room 202	-11
1210-MOR-101A-2	Smooth plaster skim coat	1st floor men's room	-12
1210-MOR-202A-1	Smooth plaster skim coat	1st floor ladie's room	-13
1210-MOR-101B-1	Smooth plaster base coat	Room 202	-14
1210-MOR-101B-2	Smooth plaster base coat	1st floor men's room	-15
1210-MOR-202B-1	Smooth plaster base coat	1st floor ladie's room	-16

Sienna Environmental Technologies

Notes: Page 1 of 2

Accept  
 Reject

Sampled By: Paul J. Mairy Date: 12/10/08  
 Relinquished By: Paul J. Mairy Date: 12/10/08  
 Received By: Cheryl Stasicki 1445 P144 Date: 12/12/08

# SIENNA ENVIRONMENTAL TECHNOLOGIES, LLC

429 Franklin Street, Suite 102  
Buffalo, NY 14202

Phone 716-332-3134  
Fax 716-332-3136

## Chain of Custody Document

Fax Report to: \_\_\_\_\_

Client/Contact: <u>C &amp; S Engineers / Jeffrey Robbins</u>	Turn around (circle)  RUSH    48 Hour  24 Hour   72 Hour
Building/Location: <u>Morey Hall, SUNY Potsdam</u>	
Job #: <u>SET 954</u> Total # Samples: <u>28</u>	

PLM     TEM     AAS     OTHER \_\_\_\_\_

Sample #	Description of Sample	Location of Sample	Notes
1210-MOR-102A-1	Drywall	Room 253	P144-17
1210-MOR-201A-1	Drywall	Room 253	1-18
1210-MOR-102B-1	Joint compound	Room 253	-19
1210-MOR-102B-2	Joint compound	<del>Room 253</del> 1st floor hall	-20
1210-MOR-202B-1	Joint compound	Room 253	P144-21
1210-MOR-201B-2	Joint Compound	Room 253	P144-22

Sienna Environmental Technologies  
 Accept  
 Reject

Notes: Page 2 of 2

Sampled By: Paul J. Maury    Date: 12/10/08  
 Relinquished By: Paul J. Maury    Date: 12/10/08  
 Received By: Francis Stasi 1945 P144    Date: 12/12/08



# SIENNA ENVIRONMENTAL TECHNOLOGIES, LLC

429 Franklin St. · Suite 102 · Buffalo, NY 14202 · Ph: 716-332-3134 · Fax: 716-332-3136

## LABORATORY REPORT

Attn: Jeffrey Robbins  
C & S Engineers  
499 Col. Eileen Collins Blvd  
Syracuse, NY 13212  
Phone: 315-455-2000 Fax: 315-455-9667  
Project: SET954 SUNY Potsdam Mac Vicar Hall

Date Received: 12/12/2008  
Date Analyzed: 12/17/2008  
Sienna ID: P143

### Polarized Light Microscopy (PLM) by NY State ELAP Method 198.1

Sample	Description	Location	% Fibrous	% Non-Fibrous	% Asbestos Type
1210-MCV-100A-1 P143-1	Tan, Non-Fibrous, Homogenous	Sand Finish Plaster Skim Coat - 1st Floor Hall	0%	100%	NAD
1210-MCV-100A-2 P143-2	Tan, Non-Fibrous, Homogenous	Sand Finish Plaster Skim Coat - Room 120	0%	100%	NAD
1210-MCV-100A-3 P143-3	Tan, Non-Fibrous, Homogenous	Sand Finish Plaster Skim Coat - Room 203	0%	100%	NAD
1210-MCV-200A-1 P143-4	Tan, Non-Fibrous, Homogenous	Sand Finish Plaster Skim Coat - Room 121	5%	95%	NAD
1210-MCV-200A-2 P143-5	Tan, Non-Fibrous, Homogenous	Sand Finish Plaster Skim Coat - Room 226	5%	95%	NAD
1210-MCV-100B-1 P143-6	Gray, Non-Fibrous, Homogenous	Sand Finish Plaster Base Coat - 1st Floor Hall	0%	100%	NAD
1210-MCV-100B-2 P143-7	Gray, Non-Fibrous, Homogenous	Sand Finish Plaster Base Coat - Room 120	5%	95%	NAD
1210-MCV-100B-3 P143-8	Gray, Non-Fibrous, Homogenous	Sand Finish Plaster Base Coat - Room 203	0%	100%	NAD
1210-MCV-200B-1 P143-9	Gray, Non-Fibrous, Homogenous	Sand Finish Plaster Base Coat - Room 121	0%	100%	NAD
1210-MCV-200B-2 P143-10	Gray, Non-Fibrous, Homogenous	Sand Finish Plaster Base Coat - Room 226	0%	100%	NAD
1210-MCV-201A-1 P143-11	White, Non-Fibrous, Homogenous	Smooth Plaster Skim Coat - 2nd Floor Mens Room	0%	100%	NAD
1210-MCV-201A-2 P143-12	White, Non-Fibrous, Homogenous	Smooth Plaster Skim Coat - 2nd Floor Mens Room	0%	100%	NAD
1210-MCV-201A-3 P143-13	White, Non-Fibrous, Homogenous	Smooth Plaster Skim Coat - 1st Floor Mens Room	0%	100%	NAD

Tracy Skalski  
Analyst(s)

Approved Signatory

Disclaimers: NAD = No asbestos detected. Results relate only to samples provided by client. This report shall not be reproduced, except in full, without written approval by Sienna. Samples analyzed as NAD or Trace (<1%) cannot be guaranteed. Quantitative transmission electron microscopy is currently the only reliable method that can be used to determine if this material can be considered or treated as non-asbestos containing. Analysis performed by Sienna Environmental Technologies, NY ELAP #11727.



# SIENNA ENVIRONMENTAL TECHNOLOGIES, LLC

429 Franklin St. · Suite 102 · Buffalo, NY 14202 · Ph: 716-332-3134 · Fax: 716-332-3136

## LABORATORY REPORT

Attn: Jeffrey Robbins  
 C & S Engineers  
 499 Col. Eileen Collins Blvd  
 Syracuse, NY 13212

Date Received: 12/12/2008  
 Date Analyzed: 12/17/2008  
 Sienna ID: P143

Phone: 315-455-2000 Fax: 315-455-9667

Project: SET954 SUNY Potsdam Mac Vicar Hall

### Polarized Light Microscopy (PLM) by NY State ELAP Method 198.1

Sample	Description	Location	% Fibrous	% Non-Fibrous	% Asbestos Type
1210-MCV-201B-1 P143-14	Gray, Non-Fibrous, Homogenous	Smooth Plaster Base Coat - 2nd Floor Mens Room	0%	100%	NAD
1210-MCV-201B-2 P143-15	Gray, Non-Fibrous, Homogenous	Smooth Plaster Base Coat - 2nd Floor Mens Room	0%	100%	NAD
1210-MCV-201B-3 P143-16	Gray, Non-Fibrous, Homogenous	Smooth Plaster Base Coat - 1st Floor Mens Room	0%	100%	NAD

Tracy Skalski  
 Analyst(s)



Approved Signatory

Disclaimers: NAD = No asbestos detected. Results relate only to samples provided by client. This report shall not be reproduced, except in full, without written approval by Sienna. Samples analyzed as NAD or Trace (<1%) cannot be guaranteed. Quantitative transmission electron microscopy is currently the only reliable method that can be used to determine if this material can be considered or treated as non-asbestos containing. Analysis performed by Sienna Environmental Technologies, NY ELAP #11727.

# SIENNA ENVIRONMENTAL TECHNOLOGIES, LLC

429 Franklin Street, Suite 102  
Buffalo, NY 14202

Phone 716-332-3134  
Fax 716-332-3136

## Chain of Custody Document

Fax Report to: \_\_\_\_\_

Client/Contact: <u>C &amp; S Engineers / Jeffrey Robbins</u>	Turn around (circle)  RUSH 48 Hour  24 Hour 72 Hour
Building/Location: <u>Mac Vicar Hall, SUNY Potsdam</u>	
Job #: <u>SET954</u> Total # Samples: <u>16</u>	

PLM     TEM     AAS     OTHER

Sample #	Description of Sample	Location of Sample	Notes
1210-MCV-100A-1	Sand finish plaster skim coat	1st floor hall	P143-1
1210-MCV-100A-2	Sand finish plaster skim coat	Room 120	-2
1210-MCV-100A-3	Sand finish plaster skim coat	Room 203	-3
1210-MCV-200A-1	Sand finish plaster skim coat	Room 121	-4
1210-MCV-200A-2	Sand finish plaster skim coat	Room 226	-5
1210-MCV-100B-1	Sand finish plaster base coat	1st floor hall	-6
1210-MCV-100B-2	Sand finish plaster base coat	Room 120	-7
1210-MCV-100B-3	Sand finish plaster base coat	Room 203	-8
1210-MCV-200B-1	Sand finish plaster base coat	Room 121	-9
1210-MCV-200B-2	Sand finish plaster base coat	Room 226	-10
1210-MCV-201A-1	Smooth plaster skim coat	2nd floor men's room	-11
1210-MCV-201A-2	Smooth plaster skim coat	2nd floor men's room	-12
1210-MCV-201A-3	Smooth plaster skim coat	1st floor men's room	-13
1210-MCV-201B-1	Smooth plaster base coat	2nd floor men's room	-14
1210-MCV-201B-2	Smooth plaster base coat	2nd floor men's room	-15
1210-MCV-201B-3	Smooth plaster base coat	1st floor men's room	P143-16

Notes: <u>Page 1 of 1</u>	Sienna Environmental Technologies <input checked="" type="checkbox"/> Accept <input type="checkbox"/> Reject
---------------------------	--

Sampled By: Paul J. Mawry Date: 12/10/08  
 Relinquished By: Paul J. Mawry Date: 12/10/08  
 Received By: Angela Storti 1445 P143 Date: 12/12/08



# SIENNA ENVIRONMENTAL TECHNOLOGIES, LLC

429 Franklin St. · Suite 102 · Buffalo, NY 14202 · Ph: 716-332-3134 · Fax: 716-332-3136

## LABORATORY REPORT

Attn: Jeffrey Robbins  
C & S Engineers  
499 Col. Eileen Collins Blvd  
Syracuse, NY 13212

Date Received: 12/12/2008

Date Analyzed: 12/22/2008

Sienna ID: P146

Phone: 315-455-2000


Fax: 315-455-9667

Project: SET954 Stillman Hall

### Polarized Light Microscopy (PLM) by NY State ELAP Method 198.1

Sample	Description	Location	% Fibrous	% Non-Fibrous	% Asbestos Type
1210-STL-100A-1 P146-1	Gray, Fibrous, Non-Homogenous	Drywall - Room 105	30%	70%	NAD
1210-STL-200A-1 P146-2	Gray, Fibrous, Non-Homogenous	Drywall - 1st Floor Hall	0%	100%	NAD
1210-STL-100B-1 P146-3	Tan, Fibrous, Homogenous	Joint Compound - Room 105	0%	100%	NAD
1210-STL-100B-2 P146-4	Tan, Non-Fibrous, Homogenous	Joint Compound - 1st Floor Hall	0%	100%	NAD
1210-STL-100B-3 P146-5	Tan, Non-Fibrous, Homogenous	Joint Compound - 2nd Floor Hall	0%	100%	NAD
1210-STL-200B-1 P146-6	Tan, Fibrous, Homogenous	Joint Compound - 1st Floor Hall	0%	100%	NAD
1210-STL-200B-2 P146-7	Tan, Fibrous, Homogenous	Joint Compound - 2nd Floor Hall	0%	100%	NAD
1210-STL-201-1 P146-8	Gray, Fibrous, Homogenous	2x2 Dot and Large Fissure Ceiling Tile - Room 105	70%	30%	NAD
1210-STL-201-2 P146-9	Gray, Fibrous, Homogenous	2x2 Dot and Large Fissure Ceiling Tile - Room 105	60%	40%	NAD

Tracy Skalski  
Analyst(s)

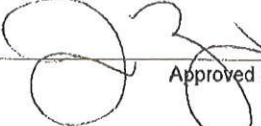  
Approved Signatory

Disclaimers: NAD = No asbestos detected. Results relate only to samples provided by client. This report shall not be reproduced, except in full, without written approval by Sienna. Samples analyzed as NAD or Trace (<1%) cannot be guaranteed. Quantitative transmission electron microscopy is currently the only reliable method that can be used to determine if this material can be considered or treated as non-asbestos containing. Analysis performed by Sienna Environmental Technologies, NY ELAP #11727.

# SIENNA ENVIRONMENTAL TECHNOLOGIES, LLC

429 Franklin Street, Suite 102  
Buffalo, NY 14202

Phone 716-332-3134  
Fax 716-332-3136

## Chain of Custody Document

Fax Report to: \_\_\_\_\_

Client/Contact: <u>C &amp; S Engineers, Jeffrey Robbins</u>	Turn around (circle) RUSH 48 Hour 24 Hour 72 Hour
Building/Location: <u>Stillman Hall, SUNY Potsdam</u>	
Job #: <u>SET954</u> Total # Samples: <u>9</u>	

PLM     TEM     AAS     OTHER

Sample #	Description of Sample	Location of Sample	Notes <span style="float: right;">P146</span>
1210-STL-100A-1	Drywall	Room 105	1
1210-STL-200A-1	Drywall	1st floor hall	2
1210-STL-100B-1	Joint compound	Room 105	3
1210-STL-100B-2	Joint compound	1st floor hall	4
1210-STL-100B-3	Joint compound	2nd floor hall	5
1210-STL-200B-1	Joint compound	1st floor hall	6
1210-STL-200B-2	Joint compound	2nd floor hall	7
1210-STL-201-1	2x2 Dot and large fissure CT	Room 105	8
1210-STL-201-2	2x2 Dot and large fissure CT	Room 105	9

Notes: 1 of 1

Sienna Environmental Technologies  
 Accept  
 Reject

Sampled By: Paul J. Mawry Date: 12/10/08  
 Relinquished By: Paul J. Mawry Date: 12/10/08  
 Received By: [Signature] Date: 12/12/08 P146





# SIENNA ENVIRONMENTAL TECHNOLOGIES, LLC

429 Franklin St. · Suite 102 · Buffalo, NY 14202 · Ph: 716-332-3134 · Fax: 716-332-3136

## LABORATORY REPORT

Attn: Jeffrey Robbins  
C & S Engineers  
499 Col. Eileen Collins Blvd  
Syracuse, NY 13212

Date Received: 12/12/2008

Date Analyzed: 12/16/2008

Sienna ID: P141

Phone: 315-455-2000

Fax: 315-455-9667

Project: SET954 Flagg Hall

### Polarized Light Microscopy (PLM) by NY State ELAP Method 198.1

Sample	Description	Location	% Fibrous	% Non-Fibrous	% Asbestos Type
1210-FLG-100-1 P141-1	Gray, Non-Fibrous, Homogenous	Cinder Block Mortar - Basement Hall	0%	100%	NAD
1210-FLG-100-2 P141-2	Gray, Non-Fibrous, Homogenous	Cinder Block Mortar - Basement Hall	0%	100%	NAD
1210-FLG-101A-1 P141-3	Gray, Non-Fibrous, Homogenous	Skim Coat Plaster - 1st Floor Hall	0%	100%	NAD
1210-FLG-101A-2 P141-4	Gray, Non-Fibrous, Homogenous	Skim Coat Plaster - Room 114	0%	100%	NAD
1210-FLG-101A-3 P141-5	Gray, Non-Fibrous, Homogenous	Skim Coat Plaster - Room 206	5%	95%	NAD
1210-FLG-101B-1 P141-6	Gray, Non-Fibrous, Homogenous	Base Coat Plaster - Room 114	0%	100%	NAD
1210-FLG-101B-2 P141-7	Gray, Non-Fibrous, Homogenous	Base Coat Plaster - 1st Floor Hall	0%	100%	NAD
1210-FLG-101B-3 P141-8	Gray, Non-Fibrous, Homogenous	Base Coat Plaster - Room 206A	0%	100%	NAD
1210-FLG-102A-1 P141-9	Gray, Non-Fibrous, Homogenous	Drywall - 1st Floor Hall	0%	100%	NAD
1210-FLG-102A-2 P141-10	Gray, Fibrous, Non-Homogenous	Drywall - 1st Floor Hall	10%	90%	NAD
1210-FLG-102B-1 P141-11	White, Non-Fibrous, Homogenous	Joint Compound - 1st Floor Hall	0%	100%	NAD
1210-FLG-102B-2 P141-12	White, Non-Fibrous, Homogenous	Joint Compound - 1st Floor Hall	0%	100%	NAD
1210-FLG-102B-3 P141-13	White, Non-Fibrous, Homogenous	Joint Compound - 1st Floor Hall	0%	100%	NAD

Julia McKenzie, Tracy Skalski  
Analyst(s)

Approved Signatory

Disclaimers: NAD = No asbestos detected. Results relate only to samples provided by client. This report shall not be reproduced, except in full, without written approval by Sienna. Samples analyzed as NAD or Trace (<1%) cannot be guaranteed. Quantitative transmission electron microscopy is currently the only reliable method that can be used to determine if this material can be considered or treated as non-asbestos containing. Analysis performed by Sienna Environmental Technologies, NY ELAP #11727.



# SIENNA ENVIRONMENTAL TECHNOLOGIES, LLC

429 Franklin St. · Suite 102 · Buffalo, NY 14202 · Ph: 716-332-3134 · Fax: 716-332-3136

## LABORATORY REPORT

Attn: Jeffrey Robbins  
C & S Engineers  
499 Col. Eileen Collins Blvd  
Syracuse, NY 13212

Date Received: 12/12/2008

Date Analyzed: 12/16/2008

Sienna ID: P141

Phone: 315-455-2000

Fax: 315-455-9667

Project: SET954 Flagg Hall

### Polarized Light Microscopy (PLM) by NY State ELAP Method 198.1

Sample	Description	Location	% Fibrous	% Non-Fibrous	% Asbestos Type
1210-FLG-200-1 P141-14	Gray, Fibrous, Homogenous	2'x2' Dot and Texture Ceiling Tile - Room 164	30%	70%	NAD
1210-FLG-200-2 P141-15	Gray, Fibrous, Homogenous	2'x2' Dot and Texture Ceiling Tile - Room 164	40%	60%	NAD
1210-FLG-201A-1 P141-16	White, Non-Fibrous, Homogenous	Plaster Skim Coat - Room 114	5%	95%	NAD
1210-FLG-201A-2 P141-17	White, Non-Fibrous, Homogenous	Plaster Skim Coat - 2nd Floor Men's Room	0%	100%	NAD
1210-FLG-201B-1 P141-18	Gray, Non-Fibrous, Homogenous	Plaster Base Coat - Room 114	0%	100%	NAD
1210-FLG-201-B2 P141-19	Gray, Non-Fibrous, Homogenous	Plaster Base Coat - 2nd Floor Men's Room	0%	100%	NAD
1210-FLG-202-1 P141-20	White, Non-Fibrous, Homogenous	Textured Popcorn Ceiling - 1st Floor Entryway	0%	100%	NAD
1210-FLG-202-2 P141-21	Gray, Non-Fibrous, Homogenous	Popcorn Ceiling - 1st Floor Entryway	0%	100%	NAD
1210-FLG-202-3 P141-22	Gray, Non-Fibrous, Homogenous	Popcorn Ceiling - 1st Floor Entryway	10%	90%	NAD
1210-FLG-300-1 P141-23	Brown, Non-Fibrous, Homogenous	Brick Floor Mortar - 1st Floor Entryway	0%	100%	NAD
1210-FLG-300-2 P141-24	Brown, Non-Fibrous, Homogenous	Brick Floor Mortar - 1st Floor Entryway	0%	100%	NAD
1210-FLG-400A-1 P141-25	Yellow, Fibrous, Homogenous	Cloth on Mud Fitting - Basement	10%	90%	NAD
1210-FLG-400A-2 P141-26	Tan, Fibrous, Homogenous	Cloth on Mud Fitting - Basement	70%	30%	NAD

Julia McKenzie, Tracy Skalski  
Analyst(s)

Approved Signatory

Disclaimers: NAD = No asbestos detected. Results relate only to samples provided by client. This report shall not be reproduced, except in full, without written approval by Sienna. Samples analyzed as NAD or Trace (<1%) cannot be guaranteed. Quantitative transmission electron microscopy is currently the only reliable method that can be used to determine if this material can be considered or treated as non-asbestos containing. Analysis performed by Sienna Environmental Technologies, NY ELAP #11727.



**LABORATORY REPORT**

Attn: Jeffrey Robbins  
 C & S Engineers  
 499 Col. Eileen Collins Blvd  
 Syracuse, NY 13212

Date Received: 12/12/2008  
 Date Analyzed: 12/16/2008  
 Sienna ID: P141

Phone: 315-455-2000 Fax: 315-455-9667

Project: SET954 Flagg Hall

**Polarized Light Microscopy (PLM)  
 by NY State ELAP Method 198.1**

Sample	Description	Location	% Fibrous	% Non-Fibrous	% Asbestos Type
1210-FLG-400A-3 P141-27	Yellow, Fibrous, Homogenous	Cloth on Mud Fitting - Basement *Insufficient Sample Size*	10%	90%	NAD
1210-FLG-400B-1 P141-28	Gray, Fibrous, Homogenous	Mud Fitting - Basement	10%	90%	NAD
1210-FLG-400B-2 P141-29	Gray, Fibrous, Homogenous	Mud Fitting - Basement	15%	85%	NAD
1210-FLG-400B-3 P141-30	Gray, Fibrous, Homogenous	Mud Fitting - Basement	20%	80%	NAD
1210-FLG-600-1 P141-31	Black, Fibrous, Homogenous	Vibration Dampener - Basement	30%	70%	NAD
1210-FLG-600-2 P141-32	Black, Fibrous, Homogenous	Vibration Dampener - Basement	15%	85%	NAD

Julia McKenzie, Tracy Skalski  
 Analyst(s)

Approved Signatory

Disclaimers: NAD = No asbestos detected. Results relate only to samples provided by client. This report shall not be reproduced, except in full, without written approval by Sienna. Samples analyzed as NAD or Trace (<1%) cannot be guaranteed. Quantitative transmission electron microscopy is currently the only reliable method that can be used to determine if this material can be considered or treated as non-asbestos containing. Analysis performed by Sienna Environmental Technologies, NY ELAP #11727.

# SIENNA ENVIRONMENTAL TECHNOLOGIES, LLC

429 Franklin Street, Suite 102  
Buffalo, NY 14202

Phone 716-332-3134  
Fax 716-332-3136

## Chain of Custody Document

Fax Report to: \_\_\_\_\_

Client/Contact: <u>CSS Engineers</u> <u>Jeffrey Robbins</u>	Turn around (circle)  RUSH 48 Hour  24 Hour 72 Hour
Building/Location: <u>FLAGG HALL</u>	
Job #: <u>SET954</u> Total # Samples: <u>32</u>	

PLM     TEM     AAS     OTHER

Sample #	Description of Sample	Location of Sample	Notes
1210-FLG-100-1	Cinder block mortar	Basement Hall	P141-1
1210-FLG-100-2	Cinder block mortar	Basement Hall	1-2
1210-FLG-101A-1	Skim coat plaster	1st Floor Hall	-3
1210-FLG-101A-2	Skim coat plaster	Rm 114	-4
1210-FLG-101A-3	Skim coat plaster	Rm 206	-5
1210-FLG-101B-1	Base coat plaster	Rm 114	-6
1210-FLG-101B-2	Base coat plaster	1st Floor Hall	-7
1210-FLG-101B-3	Base coat plaster	Rm 206A	-8
1210-FLG-102A-1	Dry wall	1st Floor Hall	-9
1210-FLG-102A-2	Dry wall	1st Floor Hall	-10
1210-FLG-102B-1	Joint compound	1st Floor Hall	-11
1210-FLG-102B-2	Joint compound	1st Floor Hall	-12
1210-FLG-102B-3	Joint compound	1st Floor Hall	-13
1210-FLG-200-1	2'x2' Dot & Texture CT	Rm 1104	-14
1210-FLG-200-2	2'x2' Dot & Texture CT	Rm 1164	-15
1210-FLG-201A-1	Plaster skim coat	Rm 114	P141-16

Sienna Environmental  
Technologies  
 Accept  
 Reject

Notes: PS 1 of 2

Sampled By: Paul J. Manis Date: 12/10/08  
 Relinquished By: Paul J. Manis Date: 12/10/08  
 Received By: Paul J. Manis Date: 12/12/08  
 P141  
1445

# SIENNA ENVIRONMENTAL TECHNOLOGIES, LLC

429 Franklin Street, Suite 102  
Buffalo, NY 14202

Phone 716-332-3134  
Fax 716-332-3136

## Chain of Custody Document

Fax Report to: \_\_\_\_\_

Client/Contact: <u>C &amp; S Engineers</u> <u>Jeffrey Robbins</u>	Turn around (circle)  RUSH 48 Hour  24 Hour 72 Hour
Building/Location: <u>FLAGG HALL</u>	
Job #: <u>SET954</u> Total # Samples: <u>32</u>	

PLM     TEM     AAS     OTHER

Sample #	Description of Sample	Location of Sample	Notes
1210-FLG-201A-2	Plaster skim coat	2nd fl. men's Room	P141-17
1210-FLG-201B-1	Plaster base coat	Rm 114	-18
1210-FLG-201B-2	plaster base coat	2nd fl. men's room	-19
1210-FLG-202-1	Textured popcorn c/g.	1st floor entryway	-20
1210-FLG-202-2	popcorn ceiling	1st floor entryway	-21
1210-FLG-202-3	popcorn ceiling	1st floor entryway	-22
1210-FLG-300-1	Brick floor mortar	1st floor entryway	-23
1210-FLG-300-2	Brick floor mortar	1st floor entryway	-24
1210-FLG-400A-1	cloth on mud fitting	Basement	-25
1210-FLG-400A-2	cloth on mud fitting	Basement	-26
1210-FLG-400A-3	cloth on mud fitting	Basement	-27
1210-FLG-400B-1	mud fitting	Basement	-28
1210-FLG-400B-2	mud fitting	Basement	-29
1210-FLG-400B-3	mud fitting	Basement	-30
1210-FLG-600-1	vibration dampener	Basement	-31
1210-FLG-600-2	vibration dampener	Basement	P141-32

Notes: PS 2 of 2

Sienna Environmental Technologies  
 Accept  
 Reject

Sampled By: Paul J. Mainz Date: 12/10/08  
 Relinquished By: Paul J. Mainz Date: 12/10/08  
 Received By: James J. Steel Date: 12/12/08  
P141  
1445



# SIENNA ENVIRONMENTAL TECHNOLOGIES, LLC

429 Franklin St. · Suite 102 · Buffalo, NY 14202 · Ph: 716-332-3134 · Fax: 716-332-3136

## LABORATORY REPORT

Attn: Jeffrey Robbins  
C & S Engineers  
499 Col. Eileen Collins Blvd  
Syracuse, NY 13212

Phone: 315-455-2000 Fax: 315-455-9867

Project: SET954 Carson Hall

Date Received: 12/12/2008

Date Analyzed: 12/14/2008

Sienna ID: P140

### Polarized Light Microscopy (PLM) by NY State ELAP Method 198.1

Sample	Description	Location	% Fibrous	% Non-Fibrous	% Asbestos Type
1210-CAR-100A-1 P140-1	Gray, Fibrous, Non-Homogenous	Drywall - Rm 106	10%	90%	NAD
1210-CAR-100B-1 P140-2	White, Non-Fibrous, Homogenous	Joint Compound - Rm 106	0%	100%	NAD
1210-CAR-100B-2 P140-3	Tan, Non-Fibrous, Homogenous	Joint Compound - 2nd Floor Hall	0%	100%	NAD
1210-CAR-101-1 P140-4	Gray, Non-Fibrous, Homogenous	Cinder Block Mortar - Basement	0%	100%	NAD
1210-CAR-101-2 P140-5	Gray, Non-Fibrous, Homogenous	Cinder Block Mortar - Basement	0%	100%	NAD
1210-CAR-102A-1 P140-6	Tan, Non-Fibrous, Homogenous	Plaster Sklm Coat - 3rd Floor	0%	100%	NAD
1210-CAR-102A-2 P140-7	Tan, Non-Fibrous, Homogenous	Plaster Sklm Coat - 3rd Floor	0%	100%	NAD
1210-CAR-102A-3 P140-8	Tan, Non-Fibrous, Homogenous	Plaster Sklm Coat - 3rd Floor	0%	100%	NAD
1210-CAR-102B-1 P140-9	Gray, Non-Fibrous, Homogenous	Plaster Base Coat - 3rd Floor	0%	100%	NAD
1210-CAR-102B-2 P140-10	Gray, Non-Fibrous, Homogenous	Plaster Base Coat - 3rd Floor	0%	100%	NAD
1210-CAR-102B-3 P140-11	Gray, Non-Fibrous, Homogenous	Plaster Base Coat - 3rd Floor	0%	100%	NAD
1210-CAR-200A-1 P140-12	Gray, Fibrous, Non-Homogenous	Ceiling Drywall - 1st Floor Hall	10%	90%	NAD
1210-CAR-200B-1 P140-13	White, Non-Fibrous, Homogenous	Ceiling Joint Compound - 1st Floor Hall	5%	95%	0.26% Chrysotile

Julia McKenzie  
Analyst(s)

Approved Signatory

Disclaimers: NAD = No asbestos detected. Results relate only to samples provided by client. This report shall not be reproduced, except in full, without written approval by Sienna. Samples analyzed as NAD or Trace (<1%) cannot be guaranteed. Quantitative transmission electron microscopy is currently the only reliable method that can be used to determine if this material can be considered or treated as non-asbestos containing. Analysis performed by Sienna Environmental Technologies, NY ELAP #11727.



# SIENNA ENVIRONMENTAL TECHNOLOGIES, LLC

429 Franklin St. · Suite 102 · Buffalo, NY 14202 · Ph: 716-332-3134 · Fax: 716-332-3136

## LABORATORY REPORT

Attn: Jeffrey Robbins  
C & S Engineers  
499 Col. Eileen Collins Blvd  
Syracuse, NY 13212

Date Received: 12/12/2008

Date Analyzed: 12/14/2008

Sienna ID: P140

Phone: 315-455-2000 Fax: 315-455-9667

Project: SET954 Carson Hall

### Polarized Light Microscopy (PLM) by NY State ELAP Method 198.1

Sample	Description	Location	% Fibrous	% Non-Fibrous	% Asbestos Type
1210-CAR-201-1 P140-14	Gray, Fibrous, Homogenous	2x2 Large Fissure CT - Rm 106	70%	30%	NAD
1210-CAR-201-2 P140-15	Gray, Fibrous, Homogenous	2x2 Large Fissure CT - Rm 106	70%	30%	NAD
1210-CAR-202A-1 P140-16	Tan, Non-Fibrous, Homogenous	Text. Plaster Sklm - Rm 106	5%	95%	2.8% Chrysotile
1210-CAR-202A-2 P140-17	Tan, Non-Fibrous, Homogenous	Text. Plaster Sklm - 1st Floor Hall	5%	95%	3.1% Chrysotile
1210-CAR-202A-3 P140-18	Tan, Fibrous, Homogenous	Text. Plaster Sklm - Rm 204	5%	95%	3.9% Chrysotile
1210-CAR-202B-1 P140-19	Tan, Non-Fibrous, Homogenous	Text. Plaster Base - Rm 106	0%	100%	NAD
1210-CAR-202B-2 P140-20	Tan, Non-Fibrous, Homogenous	Text. Plaster Base - 1st Fl Hall	0%	100%	NAD
1210-CAR-202B-3 P140-21	Tan, Non-Fibrous, Homogenous	Text. Plaster Base - Rm 204	0%	100%	NAD

Julia McKenzie  
Analyst(s)

Approved Signatory

Disclaimers: NAD = No asbestos detected. Results relate only to samples provided by client. This report shall not be reproduced, except in full, without written approval by Sienna. Samples analyzed as NAD or Trace (<1%) cannot be guaranteed. Quantitative transmission electron microscopy is currently the only reliable method that can be used to determine if this material can be considered or treated as non-asbestos containing. Analysis performed by Sienna Environmental Technologies, NY ELAP #11727.

# SIENNA ENVIRONMENTAL TECHNOLOGIES, LLC

429 Franklin Street, Suite 102  
Buffalo, NY 14202

Phone 716-332-3134  
Fax 716-332-3136

## Chain of Custody Document

Fax Report to: \_\_\_\_\_

Client/Contact: <u>C/S Engineers</u> <u>Jeffrey Robbins</u>	Turn around (circle)  RUSH 48 Hour  24 Hour 72 Hour
Building/Location: <u>CARSON HALL</u>	
Job #: <u>SET954</u> Total # Samples: <u>21</u>	

PLM     TEM     AAS     OTHER

Sample #	Description of Sample	Location of Sample	Notes
1210-CAR-100A-1	Dry wall	Rm 106	P140-1
1210-CAR-100B-1	Joint compound	Rm 106	P140-2
1210-CAR-100B-2	Joint compound	2nd floor Hall	P140-3
1210-CAR-101-1	Cinder block mortar	Basement	P140-4
1210-CAR-101-2	Cinder block mortar	Basement	P140-5
1210-CAR-102A-1	Plaster skim coat	3rd floor	P140-6
1210-CAR-102A-2	Plaster skim coat	3rd floor	P140-7
1210-CAR-102A-3	Plaster skim coat	3rd floor	P140-8
1210-CAR-102B-1	Plaster base coat	3rd floor	P140-9
1210-CAR-102B-2	Plaster base coat	3rd floor	P140-10
1210-CAR-102B-3	Plaster base coat	3rd floor	P140-11
1210-CAR-200A-1	Ceiling Dry wall	1st floor Hall	P140-12
1210-CAR-200B-1	Ceiling joint comp.	1st floor Hall	P140-13
1210-CAR-201-1	2'x2' large fissure CT	Rm 106	P140-14
1210-CAR-201-2	2'x2' large fissure CT	Rm 106	P140-15
1210-CAR-202A-1	Text. plaster skim	Rm 106	P140-16

Sienna Environmental Technologies  
 Accept  
 Reject

Notes: 1 of 2

Sampled By: Paul J. Maw Date: 12/10/08  
 Relinquished By: Paul J. Maw Date: 12/10/08  
 Received By: [Signature] Date: 12/12/08 1415

P140



# SIENNA ENVIRONMENTAL TECHNOLOGIES, LLC

429 Franklin Street, Suite 102  
Buffalo, NY 14202

Phone 716-332-3134  
Fax 716-332-3136

## Chain of Custody Document

x Report to: \_\_\_\_\_

Client/Contact: <u>C/S Engineers</u> <u>Jeffrey Robbins</u> Building/Location: <u>CARSON HALL</u>	Turn around (circle)  RUSH    48 Hour  24 Hour    72 Hour
Job #: <u>SET954</u> Total # Samples: <u>21</u>	

X PLM    TEM    AAS    OTHER \_\_\_\_\_

Sample #	Description of Sample	Location of Sample	Notes
1210-CAR-202A-2	Text. plaster skim	1st floor Hall	PMU-17
1210-CAR-202A-3	Text. plaster skim	Rm 204	PMU-18
1210-CAR-202B-1	Text. plaster base	Rm 106	PMU-19
1210-CAR-202B-2	Text. plaster base	<del>Rm 106</del> 1st fl. Hall	PMU-20
1210-CAR-202B-3	Text. plaster base	Rm 204	PMU-21
Sienna Environmental Technologies			
<input checked="" type="checkbox"/> Accept			
<input type="checkbox"/> Reject			

Notes: PS 2 of 2

Sampled By: <u>Paul J. Mainz</u>	Date: <u>12/10/08</u>
Relinquished By: <u>Paul J. Mainz</u>	Date: <u>12/10/08</u>
Received By: <u>[Signature]</u>	Date: <u>12/12/08</u>

PMU  
1445



# SIENNA ENVIRONMENTAL TECHNOLOGIES, LLC

429 Franklin St. · Suite 102 · Buffalo, NY 14202 · Ph: 716-332-3134 · Fax: 716-332-3136

## LABORATORY REPORT

Attn: Jeffrey Robbins  
C & S Engineers  
499 Col. Eileen Collins Blvd  
Syracuse, NY 13212

Phone: 315-455-2000 Fax: 315-455-9667

Project: SET954 Kellas Hall

Date Received: 12/12/2008

Date Analyzed: 12/17/2008

Sienna ID: P142

### Polarized Light Microscopy (PLM) by NY State ELAP Method 198.1

Sample	Description	Location	% Fibrous	% Non-Fibrous	% Asbestos Type
1211-KEL-100-1 P142-1	Gray, Non-Fibrous, Homogenous	Cinder Block Mortar - Basement	0%	100%	NAD
1211-KEL-100-2 P142-2	Gray, Non-Fibrous, Homogenous	Cinder Block Mortar - Mezzanine	0%	100%	NAD
1211-KEL-101-1 P142-3	Brown, Non-Fibrous, Homogenous	Brick Mortar - Restroom Lower Level	0%	100%	NAD
1211-KEL-101-2 P142-4	Brown, Non-Fibrous, Homogenous	Brick Mortar - Restroom Lower Level	0%	100%	NAD
1211-KEL-102A-1 P142-5	White, Non-Fibrous, Homogenous	Plaster Skim Coat - 1st Floor Hall	0%	100%	NAD
1211-KEL-102A-2 P142-6	White, Non-Fibrous, Homogenous	Plaster Skim Coat - 1st Floor Hall	0%	100%	NAD
1211-KEL-102B-1 P142-7	Gray, Non-Fibrous, Homogenous	Plaster Base Coat - 1st Floor Hall	0%	100%	NAD
1211-KEL-102B-2 P142-8	Gray, Non-Fibrous, Homogenous	Plaster Base Coat - 1st Floor Hall	0%	100%	NAD
1211-KEL-103A-1 P142-9	Gray, Fibrous, Homogenous	Drywall - 1st Floor Foyer	5%	95%	NAD
1211-KEL-103A-2 P142-10	Gray, Non-Fibrous, Homogenous	Drywall - 1st Floor Foyer	10%	90%	NAD
1211-KEL-103B-1 P142-11	White, Non-Fibrous, Homogenous	Joint Compound - 1st Floor Foyer	0%	100%	NAD
1211-KEL-103B-2 P142-12	White, Non-Fibrous, Homogenous	Joint Compound - 1st Floor Foyer	0%	100%	NAD
1211-KEL-103B-3 P142-13	White, Non-Fibrous, Homogenous	Joint Compound - 1st Floor Foyer	0%	100%	NAD

Julia McKenzie, Tracy Skalski

Analyst(s)

Approved Signatory

Disclaimers: NAD = No asbestos detected. Results relate only to samples provided by client. This report shall not be reproduced, except in full, without written approval by Sienna. Samples analyzed as NAD or Trace (<1%) cannot be guaranteed. Quantitative transmission electron microscopy is currently the only reliable method that can be used to determine if this material can be considered or treated as non-asbestos containing. Analysis performed by Sienna Environmental Technologies, NY ELAP #11727.



# SIENNA ENVIRONMENTAL TECHNOLOGIES, LLC

429 Franklin St. · Suite 102 · Buffalo, NY 14202 · Ph: 716-332-3134 · Fax: 716-332-3136

## LABORATORY REPORT

Attn: Jeffrey Robbins  
C & S Engineers  
499 Col. Eileen Collins Blvd  
Syracuse, NY 13212

Date Received: 12/12/2008

Date Analyzed: 12/17/2008

Sienna ID: P142

Phone: 315-455-2000 Fax: 315-455-9667

Project: SET954 **Kellas Hall**

### Polarized Light Microscopy (PLM) by NY State ELAP Method 198.1

Sample	Description	Location	% Fibrous	% Non-Fibrous	% Asbestos Type
1211-KEL-200A-1 P142-14	Gray, Non-Fibrous, Homogenous	Plaster Skim Coat - Lower Level Ladies Room	0%	100%	NAD
1211-KEL-200B-1 P142-15	White, Non-Fibrous, Homogenous	Plaster Base Coat - Lower Level Ladies Room	0%	100%	NAD
1211-KEL-201-1 P142-16	Gray, Fibrous, Homogenous	Ceiling Tile 2'x4' - Archaeology Lab	30%	70%	NAD
1211-KEL-201-2 P142-17	Gray, Fibrous, Homogenous	Ceiling Tile 2'x4' - Archaeology Lab	30%	70%	NAD
1211-KEL-500-1 P142-18	Gray, Fibrous, Homogenous	Spray-On Insulation - 2nd Floor Near Stairs	70%	30%	NAD
1211-KEL-500-2 P142-19	Gray, Fibrous, Homogenous	Spray-On Insulation - 2nd Floor Near Stairs	65%	35%	NAD
1211-KEL-500-3 P142-20	Gray, Fibrous, Homogenous	Spray-On Insulation - 1st Floor Rear Corridor	60%	40%	NAD

Julia McKenzie, Tracy Skalski  
Analyst(s)

Approved Signatory

Disclaimers: NAD = No asbestos detected. Results relate only to samples provided by client. This report shall not be reproduced, except in full, without written approval by Sienna. Samples analyzed as NAD or Trace (<1%) cannot be guaranteed. Quantitative transmission electron microscopy is currently the only reliable method that can be used to determine if this material can be considered or treated as non-asbestos containing. Analysis performed by Sienna Environmental Technologies, NY ELAP #11727.

# SIENNA ENVIRONMENTAL TECHNOLOGIES, LLC

429 Franklin Street, Suite 102  
Buffalo, NY 14202

Phone 716-332-3134  
Fax 716-332-3136

## Chain of Custody Document

ix Report to: \_\_\_\_\_

Client/Contact: <u>C's Engineers</u> <u>Jeffrey Robbins</u>	Turn around (circle) RUSH 48 Hour 24 Hour 72 Hour
Building/Location: <u>Kellas Hall</u>	
Job #: <u>SET954</u> Total # Samples: <u>20</u>	

PLM     TEM     AAS     OTHER

Sample #	Description of Sample	Location of Sample	Notes <u>PH2</u>
1210-KEL-100-1	Cinder Block mortar	Basement	1
1210-KEL-100-2	Cinder block mortar	Mezzanine	2
1210-KEL-101-1	Brick Mortar	Restroom lower level	3
1210-KEL-101-2	Brick Mortar	Restroom lower level	4
1210-KEL-102A-1	Plaster skim coat	1st-floor hall	5
1211-KEL-102A-2	Plaster skim coat	1st-floor hall	6
1211-KEL-102B-1	Plaster base coat	1st-floor hall	7
1211-KEL-102B-2	Plaster base coat	1st-floor hall	8
1211-KEL-103A-1	Drywall	1st-floor foyer	9
1211-KEL-103A-2	Drywall	1st-floor foyer	10
1211-KEL-103B-1	Joint compound	1st-floor foyer	11
1211-KEL-103B-2	Joint compound	1st-floor foyer	12
1211-KEL-103B-3	Joint compound	1st-floor foyer	13
1211-KEL-200A-1	Plaster skim coat	lower level ladies Rm.	14
1211-KEL-200B-1	Plaster Base coat	lower level ladies Rm.	15
1211-KEL-201-1	Ceiling tile 2'x4'	Archaeology lab	16

Notes: Page 1 of 2

Sienna Environmental Technologies

Accept  
 Reject

Sampled By: Paul J. Mawzy Date: 12/11/08  
 Relinquished By: Paul J. Mawzy Date: 12/11/08  
 Received By: [Signature] Date: 12/12/08 PH2

# SIENNA ENVIRONMENTAL TECHNOLOGIES, LLC

429 Franklin Street, Suite 102  
Buffalo, NY 14202

Phone 716-332-3134  
Fax 716-332-3136

## Chain of Custody Document

x Report to: \_\_\_\_\_

Client/Contact: <u>CES Engineers</u> <u>Jeffrey Robbins</u>	Turn around (circle) RUSH 48 Hour 24 Hour 72 Hour
Building/Location: <u>Kellash Hall</u>	
Job #: <u>SET954</u> Total # Samples: <u>20</u>	

PLM     TEM     AAS     OTHER \_\_\_\_\_

Sample #	Description of Sample	Location of Sample	Notes <sup>P142</sup>
1211-KEL-201-2	2'x4' ceiling tile	Archaeology lab	17
211-KEL-500-1	Spray-on insulation	2nd fl- near stairs	18
211-KEL-500-2	Spray-on insulation	2nd fl- near stairs	19
1211-KEL-500-3	Spray-on insulation	1st fl- rear corridor	20

Notes: PS 2 of 2

Sienna Environmental Technologies  
 Accept  
 Reject

Sampled By: Paul J. Mainz Date: 12/11/08  
 Relinquished By: Paul J. Mainz Date: 12/11/08  
 Received By: [Signature] Date: 12/12/08 <sup>P145</sup>

P142



# SIENNA ENVIRONMENTAL TECHNOLOGIES, LLC

429 Franklin St. · Suite 102 · Buffalo, NY 14202 · Ph: 716-332-3134 · Fax: 716-332-3136

## LABORATORY REPORT

Attn: Jeffrey Robbins  
C & S Engineers  
499 Col. Eileen Collins Blvd  
Syracuse, NY 13212

Date Received: 12/12/2008

Date Analyzed: 12/23/2008

Sienna ID: P147

Phone: 315-455-2000

Fax: 315-455-9667

Project: SET954 SUNY Potsdam Timmerman Hall

### Polarized Light Microscopy (PLM) by NY State ELAP Method 198.1

Sample	Description	Location	% Fibrous	% Non-Fibrous	% Asbestos Type
1211-TIM-100A-1 P147-1	Gray, Non-Fibrous, Homogenous	Plaster Skim Coat - 1st Floor Hall	0%	100%	NAD
1211-TIM-100A-2 P147-2	White, Non-Fibrous, Homogenous	Plaster Skim Coat - 2nd Floor Hall	0%	100%	NAD
1211-TIM-100A-3 P147-3	Tan, Non-Fibrous, Homogenous	Plaster Skim Coat - 2nd Floor Hall	0%	100%	NAD
1211-TIM-200A-1 P147-4	White, Non-Fibrous, Homogenous	Plaster Skim Coat - 1st Floor Hall	0%	100%	NAD
1211-TIM-200A-2 P147-5	White, Non-Fibrous, Homogenous	Plaster Skim Coat - 1st Floor Ladies Room	0%	100%	NAD
1211-TIM-100B-1 P147-6	White, Non-Fibrous, Homogenous	Plaster Base Coat - 1st Floor Hall	0%	100%	NAD
1211-TIM-100B-2 P147-7	Gray, Non-Fibrous, Homogenous	Plaster Base Coat - 2nd Floor Hall	0%	100%	NAD
1211-TIM-100B-3 P147-8	Gray, Non-Fibrous, Homogenous	Plaster Base Coat - 2nd Floor Hall	0%	100%	NAD
1211-TIM-200B-1 P147-9	Gray, Non-Fibrous, Homogenous	Plaster Base Coat - 1st Floor Hall	0%	100%	NAD
1211-TIM-200B-2 P147-10	Gray, Non-Fibrous, Homogenous	Plaster Base Coat - 1st Floor Ladies Room	0%	100%	NAD
1211-TIM-101-1 P147-11	Gray, Non-Fibrous, Homogenous	Cinder Block Mortar - 1st Floor Hall	0%	100%	NAD
1211-TIM-101-2 P147-12	Gray, Non-Fibrous, Homogenous	Cinder Block Mortar - 1st Floor Hall	0%	100%	NAD
1211-TIM-102A-1 P147-13	White, Non-Fibrous, Homogenous	Grout of 2x2 Ceramic Tile - 1st Floor Ladies Room	0%	100%	NAD

Julia McKenzie, Tracy Skalski  
Analyst(s)

Approved Signatory

Disclaimers: NAD = No asbestos detected. Results relate only to samples provided by client. This report shall not be reproduced, except in full, without written approval by Sienna. Samples analyzed as NAD or Trace (<1%) cannot be guaranteed. Quantitative transmission electron microscopy is currently the only reliable method that can be used to determine if this material can be considered or treated as non-asbestos containing. Analysis performed by Sienna Environmental Technologies, NY ELAP #11727.



# SIENNA ENVIRONMENTAL TECHNOLOGIES, LLC

429 Franklin St. • Suite 102 • Buffalo, NY 14202 • Ph: 716-332-3134 • Fax: 716-332-3136

## LABORATORY REPORT

Attn: Jeffrey Robbins  
C & S Engineers  
499 Col. Eileen Collins Blvd  
Syracuse, NY 13212

Date Received: 12/12/2008

Date Analyzed: 12/23/2008

Sienna ID: P147

Phone: 315-455-2000 Fax: 315-455-9667

Project: SET954 SUNY Potsdam Timmerman Hall

### Polarized Light Microscopy (PLM) by NY State ELAP Method 198.1

Sample	Description	Location	% Fibrous	% Non-Fibrous	% Asbestos Type
1211-TIM-102A-2 P147-14	White, Non-Fibrous, Homogenous	Grout of 2x2 Ceramic Tile - 1st Floor Ladies Room	0%	100%	NAD
1211-TIM-102B-1 P147-15	Gray, Non-Fibrous, Homogenous	Mortar of 2x2 Ceramic Tile - 1st Floor Ladies Room	0%	100%	NAD
1211-TIM-102B-2 P147-16	Gray, Non-Fibrous, Homogenous	Mortar of 2x2 Ceramic Tile - 1st Floor Ladies Room	0%	100%	NAD

Julia McKenzie, Tracy Skalski

Analyst(s)

  
Approved Signatory

Disclaimer: NAD = No asbestos detected. Results relate only to samples provided by client. This report shall not be reproduced, except in full, without written approval by Sienna. Samples analyzed as NAD or Trace (<1%) cannot be guaranteed. Quantitative transmission electron microscopy is currently the only reliable method that can be used to determine if this material can be considered or treated as non-asbestos containing. Analysis performed by Sienna Environmental Technologies, NY ELAP #11727.

# SIENNA ENVIRONMENTAL TECHNOLOGIES, LLC

429 Franklin Street, Suite 102  
Buffalo, NY 14202

Phone 716-332-3134  
Fax 716-332-3136

## Chain of Custody Document

Report to: \_\_\_\_\_

Client/Contact: <u>C&amp;S Engineers / Jeffrey Robbins</u>	Turn around (circle)
Building/Location: <u>Timmerman Hall, SUNY Potsdam</u>	
Job #: <u>SET954</u> Total # Samples: <u>16</u>	RUSH 48 Hour 24 Hour 72 Hour

PLM     TEM     AAS     OTHER

Sample #	Description of Sample	Location of Sample	Notes
1211-TIM-100A-1	Plaster skim coat	1st floor hall	P147-1
1211-TIM-100A-2	Plaster skim coat	2nd floor hall	-2
1211-TIM-100A-3	Plaster skim coat	2nd floor hall	-3
1211-TIM-200A-1	Plaster skim coat	1st floor hall	-4
1211-TIM-200A-2	Plaster skim coat	1st floor ladies room	-5
1211-TIM-100B-1	Plaster base coat	1st floor hall	-6
1211-TIM-100B-2	Plaster base coat	2nd floor hall	-7
1211-TIM-100B-3	Plaster base coat	2nd floor hall	-8
1211-TIM-200B-1	Plaster base coat	1st floor hall	-9
1211-TIM-200B-2	Plaster base coat	1st floor ladies room	-10
1211-TIM-101-1	Cinder block mortar	1st floor hall	-11
1211-TIM-101-2	Cinder block mortar	1st floor hall	-12
1211-TIM-102A-1	Grout of 2x2 ceramic tile	1st floor ladies room	-13
1211-TIM-102A-2	Grout of 2x2 ceramic tile	1st floor ladies room	-14
1211-TIM-102B-1	Mortar of 2x2 ceramic tile	1st floor ladies room	-15
1211-TIM-102B-2	Mortar of 2x2 ceramic tile	1st floor ladies room	P147-16

Notes: Page 1 of 1

Sampled By: Paul J. Mairy Date: 12/11/08  
 Relinquished By: Paul J. Mairy Date: 12/11/08  
 Received By: Frank Stalser 1445 P147 Date: 12/12/08





**AmeriSci New York**

117 EAST 30TH ST.  
NEW YORK, NY 10016

TEL: (212) 879-8600 • FAX: (212) 679-3114

## PLM Bulk Asbestos Report

Sienna Environmental Technologies, LL    **Date Received** 12/30/08    **AmeriSci Job #** 208123750  
Attn: Suzanne Kelley    **Date Examined** 12/30/08    **P.O. #**  
429 Franklin Street Suite 102    **ELAP #** 11480    **Page** 1 of 5  
Buffalo, NY 14202    **RE: SET 954; C&S Engineer, SUNY Potsdam; Stowell Hall, SUNY**  
Potsdam

Client No. / HGA	Lab No.	Asbestos Present	Total % Asbestos
1211-STO-100-1 Location: Cinder Block Mortar / Equipment Room  Analyst Description: Grey, Homogeneous, Non-Fibrous, Cementitious, Bulk Material Asbestos Types: Other Material: Non-fibrous 100 %	208123750-01	No	NAD (by NYS ELAP 198.1) by Albert Grohmann on 12/30/08
1211-STO-100-2 Location: Cinder Block Mortar / Room 117  Analyst Description: Grey, Homogeneous, Non-Fibrous, Cementitious, Bulk Material Asbestos Types: Other Material: Non-fibrous 100 %	208123750-02	No	NAD (by NYS ELAP 198.1) by Albert Grohmann on 12/30/08
1211-STO-101-1 Location: Glazed Block Mortar / Room 123A  Analyst Description: Grey, Homogeneous, Non-Fibrous, Cementitious, Bulk Material Asbestos Types: Other Material: Non-fibrous 100 %	208123750-03	No	NAD (by NYS ELAP 198.1) by Albert Grohmann on 12/30/08
1211-STO-101-2 Location: Glazed Block Mortar / 2nd Floor Hall  Analyst Description: Grey, Homogeneous, Non-Fibrous, Cementitious, Bulk Material Asbestos Types: Other Material: Non-fibrous 100 %	208123750-04	No	NAD (by NYS ELAP 198.1) by Albert Grohmann on 12/30/08
1211-STO-102-1 Location: Cementitious Panel / Room 118  Analyst Description: Grey, Homogeneous, Non-Fibrous, Cementitious, Bulk Material Asbestos Types: Chrysotile 16.7 % Other Material: Non-fibrous 83.3 %	208123750-05	Yes	16.7 % (by NYS ELAP 198.1) by Albert Grohmann on 12/30/08

See Reporting notes on last page

Received Time Dec. 30. 2008 3:36PM No. 2632

Client Name: Sienna Environmental Technologies, LLC

**PLM Bulk Asbestos Report**SET 954; C&S Engineer, SUNY Potsdam; Stowell Hall, SUNY  
Potsdam

Client No. / HGA	Lab No.	Asbestos Present	Total % Asbestos
1211-STO-102-2 Location: Cementitious Panel / Room 116	208123750-06	Yes	17.4 % (by NYS ELAP 198.1) by Albert Grohmann on 12/30/08
Analyst Description: Grey, Homogeneous, Non-Fibrous, Cementitious, Bulk Material Asbestos Types: Chrysotile 17.4 % Other Material: Non-fibrous 82.6 %			
1211-STO-103A-1 Location: Plaster Skim Coat / Room 132	208123750-07	No	NAD (by NYS ELAP 198.1) by Albert Grohmann on 12/30/08
Analyst Description: White, Homogeneous, Non-Fibrous, Bulk Material Asbestos Types: Other Material: Non-fibrous 100 %			
1211-STO-103A-2 Location: Plaster Skim Coat / Room 222	208123750-08	No	NAD (by NYS ELAP 198.1) by Albert Grohmann on 12/30/08
Analyst Description: White, Homogeneous, Non-Fibrous, Bulk Material Asbestos Types: Other Material: Non-fibrous 100 %			
1211-STO-103A-3 Location: Plaster Skim Coat / Room 312A	208123750-09	No	NAD (by NYS ELAP 198.1) by Albert Grohmann on 12/30/08
Analyst Description: White, Homogeneous, Non-Fibrous, Bulk Material Asbestos Types: Other Material: Non-fibrous 100 %			
1211-STO-202A-1 Location: Plaster Skim Coat / 1st Floor Mens Room	208123750-10	No	NAD (by NYS ELAP 198.1) by Albert Grohmann on 12/30/08
Analyst Description: White, Homogeneous, Non-Fibrous, Bulk Material Asbestos Types: Other Material: Non-fibrous 100 %			
1211-STO-202A-2 Location: Plaster Skim Coat / 2nd Floor Ladies Room	208123750-11	No	NAD (by NYS ELAP 198.1) by Albert Grohmann on 12/30/08
Analyst Description: White, Homogeneous, Non-Fibrous, Bulk Material Asbestos Types: Other Material: Non-fibrous 100 %			

See Reporting notes on last page

Received Time Dec. 30. 2008 3:36PM No. 2632

**PLM Bulk Asbestos Report**SET 954; C&S Engineer, SUNY Potsdam; Stowell Hall, SUNY  
Potsdam

Client No. / HGA	Lab No.	Asbestos Present	Total % Asbestos
1211-STO-103B-1 Location: Plaster Base Coat / Room 132	208123750-12	No	NAD (by NYS ELAP 198.1) by Albert Grohmann on 12/30/08
Analyst Description: Grey, Homogeneous, Non-Fibrous, Cementitious, Bulk Material Asbestos Types: Other Material: Cellulose Trace, Non-fibrous 100 %			
1211-STO-103B-2 Location: Plaster Base Coat / Room 222	208123750-13	No	NAD (by NYS ELAP 198.1) by Albert Grohmann on 12/30/08
Analyst Description: Grey, Homogeneous, Non-Fibrous, Cementitious, Bulk Material Asbestos Types: Other Material: Cellulose Trace, Non-fibrous 100 %			
1211-STO-103B-3 Location: Plaster Base Coat / Room 312A	208123750-14	No	NAD (by NYS ELAP 198.1) by Albert Grohmann on 12/30/08
Analyst Description: Grey, Homogeneous, Non-Fibrous, Cementitious, Bulk Material Asbestos Types: Other Material: Cellulose Trace, Non-fibrous 100 %			
1211-STO-202B-1 Location: Plaster Base Coat / 1st Floor Men's Room	208123750-15	No	NAD (by NYS ELAP 198.1) by Albert Grohmann on 12/30/08
Analyst Description: Grey, Homogeneous, Non-Fibrous, Cementitious, Bulk Material Asbestos Types: Other Material: Cellulose Trace, Non-fibrous 100 %			
1211-STO-202B-2 Location: Plaster Base Coat / 2nd Floor Ladies Room	208123750-16	No	NAD (by NYS ELAP 198.1) by Albert Grohmann on 12/30/08
Analyst Description: Grey, Homogeneous, Non-Fibrous, Cementitious, Bulk Material Asbestos Types: Other Material: Cellulose Trace, Non-fibrous 100 %			
1211-STO-104-1 Location: Mortar Of White Brick / 1st Floor Hall	208123750-17	No	NAD (by NYS ELAP 198.1) by Albert Grohmann on 12/30/08
Analyst Description: Grey, Homogeneous, Non-Fibrous, Cementitious, Bulk Material Asbestos Types: Other Material: Non-fibrous 100 %			

See Reporting notes on last page

Received Time Dec. 30, 2008 3:36PM No. 2632

Client Name: Sienna Environmental Technologies, LLC

**PLM Bulk Asbestos Report**SET 954; C&S Engineer, SUNY Potsdam; Stowell Hall, SUNY  
Potsdam

Client No. / HGA	Lab No.	Asbestos Present	Total % Asbestos
1211-STO-104-2 Location: Mortar Of White Brick / 1st Floor Hall	208123750-18	No	NAD (by NYS ELAP 198.1) by Albert Grohmann on 12/30/08
Analyst Description: Grey, Homogeneous, Non-Fibrous, Cementitious, Bulk Material Asbestos Types: Other Material: Non-fibrous 100 %			
1211-STO-200-1 Location: 2x4 Dot + Fissure Ceiling Tile / Basement Hall	208123750-19	No	NAD (by NYS ELAP 198.1) by Albert Grohmann on 12/30/08
Analyst Description: White/Grey, Homogeneous, Fibrous, Bulk Material Asbestos Types: Other Material: Cellulose 45 %, Fibrous glass 40 %, Non-fibrous 15 %			
1211-STO-200-2 Location: 2x4 Dot + Fissure Ceiling Tile / Basement Hall	208123750-20	No	NAD (by NYS ELAP 198.1) by Albert Grohmann on 12/30/08
Analyst Description: White/Grey, Homogeneous, Fibrous, Bulk Material Asbestos Types: Other Material: Cellulose 45 %, Fibrous glass 40 %, Non-fibrous 15 %			
1211-STO-201-1 Location: 2x4 Dot Ceiling Tile / 1st Floor Hall	208123750-21	No	NAD (by NYS ELAP 198.1) by Albert Grohmann on 12/30/08
Analyst Description: OffWhite, Homogeneous, Fibrous, Bulk Material Asbestos Types: Other Material: Cellulose 50 %, Fibrous glass 36 %, Non-fibrous 15 %			
1211-STO-201-2 Location: 2x4 Dot Ceiling Tile / 1st Floor Hall	208123750-22	No	NAD (by NYS ELAP 198.1) by Albert Grohmann on 12/30/08
Analyst Description: OffWhite, Homogeneous, Fibrous, Bulk Material Asbestos Types: Other Material: Cellulose 50 %, Fibrous glass 36 %, Non-fibrous 15 %			

See Reporting notes on last page


Received Time Dec. 30, 2008 3:36PM No. 2632

# PLM Bulk Asbestos Report

SET 954; C&S Engineer, SUNY Potsdam; Stowell Hall, SUNY  
Potsdam

---

## Reporting Notes:

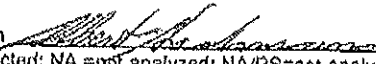Analyzed by: Albert Grohmann 

\*NAD/NSD =no asbestos detected; NA =not analyzed; NA/PS=not analyzed/positive stop; PLM Bulk Asbestos Analysis by EPA 600/M4-82-020 per 40 CFR 763 (NVLAP Lab Code 200648-0), ELAP PLM Method 198.1 for NY friable samples or 198.6 for NOB samples (NY ELAP Lab ID11480); Note:PLM is not consistently reliable in detecting asbestos in floor coverings and similar non-friable organically bound materials. NAD or Trace results by PLM are inconclusive, TEM is currently the only method that can be used to determine if this material can be considered or treated as non asbestos-containing in NY State (also see EPA Advisory for floor tile,FR 59,146,38970,8/1/94), National Institute of Standards and Technology Accreditation requirements mandate that this report must not be reproduced except in full without the approval of the lab. This PLM report relates ONLY to the items tested. AIHA Lab # 102843.

Reviewed By: \_\_\_\_\_

\_\_\_\_\_ END OF REPORT \_\_\_\_\_

Received Time Dec. 30. 2008 3:36PM No. 2632

# SIENNA ENVIRONMENTAL TECHNOLOGIES, LLC

429 Franklin Street, Suite 102  
Buffalo, NY 14202

Phone 716-332-3134  
Fax 716-332-3136

## Chain of Custody Document

x Report to: \_\_\_\_\_

Client/Contact: <u>C&amp;S Engineer, SUNY Potsdam</u> <u>Jeffrey Robbins</u>		Turn around (circle) RUSH 48 Hour 24 Hour 72 Hour
Building/Location: <u>Stowell Hall, SUNY Potsdam</u>		
Job #: <u>SET954</u>	Total # Samples: <u>22</u>	<u>208128750</u>

PLM     TEM     AAS     OTHER

Sample #	Description of Sample	Location of Sample	Notes
1211-STO-100-1	Cinder block mortar	Equipment Room	-1
1211-STO-100-2	Cinder block mortar	Room 117	-2
1211-STO-101-1	Glazed block mortar	Room 123A	-3
1211-STO-101-2	Glazed block mortar	2nd floor hall	-4
1211-STO-102-1	Cementitious panel	Room 116	-5
1211-STO-102-2	Cementitious panel	Room 116	-6
1211-STO-103A-1	Plaster skim coat	Room 132	-7
1211-STO-103A-2	Plaster skim coat	Room 222	-8
1211-STO-103A-3	Plaster skim coat	Room 312A	-9
1211-STO-202A-1	Plaster skim coat	1st floor men's room	-10
1211-STO-202A-2	Plaster skim coat	2nd floor ladies room	-11
1211-STO-103B-1	Plaster base coat	Room 132	-12
1211-STO-103B-2	Plaster base coat	Room 222	-13
1211-STO-103B-3	Plaster base coat	Room 312A	-14
1211-STO-202B-1	Plaster base coat	1st floor men's room	-15
1211-STO-202B-2	Plaster base coat	2nd floor ladies room	-16

Notes: Page 1 of 2

Sienna Environmental  
Technologies  
 Accept  
 Reject

Sampled By: [Signature] Date: 12/11/08  
 Relinquished By: [Signature] Date: \_\_\_\_\_  
 Received By: Rose Rodriguez Date: 12/30/08  
 Received Time: Dec. 30, 2008 3:36PM No. 2632

# SIENNA ENVIRONMENTAL TECHNOLOGIES, LLC

429 Franklin Street, Suite 102  
Buffalo, NY 14202

Phone 716-332-3134  
Fax 716-332-3136

## Chain of Custody Document

Report to: \_\_\_\_\_

Client/Contact: <u>C &amp; S Engineers Jeffrey Robbins</u>	Turn around (circle)
Building/Location: <u>Stowell Hall, 2081 23750 -</u>	
Job #: <u>SET954</u> Total # Samples: <u>22</u>	<input checked="" type="radio"/> RUSH 48 Hour <input type="radio"/> 24 Hour <input type="radio"/> 72 Hour

PLM    TEM    AAS   OTHER \_\_\_\_\_

Sample #	Description of Sample	Location of Sample	Notes
<del>1211-5TO-104-1</del>	Mortar of white brick	1st floor hall	-17
1211-5TO-104-2	Mortar of white brick	1st floor hall	-18
1211-5TO-200-1	2x4 dot + fissure ceiling tile	Basement hall	-19
1211-5TO-200-2	2x4 dot + fissure ceiling tile	Basement hall	-20
1211-5TO-201-1	2x4 dot ceiling tile	1st floor hall	-21
1211-5TO-201-2	2x4 dot ceiling tile	1st floor hall	-22

Sienna Environmental  
Technologies  
 Accept  
 Reject

Notes: Page 2 of 2

Sampled By: Paul J. Maw Date: 12/11/08  
 Relinquished By: Paul J. Maw Date: \_\_\_\_\_  
 Received By: Rose Rodriguez Date: 12/30/08  
 Received Time: Dec. 30, 2008 3:36PM No. 2632



# SIENNA ENVIRONMENTAL TECHNOLOGIES, LLC

429 Franklin St. · Suite 102 · Buffalo, NY 14202 · Ph: 716-332-3134 · Fax: 716-332-3136

## LABORATORY REPORT

Attn: Jeffrey Robbins  
C & S Engineers  
499 Col. Eileen Collins Blvd  
Syracuse, NY 13212

Date Received: 12/18/2008

Date Analyzed: 12/28/2008

Sienna ID: P152

Phone: 315-455-2000

Fax: 315-455-9667

Project: SET954 **Crumb Library**

### Polarized Light Microscopy (PLM) by NY State ELAP Method 198.1

Sample	Description	Location	% Fibrous	% Non-Fibrous	% Asbestos Type
1211-CRU-100A-1 P152-1	White, Non-Fibrous, Homogenous	Skim Coat Plaster - 2nd Floor Library	0%	100%	NAD
1211-CRU-100A-2 P152-2	White, Non-Fibrous, Non-Homogenous	Skim Coat Plaster - 2nd Floor Library	0%	100%	NAD
1211-CRU-100A-3 P152-3	White, Non-Fibrous, Homogenous	Skim Coat Plaster - 2nd Floor Library	0%	100%	NAD
1211-CRU-100B-1 P152-4	Gray, Non-Fibrous, Homogenous	Base Coat Plaster - 2nd Floor Library	5%	95%	NAD
1211-CRU-100B-2 P152-5	Gray, Non-Fibrous, Homogenous	Base Coat Plaster - 2nd Floor Library	0%	100%	NAD
1211-CRU-100B-3 P152-6	Gray, Non-Fibrous, Homogenous	Base Coat Plaster - 2nd Floor Library	0%	100%	NAD
1211-CRU-101-1 P152-7	Gray, Non-Fibrous, Homogenous	Cinder Block Mortar - Basement	0%	100%	NAD
1211-CRU-101-2 P152-8	Gray, Non-Fibrous, Homogenous	Cinder Block Mortar - Basement	0%	100%	NAD
1211-CRU-102-1 P152-9	Gray, Non-Fibrous, Homogenous	Brick Mortar - 1st Floor	5%	95%	NAD
1211-CRU-102-2 P152-10	Gray, Non-Fibrous, Homogenous	Brick Mortar - 1st Floor	0%	100%	NAD
1211-CRU-200-1 P152-11	Gray, Fibrous, Homogenous	1'x1' Dot and Fissure Ceiling Tile - 2nd Floor Library	20%	80%	NAD
1211-CRU-200-2 P152-12	Gray, Fibrous, Homogenous	1'x1' Dot and Fissure Ceiling Tile - 2nd Floor Library	20%	80%	NAD
1211-CRU-201-1 P152-13	Gray, Fibrous, Homogenous	2'x2' Dot and Texture Ceiling Tile - 1st Floor	30%	70%	NAD

Tracy Skalski  
Analyst(s)

Approved Signatory

Disclaimers: NAD = No asbestos detected. Results relate only to samples provided by client. This report shall not be reproduced, except in full, without written approval by Sienna. Samples analyzed as NAD or Trace (<1%) cannot be guaranteed. Quantitative transmission electron microscopy is currently the only reliable method that can be used to determine if this material can be considered or treated as non-asbestos containing. Analysis performed by Sienna Environmental Technologies, NY ELAP #11727.



# SIENNA ENVIRONMENTAL TECHNOLOGIES, LLC

429 Franklin Street, Suite 102  
Buffalo, NY 14202

Phone 716-332-3134  
Fax 716-332-3136

## Chain of Custody Document

Fax Report to: \_\_\_\_\_

Client/Contact: <u>C/S Engineers - Jeffrey Robbins</u>	Turn around (circle) RUSH 48 Hour 24 Hour 72 Hour
Building/Location: <u>CRUMB LIBRARY</u>	
Job #: <u>SET 954</u> Total # Samples: <u>14</u>	

PLM     TEM     AAS     OTHER \_\_\_\_\_

Sample #	Description of Sample	Location of Sample	Notes
1211-CRU-100A-1	Skim coat plaster	2nd fl. library	P152-1
1211-CRU-100A-2	Skim coat plaster	2nd fl. library	-2
1211-CRU-100A-3	Skim coat plaster	2nd fl. library	-3
1211-CRU-100B-1	Base coat plaster	2nd fl. library	-4
1211-CRU-100B-2	Base coat plaster	2nd fl. library	-5
1211-CRU-100B-3	Base coat plaster	2nd fl. library	-6
1211-CRU-101-1	Cinder block mortar	Basement	-7
1211-CRU-101-2	Cinder block mortar	Basement	-8
1211-CRU-102-1	Brick mortar	1st floor	-9
1211-CRU-102-2	Brick mortar	1st floor	-10
1211-CRU-200-1	1x1 dot & fissure CT	2nd floor library	-11
1211-CRU-200-2	1x1 dot & fissure CT	2nd floor library	-12
1211-CRU-201-1	2x2 dot & texture CT	1st floor	-13
1211-CRU-201-2	2x2 dot & texture CT	1st floor	P152-14
Sienna Environmental Technologies			

Notes: \_\_\_\_\_

Accept  
 Reject

Sampled By: Paul J. Mainy Date: 12/11/08

Relinquished By: Paul J. Mainy Date: \_\_\_\_\_

Received By: G. Stalski 1500 P152 Date: 12/18/08



# SIENNA ENVIRONMENTAL TECHNOLOGIES, LLC

429 Franklin St. · Suite 102 · Buffalo, NY 14202 · Ph: 716-332-3134 · Fax: 716-332-3136

## LABORATORY REPORT

Attn: Jeffrey Robbins  
C & S Engineers  
499 Col. Eileen Collins Blvd  
Syracuse, NY 13212

Date Received: 12/18/2008

Date Analyzed: 12/31/2008

Sienna ID: P159

Phone: 315-455-2000 Fax: 315-455-9667

Project: SET954 Satterlee Hall

### Polarized Light Microscopy (PLM) by NY State ELAP Method 198.1

Sample	Description	Location	% Fibrous	% Non-Fibrous	% Asbestos Type
1212-SAT-100A-1 P159-1	White, Non-Fibrous, Homogenous	Skim Coat Plaster - Auditorium	0%	100%	NAD
1212-SAT-100A-2 P159-2	White, Non-Fibrous, Homogenous	Skim Coat Plaster - 1st Floor Mens Room	0%	100%	NAD
1212-SAT-100A-3 P159-3	White, Non-Fibrous, Homogenous	Skim Coat Plaster - 2nd Floor Ladies Room	0%	100%	NAD
1212-SAT-100A-4 P159-4	White, Non-Fibrous, Homogenous	Skim Coat Plaster - Room 223	0%	100%	NAD
1212-SAT-100A-5 P159-5	White, Non-Fibrous, Homogenous	Skim Coat Plaster - 3rd Floor Mens Room	0%	100%	NAD
1212-SAT-100B-1 P159-6	Gray, Non-Fibrous, Homogenous	Base Coat Plaster - Auditorium	0%	100%	NAD
1212-SAT-100B-2 P159-7	Gray, Non-Fibrous, Homogenous	Base Coat Plaster - 1st Floor Mens Room	0%	100%	NAD
1212-SAT-100B-3 P159-8	Gray, Non-Fibrous, Homogenous	Base Coat Plaster - 2nd Floor Ladies Room	0%	100%	NAD
1212-SAT-100B-4 P159-9	Gray, Non-Fibrous, Homogenous	Base Coat Plaster - Room 223	0%	100%	NAD
1212-SAT-100B-5 P159-10	Gray, Non-Fibrous, Homogenous	Base Coat Plaster - 3rd Floor Mens Room	0%	100%	NAD
1212-SAT-101A-1 P159-11	Gray, Non-Fibrous, Homogenous	Skim Coat Sand Plaster - 1st Floor Hall	0%	100%	NAD
1212-SAT-101A-2 P159-12	Gray, Non-Fibrous, Homogenous	Skim Coat Sand Plaster - Room 113	0%	100%	NAD
1212-SAT-101A-3 P159-13	Gray, Non-Fibrous, Homogenous	Skim Coat Sand Plaster - 2nd Floor Hall	0%	100%	NAD

Julia McKenzie, Tracy Skalski  
Analyst(s)

Approved Signatory

Disclaimer: NAD = No asbestos detected. Results relate only to samples provided by client. This report shall not be reproduced, except in full, without written approval by Sienna. Samples analyzed as NAD or Trace (<1%) cannot be guaranteed. Quantitative transmission electron microscopy is currently the only reliable method that can be used to determine if this material can be considered or treated as non-asbestos containing. Analysis performed by Sienna Environmental Technologies, NY ELAP #11727.



# SIENNA ENVIRONMENTAL TECHNOLOGIES, LLC

429 Franklin St. · Suite 102 · Buffalo, NY 14202 · Ph: 716-332-3134 · Fax: 716-332-3136

## LABORATORY REPORT

Attn: Jeffrey Robbins  
C & S Engineers  
499 Col. Eileen Collins Blvd  
Syracuse, NY 13212

Date Received: 12/18/2008  
Date Analyzed: 12/31/2008  
Sienna ID: P159

Phone: 315-455-2000 Fax: 315-455-9667

Project: SET954 Satterlee Hall

### Polarized Light Microscopy (PLM) by NY State ELAP Method 198.1

Sample	Description	Location	% Fibrous	% Non-Fibrous	% Asbestos Type
1212-SAT-101A-4 P159-14	Gray, Non-Fibrous, Homogenous	Skim Coat Sand Plaster - 2nd Floor Hall	0%	100%	NAD
1212-SAT-101A-5 P159-15	Gray, Non-Fibrous, Homogenous	Skim Coat Sand Plaster - 3rd Floor Hall	0%	100%	NAD
1212-SAT-101B-1 P159-16	Gray, Non-Fibrous, Homogenous	Base Coat Sand Plaster - 1st Floor Hall	0%	100%	NAD
1212-SAT-101B-2 P159-17	Gray, Non-Fibrous, Homogenous	Base Coat Sand Plaster - Room 113	0%	100%	NAD
1212-SAT-101B-3 P159-18	Gray, Non-Fibrous, Homogenous	Base Coat Sand Plaster - 2nd Floor Hall	0%	100%	NAD
1212-SAT-101B-4 P159-19	Gray, Non-Fibrous, Homogenous	Base Coat Sand Plaster - 2nd Floor Hall	0%	100%	NAD
1212-SAT-101B-5 P159-20	Gray, Non-Fibrous, Homogenous	Base Coat Sand Plaster - 3rd Floor Hall	0%	100%	NAD
1212-SAT-102-1 P159-21	Gray, Non-Fibrous, Homogenous	Glazed Block Mortar - 1st Floor Hall	0%	100%	NAD
1212-SAT-102-2 P159-22	Gray, Non-Fibrous, Homogenous	Glazed Block Mortar - 2nd Floor Hall	0%	100%	NAD
1212-SAT-103-1 P159-23	Gray, Non-Fibrous, Homogenous	Cinder Block Mortar - Basement	0%	100%	NAD
1212-SAT-103-2 P159-24	Gray, Non-Fibrous, Homogenous	Cinder Block Mortar - Basement	0%	100%	NAD
1212-SAT-104A-1 P159-25	White, Fibrous, Non- Homogenous	Drywall - 1st Floor Hall	0%	100%	NAD
1212-SAT-104A-2 P159-26	White, Fibrous, Homogenous	Drywall - 1st Floor Hall	0%	100%	NAD

Julia McKenzie, Tracy Skalski  
Analyst(s)

Approved Signatory

Disclaimers: NAD = No asbestos detected. Results relate only to samples provided by client. This report shall not be reproduced, except in full, without written approval by Sienna. Samples analyzed as NAD or Trace (<1%) cannot be guaranteed. Quantitative transmission electron microscopy is currently the only reliable method that can be used to determine if this material can be considered or treated as non-asbestos containing. Analysis performed by Sienna Environmental Technologies, NY ELAP #11727.



# SIENNA ENVIRONMENTAL TECHNOLOGIES, LLC

429 Franklin St. · Suite 102 · Buffalo, NY 14202 · Ph: 716-332-3134 · Fax: 716-332-3136

## LABORATORY REPORT

Attn: Jeffrey Robbins  
C & S Engineers  
499 Col. Eileen Collins Blvd  
Syracuse, NY 13212

Date Received: 12/18/2008

Date Analyzed: 12/31/2008

Sienna ID: P159

Phone: 315-455-2000

Fax: 315-455-9667

Project: SET954 Satterlee Hall

### Polarized Light Microscopy (PLM) by NY State ELAP Method 198.1

Sample	Description	Location	% Fibrous	% Non-Fibrous	% Asbestos Type
1212-SAT-104B-1 P159-27	White, Non-Fibrous, Homogenous	Joint Compound - 1st Floor Hall	0%	100%	NAD
1212-SAT-104B-2 P159-28	White, Non-Fibrous, Homogenous	Joint Compound - 1st Floor Hall	0%	100%	NAD
1212-SAT-200-1 P159-29	Gray, Non-Fibrous, Homogenous	1x1 Splined Ceiling Tile - 1st Floor Hall	15%	85%	NAD
1212-SAT-200-2 P159-30	Gray, Non-Fibrous, Homogenous	1x1 Splined Ceiling Tile - 1st Floor Hall	10%	90%	NAD
1212-SAT-201A-1 P159-31	White, Non-Fibrous, Homogenous	Plaster Skim Coat - 1st Floor Hall	0%	100%	NAD
1212-SAT-201B-1 P159-32	Gray, Non-Fibrous, Homogenous	Plaster Base Coat - 1st Floor Hall	0%	100%	NAD
1212-SAT-202-1 P159-33	Brown, Fibrous, Non- Homogenous	1x1 Textured Ceiling Tile - Room 104	40%	60%	NAD
1212-SAT-202-2 P159-34	Brown, Fibrous, Non- Homogenous	1x1 Textured Ceiling Tile - Room 104	30%	70%	NAD
1212-SAT-203-1 P159-35	Gray, Fibrous, Non- Homogenous	2x2 Dot & Texture Ceiling Tile - 1st Floor Hall	20%	80%	NAD
1212-SAT-203-2 P159-36	Gray, Fibrous, Non- Homogenous	2x2 Dot & Texture Ceiling Tile - 1st Floor Hall	40%	60%	NAD
1212-SAT-204-1 P159-37	Brown, Fibrous, Non- Homogenous	2x2 Dot Ceiling Tile - Room 200	20%	80%	NAD
1212-SAT-204-2 P159-38	Brown, Fibrous, Non- Homogenous	2x2 Dot Ceiling Tile - Room 200	15%	85%	NAD

Julia McKenzie, Tracy Skalski  
Analyst(s)

Approved Signatory

Disclaimers: NAD = No asbestos detected. Results relate only to samples provided by client. This report shall not be reproduced, except in full, without written approval by Sienna. Samples analyzed as NAD or Trace (<1%) cannot be guaranteed. Quantitative transmission electron microscopy is currently the only reliable method that can be used to determine if this material can be considered or treated as non-asbestos containing. Analysis performed by Sienna Environmental Technologies, NY ELAP #11727.

# SIENNA ENVIRONMENTAL TECHNOLOGIES, LLC

429 Franklin Street, Suite 102  
Buffalo, NY 14202

Phone 716-332-3134  
Fax 716-332-3136

## Chain of Custody Document

X Report to: \_\_\_\_\_

Client/Contact: <u>C/S Engineers - Jeffrey Robbins</u>	Turn around (circle)  RUSH 48 Hour  24 Hour 72 Hour
Building/Location: <u>SATTERLEE HALL</u>	
Job #: <u>SET954</u> Total # Samples: <u>30</u>	

X PLM           TEM           AAS           OTHER

Sample #	Description of Sample	Location of Sample	Notes
1212-SAT-100A-1	Skim coat plaster	Auditorium	P159-1
1212-SAT-100A-2	Skim coat plaster	1st fl. mens room	-2
1212-SAT-100A-3	Skim coat plaster	2nd fl. ladies rm.	-3
1212-SAT-100A-4	Skim coat plaster	Rm 223	-4
1212-SAT-100A-5	Skim coat plaster	3rd fl. mens room	-5
1212-SAT-100B-1	Base coat plaster	Auditorium	-6
1212-SAT-100B-2	Base coat plaster	1st fl. mens room	-7
1212-SAT-100B-3	Base coat plaster	2nd fl. ladies room.	-8
1212-SAT-100B-4	Base coat plaster	Rm. 223	-9
1212-SAT-100B-5	Base coat plaster	3rd fl. mens room.	-10
1212-SAT-101A-1	Skim coat sand plaster	1st fl. hall	-11
1212-SAT-101A-2	Skim coat sand plaster	Rm 113	-12
1212-SAT-101A-3	Skim coat sand plaster	2nd fl. hall	-13
1212-SAT-101A-4	Skim coat sand plaster	2nd fl. hall	-14
1212-SAT-101A-5	Skim coat sand plaster	3rd fl. hall	-15
1212-SAT-101B-1	base coat sand plaster	1st fl. hall	P159-16

Notes: pg 1 of 3

Sienna Environmental Technologies  
 Accept  
 Reject

Sampled By: Paul J. Mair Date: 12/12/08

Relinquished By: Paul J. Mair Date: \_\_\_\_\_

Received By: J. Stalinski 1500 P159 Date: 12/18/08

# SIENNA ENVIRONMENTAL TECHNOLOGIES, LLC

429 Franklin Street, Suite 102  
Buffalo, NY 14202

Phone 716-332-3134  
Fax 716-332-3136

## Chain of Custody Document

x Report to: \_\_\_\_\_

Client/Contact: <u>C &amp; S Engineers - Jeffrey Robbins</u>	Turn around (circle)  RUSH 48 Hour  24 Hour 72 Hour
Building/Location: <u>SATTERLEE HALL</u>	
Job #: <u>SET954</u> Total # Samples: <u>38</u>	

PLM     TEM     AAS     OTHER

Sample #	Description of Sample	Location of Sample	Notes
1212-SAT-101B-2	Base coat sand plaster	Rm 113	PS9-17
1212-SAT-101B-3	Base coat sand plaster	2nd fl. hall	-18
1212-SAT-101B-4	Base coat sand plaster	2nd fl. hall	-19
1212-SAT-101B-5	Base coat sand plaster	3rd fl. hall	-20
1212-SAT-102-1	Glazed block mortar	1st fl. hall	-21
1212-SAT-102-2	Glazed block mortar	2nd fl. hall	-22
1212-SAT-103-1	Cinder block mortar	Basement	-23
1212-SAT-103-2	Cinder block mortar	Basement	-24
1212-SAT-104A-1	Drywall	1st fl. hall	-25
1212-SAT-104A-2	Drywall	1st fl. hall	-26
1212-SAT-104B-1	Joint Compound	1st fl. hall	-27
1212-SAT-104B-2	Joint Compound	1st fl. hall	-28
1212-SAT-200-1	1x1 splined CT	1st fl. hall	-29
1212-SAT-200-2	1x1 splined CT	1st fl. hall	-30
1212-SAT-201A-1	Plaster <del>base</del> <sup>SKIM</sup> coat	1st fl. hall	-31
1212-SAT-201B-1	Plaster base coat	1st fl. hall	PS9-32

Notes:

PS 2 of 3

Sienna Environmental  
Technologies

Accept

Reject

Sampled By:

*Paul J. Mainz*

Relinquished By:

*Paul J. Mainz*

Received By:

*C. Skolci 1500*

PS9

Date: 12/12/08

Date: 12/12/08

Date: 12/18/08

# SIENNA ENVIRONMENTAL TECHNOLOGIES, LLC

## Chain of Custody Document

429 Franklin Street, Suite 102  
Buffalo, NY 14202

Phone 716-332-3134  
Fax 716-332-3136

.x Report to: \_\_\_\_\_

Client/Contact: <u>C S Engineers - Jeffrey Robbins</u>	Turn around (circle)  RUSH    48 Hour  24 Hour    72 Hour
Building/Location: <u>SATTERLEE HALL</u>	
Job #: <u>SET954</u> Total # Samples: <u>38</u>	

PLM     TEM     AAS    OTHER \_\_\_\_\_

Sample #	Description of Sample	Location of Sample	Notes
1212-SAT-202-1	1x1 textured CT	Rm 104	P159-33
1212-SAT-202-2	1x1 textured CT	Rm 104	-34
1212-SAT-203-1	2x2 dot texture CT	1st fl. hall	-35
1212-SAT-203-2	2x2 dot texture CT	1st fl. hall	-36
1212-SAT-204-1	2x2 dot CT	Rm 200	-37
1212-SAT-204-2	2x2 dot CT	Rm 200	P159-38

**Sienna Environmental  
Technologies**  
 Accept  
 Reject

Notes: PS 3 of 3

Sampled By: Paul J. Mair    Date: 12/12/08  
 Relinquished By: Paul J. Mair    Date: \_\_\_\_\_  
 Received By: J. Steele 1500    P159    Date: 12/18/08



**AmeriSci New York**  
117 EAST 30TH ST.  
NEW YORK, NY 10016  
TEL: (212) 679-8600 • FAX: (212) 679-3114

## PLM Bulk Asbestos Report

Sienna Environmental Technologies, LL    **Date Received** 12/30/08    **AmeriSci Job #** 208123751  
Attn: Suzanne Kelley    **Date Examined** 12/30/08    **P.O. #**  
429 Franklin Street Suite 102    **ELAP #** 11480    **Page** 1 of 4  
Buffalo, NY 14202    **RE: SET 954; C&S Engineers; Thatcher Hall, SUNY Potsdam**

Client No. / HGA	Lab No.	Asbestos Present	Total % Asbestos
1216-THA-100-1 Location: Cinder Block Mortar / 1st Floor Mechanical  Analyst Description: Grey, Homogeneous, Non-Fibrous, Cementitious, Bulk Material Asbestos Types: Other Material: Non-fibrous 100 %	208123751-01	No	NAD (by NYS ELAP 198.1) by Karol H. Lu on 12/30/08
1216-THA-100-2 Location: Cinder Block Mortar / 1st Floor Mechanical  Analyst Description: Grey, Homogeneous, Non-Fibrous, Cementitious, Bulk Material Asbestos Types: Other Material: Non-fibrous 100 %	208123751-02	No	NAD (by NYS ELAP 198.1) by Karol H. Lu on 12/30/08
1216-THA-101A-1 Location: Grout Of Ceramic Tile / Kitchen  Analyst Description: White, Homogeneous, Non-Fibrous, Bulk Material Asbestos Types: Other Material: Non-fibrous 100 %	208123751-03	No	NAD (by NYS ELAP 198.1) by Karol H. Lu on 12/30/08
1216-THA-101A-2 Location: Grout Of Ceramic Tile / Kitchen  Analyst Description: White, Homogeneous, Non-Fibrous, Bulk Material Asbestos Types: Other Material: Non-fibrous 100 %	208123751-04	No	NAD (by NYS ELAP 198.1) by Karol H. Lu on 12/30/08
1216-THA-101B-1 Location: Thinset Of Ceramic Tile / Kitchen  Analyst Description: Grey, Homogeneous, Non-Fibrous, Cementitious, Bulk Material Asbestos Types: Other Material: Non-fibrous 100 %	208123751-05	No	NAD (by NYS ELAP 198.1) by Karol H. Lu on 12/30/08

See Reporting notes on last page  
Received Time Dec. 30, 2008 2:02PM No. 2621



Client Name: Sienna Environmental Technologies, LLC

**PLM Bulk Asbestos Report**

SET 954; C&amp;S Engineers; Thatcher Hall, SUNY Potsdam

Client No. / HGA	Lab No.	Asbestos Present	Total % Asbestos
1216-THA-101B-2 Location: Thinset Of Ceramic Tile / Kitchen	208123751-06	No	NAD (by NYS ELAP 198.1) by Karol H. Lu on 12/30/08
Analyst Description: Grey, Homogeneous, Non-Fibrous, Cementitious, Bulk Material Asbestos Types: Other Material: Non-fibrous 100 %			
1216-THA-102A-1 Location: Plaster Skim Coat / 2nd Floor Dining Room	208123751-07	No	NAD (by NYS ELAP 198.1) by Karol H. Lu on 12/30/08
Analyst Description: White, Homogeneous, Non-Fibrous, Bulk Material Asbestos Types: Other Material: Non-fibrous 100 %			
1216-THA-102A-2 Location: Plaster Skim Coat / 2nd Floor Dining Room	208123751-08	No	NAD (by NYS ELAP 198.1) by Karol H. Lu on 12/30/08
Analyst Description: White, Homogeneous, Non-Fibrous, Bulk Material Asbestos Types: Other Material: Non-fibrous 100 %			
1216-THA-102A-3 Location: Plaster Skim Coat / 2nd Floor Dining Room	208123751-09	No	NAD (by NYS ELAP 198.1) by Karol H. Lu on 12/30/08
Analyst Description: White, Homogeneous, Non-Fibrous, Bulk Material Asbestos Types: Other Material: Non-fibrous 100 %			
1216-THA-102B-1 Location: Plaster Base Coat / 2nd Floor Dining Room	208123751-10	No	NAD (by NYS ELAP 198.1) by Karol H. Lu on 12/30/08
Analyst Description: Grey, Homogeneous, Non-Fibrous, Cementitious, Bulk Material Asbestos Types: Other Material: Non-fibrous 100 %			
1216-THA-102B-2 Location: Plaster Base Coat / 2nd Floor Dining Room	208123751-11	No	NAD (by NYS ELAP 198.1) by Karol H. Lu on 12/30/08
Analyst Description: Grey, Homogeneous, Non-Fibrous, Cementitious, Bulk Material Asbestos Types: Other Material: Non-fibrous 100 %			

See Reporting notes on last page

Received Time Dec. 30. 2008 2:02PM No. 2621

Client Name: Sienna Environmental Technologies, LLC

## PLM Bulk Asbestos Report

SET 954; C&S Engineers; Thatcher Hall, SUNY Potsdam

Client No. / HGA	Lab No.	Asbestos Present	Total % Asbestos
1216-THA-102B-3 Location: Plaster Base Coat / 2nd Floor Dining Room	208123751-12	No	NAD (by NYS ELAP 198.1) by Karol H. Lu on 12/30/08
Analyst Description: Grey, Homogeneous, Non-Fibrous, Cementitious, Bulk Material Asbestos Types: Other Material: Non-fibrous 100 %			
1216-THA-200-1 Location: 1x1 Fissure Ceiling Tile / Dining Room	208123751-13	No	NAD (by NYS ELAP 198.1) by Karol H. Lu on 12/30/08
Analyst Description: Grey, Homogeneous, Fibrous, Bulk Material Asbestos Types: Other Material: Cellulose 20 %, Fibrous glass 50 %, Non-fibrous 30 %			
1216-THA-200-2 Location: 1x1 Fissure Ceiling Tile / Dining Room	208123751-14	No	NAD (by NYS ELAP 198.1) by Karol H. Lu on 12/30/08
Analyst Description: Beige, Homogeneous, Fibrous, Bulk Material Asbestos Types: Other Material: Cellulose 20 %, Fibrous glass 50 %, Non-fibrous 30 %			
1216-THA-201-1 Location: 2x2 Gypsum Ceiling Tile / Kitchen	208123751-15	No	NAD (by NYS ELAP 198.1) by Karol H. Lu on 12/30/08
Analyst Description: White, Homogeneous, Fibrous, Bulk Material Asbestos Types: Other Material: Cellulose 10 %, Fibrous glass Trace, Non-fibrous 90 %			
1216-THA-201-2 Location: 2x2 Gypsum Ceiling Tile / Kitchen	208123751-16	No	NAD (by NYS ELAP 198.1) by Karol H. Lu on 12/30/08
Analyst Description: White, Homogeneous, Fibrous, Bulk Material Asbestos Types: Other Material: Cellulose 10 %, Fibrous glass Trace, Non-fibrous 90 %			

See Reporting notes on last page


Received Time Dec. 30. 2008 2:02PM No. 2621

## PLM Bulk Asbestos Report

SET 954; C&S Engineers; Thatcher Hall, SUNY Potsdam

---

Reporting Notes:

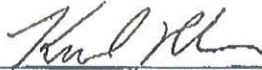Analyzed by: Karol H. Lu 

\*NAD/NSD =no asbestos detected; NA =not analyzed; NA/PS=not analyzed/positive stop; PLM Bulk Asbestos Analysis by EPA 600/M4-82-020 per 40 CFR 763 (NVLAP Lab Code 200546-0), ELAP PLM Method 198.1 for NY friable samples or 198.6 for NOB samples (NY ELAP Lab ID11480);

Note:PLM is not consistently reliable in detecting asbestos in floor coverings and similar non-friable organically bound materials. NAD or Trace results by PLM are inconclusive, TEM is currently the only method that can be used to determine if this material can be considered or treated as non asbestos-containing in NY State (also see EPA Advisory for floor tile,FR 59,146,36970,8/1/94). National Institute of Standards and Technology Accreditation requirements mandate that this report must not be reproduced except in full without the approval of the lab. This PLM report relates ONLY to the items tested. AIHA Lab # 102843.

Reviewed By: \_\_\_\_\_

END OF REPORT \_\_\_\_\_

# SIENNA ENVIRONMENTAL TECHNOLOGIES, LLC

429 Franklin Street, Suite 102  
Buffalo, NY 14202

Phone 716-332-3134  
Fax 716-332-3136

## Chain of Custody Document

ix Report to: \_\_\_\_\_

Client/Contact: <u>C &amp; S Engineers, Jeffrey Robbins</u>	Turn around (circle) RUSH 48 Hour <u>24 Hour</u> 72 Hour
Building/Location: <u>Thatcher Hall, SUNY Potsdam</u>	
Job #: <u>SET954</u> Total # Samples: <u>16</u> <u>208128751</u>	

PLM     TEM     AAS     OTHER

Sample #	Description of Sample	Location of Sample	Notes
1216-THA-100-1	Cinder block mortar	1st floor mechanical	-1
1216-THA-100-2	Cinder block mortar	1st floor mechanical	-2
1216-THA-101A-1	Grout of ceramic tile	Kitchen	-3
1216-THA-101A-2	Grout of ceramic tile	Kitchen	-4
1216-THA-101B-1	Thinset of ceramic tile	Kitchen	-5
1216-THA-101B-2	Thinset of ceramic tile	Kitchen	-6
1216-THA-102A-1	Plaster stem coat	2nd floor dining room	-7
1216-THA-102A-2	Plaster stem coat	2nd floor dining room	-8
1216-THA-102A-3	Plaster stem coat	2nd floor dining room	-9
1216-THA-102B-1	Plaster base coat	2nd floor dining room	-10
1216-THA-102B-2	Plaster base coat	2nd floor dining room	-11
1216-THA-102B-3	Plaster base coat	2nd floor dining room	-12
1216-THA-200-1	1x1 fissure ceiling tile	Dining room	-13
1216-THA-200-2	1x1 fissure ceiling tile	Dining room	-14
1216-THA-201-1	2x2 Gypsum ceiling tile	Kitchen	-15
1216-THA-201-2	2x2 Gypsum ceiling tile	Kitchen	-16

Notes: Page 1 of 1

Sienna Environmental Technologies  
 Accept  
 Reject

Sampled By: Paul J. Manning Date: 12/16/08

Relinquished By: Paul J. Manning Date: \_\_\_\_\_

Received By: Paul J. Manning Date: 12/30/08

Received Time: Dec. 30, 2008 2:02PM No. 2621 0940



# SIENNA ENVIRONMENTAL TECHNOLOGIES, LLC

429 Franklin St. · Suite 102 · Buffalo, NY 14202 · Ph: 716-332-3134 · Fax: 716-332-3136

## LABORATORY REPORT

Attn: Jeffrey Robbins  
C & S Engineers  
499 Col. Eileen Collins Blvd  
Syracuse, NY 13212

Date Received: 12/18/2008

Date Analyzed: 12/29/2008

Sienna ID: P153

Phone: 315-455-2000

Fax: 315-455-9667

Project: SET954 Dunn Hall

### Polarized Light Microscopy (PLM) by NY State ELAP Method 198.1

Sample	Description	Location	% Fibrous	% Non-Fibrous	% Asbestos Type
1216-DUN-100A-1 P153-1	Gray, Fibrous, Non-Homogenous	Drywall - 1st Floor Hall	0%	100%	NAD
1216-DUN-100A-2 P153-2	Gray, Fibrous, Non-Homogenous	Drywall - Room 110	0%	100%	NAD
1216-DUN-100B-1 P153-3	Gray, Non-Fibrous, Homogenous	Joint Compound - 1st Floor Hall	0%	100%	NAD
1216-DUN-100B-2 P153-4	Gray, Non-Fibrous, Homogenous	Joint Compound - Room 110	0%	100%	NAD
1216-DUN-101-1 P153-5	Gray, Non-Fibrous, Homogenous	Glazed Block Mortar - 1st Floor Hall	0%	100%	NAD
1216-DUN-101-2 P153-6	Gray, Non-Fibrous, Homogenous	Glazed Block Mortar - 1st Floor Hall	0%	100%	NAD
1216-DUN-200-1 P153-7	Gray, Fibrous, Homogenous	2'x2' Dot Ceiling Tile - Room 101C	70%	30%	NAD
1216-DUN-200-2 P153-8	White, Fibrous, Homogenous	2'x2' Dot Ceiling Tile - Room 101C	60%	40%	NAD
1216-DUN-201A-1 P153-9	Yellow, Fibrous, Non-Homogenous	1'x1' Dot Ceiling Tile - 1st Floor Hall	25%	75%	NAD
1216-DUN-201A-2 P153-10	Yellow, Fibrous, Non-Homogenous	1'x1' Dot Ceiling Tile - 1st Floor Hall	25%	75%	NAD
1216-DUN-202-1 P153-13	Brown, Fibrous, Non-Homogenous	2'x2' Large Dot Ceiling Tile - 1st Floor Dance Studio	20%	80%	NAD
1216-DUN-202-2 P153-14	Brown, Fibrous, Non-Homogenous	2'x2' Large Dot Ceiling Tile - 1st Floor Dance Studio	10%	90%	NAD
1216-DUN-203A-1 P153-15	White, Non-Fibrous, Homogenous	Plaster Skim Coat - 1st Floor Dance Studio	0%	100%	NAD

Tracy Skalski  
Analyst(s)

  
Approved Signatory

Disclaimers: NAD = No asbestos detected. Results relate only to samples provided by client. This report shall not be reproduced, except in full, without written approval by Sienna. Samples analyzed as NAD or Trace (<1%) cannot be guaranteed. Quantitative transmission electron microscopy is currently the only reliable method that can be used to determine if this material can be considered or treated as non-asbestos containing. Analysis performed by Sienna Environmental Technologies, NY ELAP #11727.



# SIENNA ENVIRONMENTAL TECHNOLOGIES, LLC

429 Franklin St. · Suite 102 · Buffalo, NY 14202 · Ph: 716-332-3134 · Fax: 716-332-3136

## LABORATORY REPORT

Attn: Jeffrey Robbins  
C & S Engineers  
499 Col. Eileen Collins Blvd  
Syracuse, NY 13212

Date Received: 12/18/2008

Date Analyzed: 12/29/2008

Sienna ID: P153

Phone: 315-455-2000

Fax: 315-455-9667

Project: SET954 Dunn Hall

### Polarized Light Microscopy (PLM) by NY State ELAP Method 198.1

Sample	Description	Location	% Fibrous	% Non-Fibrous	% Asbestos Type
1216-DUN-203A-2 P153-16	White, Non-Fibrous, Homogenous	Plaster Skim Coat - Room 110	0%	100%	NAD
1216-DUN-203A-3 P153-17	White, Non-Fibrous, Homogenous	Plaster Skim Coat - 3rd Floor Custodial Room	0%	100%	NAD
1216-DUN-203B-1 P153-18	Gray, Non-Fibrous, Homogenous	Plaster Base Coat - 1st Floor Dance Studio	0%	100%	NAD
1216-DUN-203B-2 P153-19	Gray, Non-Fibrous, Homogenous	Plaster Base Coat - Room 110	0%	100%	NAD
1216-DUN-203B-3 P153-20	Gray, Non-Fibrous, Homogenous	Plaster Base Coat - 3rd Floor Custodial Room	0%	100%	NAD
1216-DUN-204-1 P153-21	White, Non-Fibrous, Homogenous	Textured Finish - Room 329	0%	100%	NAD
1216-DUN-204-2 P153-22	White, Non-Fibrous, Homogenous	Textured Finish - Room 329	0%	100%	NAD
1216-DUN-203-3 P153-23	White, Non-Fibrous, Homogenous	Textured Finish - Room 329	0%	100%	NAD
1216-DUN-300-1 P153-24	Gray, Non-Fibrous, Homogenous	Terrazzo - 1st Floor Stairwell	0%	100%	NAD
1216-DUN-300-2 P153-25	Gray, Non-Fibrous, Homogenous	Terrazzo - 1st Floor Stairwell	0%	100%	NAD

Tracy Skalski  
Analyst(s)

Approved Signatory

Disclaimers: NAD = No asbestos detected. Results relate only to samples provided by client. This report shall not be reproduced, except in full, without written approval by Sienna. Samples analyzed as NAD or Trace (<1%) cannot be guaranteed. Quantitative transmission electron microscopy is currently the only reliable method that can be used to determine if this material can be considered or treated as non-asbestos containing. Analysis performed by Sienna Environmental Technologies, NY ELAP #11727.



# SIENNA ENVIRONMENTAL TECHNOLOGIES, LLC

429 Franklin St. · Suite 102 · Buffalo, NY 14202 · Ph: 716-332-3134 · Fax: 716-332-3136

## LABORATORY REPORT

Attn: Jeffrey Robbins  
C & S Engineers  
499 Col. Eileen Collins Blvd  
Syracuse, NY 13212

Date Received: 12/18/2008

Date Analyzed: 12/29/2008

Sienna ID: P153

Phone: 315-455-2000 Fax: 315-455-9667

Project: SET954 Dunn Hall

### Polarized Light Microscopy (PLM) of Non-Friable, Organically Bound Materials by NY State ELAP Method 198.6

Sample	Description	Location	% Fibrous	% Non-Fibrous	% Asbestos Type
1216-DUN-201B-1 P153-11	Brown, Non-Fibrous, Homogenous	Glue of 1'x1' Dot Ceiling Tile - 1st Floor Hall	5%	95%	Inconclusive: No Asbestos Detected
1216-DUN-201B-2 P153-12	Brown, Non-Fibrous, Homogenous	Glue of 1'x1' Dot Ceiling Tile - 1st Floor Hall	5%	95%	Inconclusive: No Asbestos Detected

Tracy Skalski  
Analyst(s)

Approved Signatory

Disclaimer: Polarized Light Microscopy is not consistently reliable in detecting asbestos in floor coverings and similar non-friable, organically-bound materials. Quantitative transmission electron microscopy is currently the only method that can be used to determine if this material can be considered or treated as non-asbestos containing. Results relate only to samples provided by client. This report shall not be reproduced, except in full, without written approval by Sienna. Analysis performed by Sienna Environmental Technologies, NY ELAP #11727.

Table 1

Summary of Bulk Asbestos Analysis Results by NYS ELAP 198.4 NOB Method  
 SET 954; C&S Engineers; Dunn Hall SUNY Potsdam

AmeriSci Sample #	Client Sample#	HG Area	Sample Weight (gram)	Float Sensitive Organic %	Acid Soluble Inorganic %	Insoluble Non-Asbestos Inorganic %	** Asbestos % by TEM
01	1216-DUN-201B-1		0.237	47.3	8.9	43.9	NAD
Location: Glue Dob Of 201A / 1st Floor Hall							
02	1216-DUN-201B-2		0.226	48.7	9.3	42.0	NAD
Location: Glue Dob Of 201A / 1st Floor Hall							

Analyzed by: Madeline E. Collins; Date Analyzed 12/30/2008

\*\*Quantitative Analysis (Semi/Full): Bulk Asbestos Analysis - PLM by EPA 600/M4-82-020 per 40 CFR or ELAP 198.1 for New York friable samples or ELAP 198.6 for New York NOB samples; TEM (Semi/Full) by EPA 600/R-93/116 (not covered by NVLAP Bulk accreditation); or ELAP 198.4 for New York samples; NAD = no asbestos detected during a quantitative analysis; NA = not analyzed; Trace = <1%; Quantitation for beginning weights of <0.1 grams should be considered as qualitative only; Qualitative Analysis: Asbestos analysis results of "Present" or "NVA = No Visible Asbestos" represents results for Qualitative PLM or TEM Analysis only (no accreditation coverage available from any regulatory agency for qualitative analyses); AIHA Lab # 102843, NVLAP Lab Code 2000543-0, NYSDOH ELAP LAB ID 11480.

Warning Note: PLM limitation, only TEM will resolve fibers <0.25 micrometers in diameter. TEM bulk analysis is representative of the fine grained matrix material and may not be representative of non-uniformly dispersed debris for which PLM evaluation is recommended (i.e. soils and other heterogeneous materials).

Reviewed By: \_\_\_\_\_



# SIENNA ENVIRONMENTAL TECHNOLOGIES, LLC

429 Franklin Street, Suite 102  
Buffalo, NY 14202

Phone 716-332-3134  
Fax 716-332-3136

## Chain of Custody Document

Report to: \_\_\_\_\_

Client/Contact: <u>C &amp; S Engineers, Jeffrey Robbins</u>	Turn around (circle) RUSH 48 Hour 24 Hour 72 Hour
Building/Location: <u>Dunn Hall, SUNY Potsdam</u>	
Job #: <u>SET954</u> Total # Samples: <u>25</u>	

PLM  TEM  AAS  OTHER \_\_\_\_\_

Sample #	Description of Sample	Location of Sample	Notes
1216-DUN-100A-1	Drywall	1st floor hall	P153-1
1216-DUN-100A-2	Drywall	Room 110	1-2
1216-DUN-100B-1	Joint compound	1st floor hall	-3
1216-DUN-100B-2	Joint compound	Room 110	-4
1216-DUN-101-1	Glazed block mortar	1st floor hall	-5
1216-DUN-101-2	Glazed block mortar	1st floor hall	-6
1216-DUN-200-1	2x2 dot ceiling tile	Room 101C	-7
1216-DUN-200-2	2x2 dot ceiling tile	Room 101C	-8
1216-DUN-201A-1	1x1 dot ceiling tile	1st floor hall	-9
1216-DUN-201A-2	1x1 dot ceiling tile	1st floor hall	-10
1216-DUN-201B-1	Glue dob of 201A	1st floor hall	-11
1216-DUN-201B-2	Glue dob of 201A	1st floor hall	-12
1216-DUN-202-1	2x2 large dot ceiling tile	1st floor dance studio	-13
1216-DUN-202-2	2x2 large dot ceiling tile	1st floor dance studio	-14
1216-DUN-203A-1	Plaster skim coat	1st floor dance studio	-15
1216-DUN-203A-2	Plaster skim coat	Room 110	P153-16

Notes: Page 1 of 2

Sienna Environmental Technologies  Neg. NUBs by PLM  
 Accept to TEM  
 Reject

Sampled By: Paul J. Mair Date: 12/16/08

Relinquished By: Paul J. Mair Date: \_\_\_\_\_

Received By: Mary G. Kowalski 1500 P153 Date: 12/18/08

# SIENNA ENVIRONMENTAL TECHNOLOGIES, LLC

429 Franklin Street, Suite 102  
Buffalo, NY 14202

Phone 716-332-3134  
Fax 716-332-3136

## Chain of Custody Document

ix Report to: \_\_\_\_\_

Client/Contact: <u>C &amp; S Engineers, Jeffrey Robbins</u>	Turn around (circle) RUSH 48 Hour 24 Hour 72 Hour
Building/Location: <u>Dunn Hall, SUNY Potsdam</u>	
Job #: <u>SET954</u> Total # Samples: <u>25</u>	

PLM  TEM  AAS  OTHER

Sample #	Description of Sample	Location of Sample	Notes
1216-DUN-203A-3	Plaster skim coat	3rd floor custodial	P153-17
1216-DUN-203B-1	Plaster base coat	1st floor dance studio	-18
1216-DUN-203B-2	Plaster base coat	Room 110	-19
1216-DUN-203B-3	Plaster base coat	3rd floor custodial	-20
1216-DUN-204-1	Textured finish	Room 329	-21
1216-DUN-204-2	Textured finish	Room 329	-22
1216-DUN-204-3	Textured finish	Room 329	-23
1216-DUN-300-1	Terrazzo	1st floor stairwell	-24
1216-DUN-300-2	Terrazzo	1st floor stairwell	P153-25

Sienna Environmental  
Technologies  
 Accept  
 Reject

Notes: Page 2 of 2 \* Neg. NOBS by PLM to TEM

Sampled By: Paul J. Maury Date: 12/16/08  
 Relinquished By: Paul J. Maury Date: \_\_\_\_\_  
 Received By: J. Steele 1500 P153 Date: 12/18/08

## PLM Bulk Asbestos Report

Sienna Environmental Technologies, LL Attn: Suzanne Kelley 429 Franklin Street Suite 102  Buffalo, NY 14202	<b>Date Received</b> 12/30/08 <b>Date Examined</b> 12/30/08 <b>ELAP #</b> 11480 <b>RE: SET 954; C&amp;S Engineers;</b> 12/30/2008)	<b>AmeriSci Job #</b> 208123749 <b>P.O. #</b> <b>Page</b> 1 of 4 <b>Sissin Hall</b> (Report Amended)
---	---	---

Client No. / HGA	Lab No.	Asbestos Present	Total % Asbestos
1216-SIS-100A-1 Location: Plaster Skim Coat / Basement	208123749-01	No	NAD (by NYS ELAP 198.1) by Albert Grohmann on 12/30/08
Analyst Description: OffWhite, Homogeneous, Non-Fibrous, Cementitious, Bulk Material Asbestos Types: Other Material: Cellulose Trace, Non-fibrous 100 %			
1216-SIS-100A-2 Location: Plaster Skim Coat / Rm 343	208123749-02	No	NAD (by NYS ELAP 198.1) by Albert Grohmann on 12/30/08
Analyst Description: White, Homogeneous, Non-Fibrous, Bulk Material Asbestos Types: Other Material: Cellulose Trace, Non-fibrous 100 %			
1216-SIS-100A-3 Location: Plaster Skim Coat / 2nd Fl Stairwell	208123749-03	No	NAD (by NYS ELAP 198.1) by Albert Grohmann on 12/30/08
Analyst Description: White, Homogeneous, Non-Fibrous, Bulk Material Asbestos Types: Other Material: Cellulose Trace, Non-fibrous 100 %			
1216-SIS-100B-1 Location: Plaster Base Coat / Basement	208123749-04	No	NAD (by NYS ELAP 198.1) by Albert Grohmann on 12/30/08
Analyst Description: Grey, Homogeneous, Non-Fibrous, Cementitious, Bulk Material Asbestos Types: Other Material: Cellulose Trace, Non-fibrous 100 %			
1216-SIS-100B-2 Location: Plaster Base Coat / Rm 343	208123749-05	No	NAD (by NYS ELAP 198.1) by Albert Grohmann on 12/30/08
Analyst Description: Grey, Homogeneous, Non-Fibrous, Cementitious, Bulk Material Asbestos Types: Other Material: Cellulose Trace, Non-fibrous 100 %			

See Reporting notes on last page

Received Time Dec. 30. 2008 2:44PM No. 2629

**PLM Bulk Asbestos Report**SET 954; C&S Engineers; Sissin Hall (Report Amended  
12/30/2008)

Client No. / HGA	Lab No.	Asbestos Present	Total % Asbestos
1216-SIS-100B-3 Location: Plaster Base Coat / 2nd Fl, Stairwell	208123749-06	No	NAD (by NYS ELAP 198.1) by Albert Grohmann on 12/30/08
Analyst Description: Grey, Homogeneous, Non-Fibrous, Cementitious, Bulk Material Asbestos Types: Other Material: Cellulose Trace, Non-fibrous 100 %			
1216-SIS-101-1 Location: Lightweight Concrete / 3rd Fl Hall	208123749-07	No	NAD (by NYS ELAP 198.1) by Albert Grohmann on 12/30/08
Analyst Description: Grey, Homogeneous, Non-Fibrous, Cementitious, Bulk Material Asbestos Types: Other Material: Cellulose Trace, Non-fibrous 100 %			
1216-SIS-101-2 Location: Lightweight Concrete / 2nd Fl Hall	208123749-08	No	NAD (by NYS ELAP 198.1) by Albert Grohmann on 12/30/08
Analyst Description: Grey, Homogeneous, Non-Fibrous, Bulk Material Asbestos Types: Other Material: Cellulose Trace, Non-fibrous 100 %			
1216-SIS-200-1 Location: Insulation Material / Basement	208123749-09	Yes	Trace (<1 %) (by NYS ELAP 198.1) by Albert Grohmann on 12/30/08
Analyst Description: OffWhite, Homogeneous, Non-Fibrous, Cementitious, Bulk Material Asbestos Types: Chrysotile <1 % pc Other Material: Cellulose Trace, Fibrous glass Trace, Non-fibrous 100 %			
1216-SIS-200-2 Location: Insulation Material / Basement	208123749-10L1	Yes	Trace (<1 %) (by NYS ELAP 198.1) by Albert Grohmann on 12/30/08
Analyst Description: OffWhite, Homogeneous, Non-Fibrous, Cementitious, Bulk Material Asbestos Types: Chrysotile <1 % pc Other Material: Cellulose Trace, Fibrous glass Trace, Non-fibrous 100 %			
1216-SIS-200-2 Location: Insulation Material / Basement - Mastic material	208123749-10L2	No	NAD (by NYS ELAP 198.1) by Albert Grohmann on 12/30/08
Analyst Description: Black, Homogeneous, Non-Fibrous, Bulk Material Asbestos Types: Other Material: Cellulose Trace, Fibrous glass Trace, Non-fibrous 100 %			

See Reporting notes on last page

Received Time Dec. 30. 2008 2:44PM No. 2629

**PLM Bulk Asbestos Report**SET 954; C&S Engineers; **Sissin Hall** (Report Amended  
12/30/2008)

Client No. / HGA	Lab No.	Asbestos Present	Total % Asbestos
1216-SIS-200-3 Location: Insulation Material / Basement	208123749-11L1	<b>Yes</b>	<b>Trace (&lt;1 %)</b> (by NYS ELAP 198.1) by Albert Grohmann on 12/30/08
Analyst Description: OffWhite, Homogeneous, Non-Fibrous, Cementitious, Bulk Material Asbestos Types: Chrysotile <1 % pc Other Material: Cellulose Trace, Fibrous glass Trace, Non-fibrous 100 %			
1216-SIS-200-3 Location: Insulation Material / Basement - Mastlo material	208123749-11L2	<b>No</b>	<b>NAD</b> (by NYS ELAP 198.1) by Albert Grohmann on 12/30/08
Analyst Description: Black, Homogeneous, Non-Fibrous, Bulk Material Asbestos Types: Other Material: Cellulose Trace, Fibrous glass Trace, Non-fibrous 100 %			
1216-SIS-201A-1 Location: 1x1 Texture CT / 3rd Fl Hall	208123749-12	<b>Yes</b>	<b>Trace (&lt;1 %)</b> (by NYS ELAP 198.1) by Albert Grohmann on 12/30/08
Analyst Description: OffWhite, Homogeneous, Fibrous, Bulk Material Asbestos Types: Chrysotile <1 % pc Other Material: Cellulose Trace, Fibrous glass 85 %, Non-fibrous 15 %			
1216-SIS-201A-2 Location: 1x1 Texture CT / 2nd Fl Hall	208123749-13	<b>Yes</b>	<b>Trace (&lt;1 %)</b> (by NYS ELAP 198.1) by Albert Grohmann on 12/30/08
Analyst Description: Grey, Homogeneous, Fibrous, Bulk Material Asbestos Types: Chrysotile <1 % pc Other Material: Cellulose Trace, Fibrous glass 85 %, Non-fibrous 15 %			
1216-SIS-202-1 Location: 2x2 DOT CT / Rm 142	208123749-14	<b>No</b>	<b>NAD</b> (by NYS ELAP 198.1) by Albert Grohmann on 12/30/08
Analyst Description: White/Grey, Homogeneous, Fibrous, Bulk Material Asbestos Types: Other Material: Cellulose 45 %, Fibrous glass 40 %, Non-fibrous 15 %			
1216-SIS-202-2 Location: 2x2 Dot CT / Rm 142	208123749-15	<b>No</b>	<b>NAD</b> (by NYS ELAP 198.1) by Albert Grohmann on 12/30/08
Analyst Description: White/Grey, Homogeneous, Fibrous, Bulk Material Asbestos Types: Other Material: Cellulose 45 %, Fibrous glass 40 %, Non-fibrous 15 %			

See Reporting notes on last page

Received Time Dec. 30, 2008 2:44PM No. 2629

**PLM Bulk Asbestos Report**SET 964; C&S Engineers; Sissin Hall (Report Amended  
12/30/2008)

Client No. / HGA	Lab No.	Asbestos Present	Total % Asbestos
1216-SIS-203-1 Location: Textured Ceiling / Rm 5125	208123749-16	No	NAD (by NYS ELAP 198.1) by Albert Grohmann on 12/30/08
Analyst Description: White, Homogeneous, Non-Fibrous, Bulk Material Asbestos Types: Other Material: Non-fibrous 100 %			
1216-SIS-203-2 Location: Textured Ceiling / Rm 5125	208123749-17	No	NAD (by NYS ELAP 198.1) by Albert Grohmann on 12/30/08
Analyst Description: White, Homogeneous, Non-Fibrous, Bulk Material Asbestos Types: Other Material: Non-fibrous 100 %			
1216-SIS-203-3 Location: Textured Ceiling / Rm 5125	208123749-18	No	NAD (by NYS ELAP 198.1) by Albert Grohmann on 12/30/08
Analyst Description: White, Homogeneous, Non-Fibrous, Bulk Material Asbestos Types: Other Material: Non-fibrous 100 %			

**Reporting Notes:**

Analyzed by: Albert Grohmann

\*NAD/NSD =no asbestos detected; NA =not analyzed; NA/PS=not analyzed/positive stop; PLM Bulk Asbestos Analysis by EPA 600/M4-82-020 per 40 CFR 763 (NVLAP Lab Code 200546-0), ELAP PLM Method 198.1 for NY friable samples or 198.6 for NOR samples (NY ELAP Lab ID11480);

Note:PLM is not consistently reliable in detecting asbestos in floor coverings and similar non-friable organically bound materials, NAD or Trace results by PLM are inconclusive, TEM is currently the only method that can be used to determine if this material can be considered or treated as non asbestos-containing in NY State (also see EPA Advisory for floor tile,FR 59,146,38970,8/1/94). National Institute of Standards and Technology Accreditation requirements mandate that this report must not be reproduced except in full without the approval of the lab. This PLM report relates ONLY to the items tested. AIHA Lab # 102843.

Reviewed By: \_\_\_\_\_

\_\_\_\_\_ END OF REPORT \_\_\_\_\_

Received Time Dec. 30. 2008 2:44PM No. 2629



# SIENNA ENVIRONMENTAL TECHNOLOGIES, LLC

429 Franklin St. · Suite 102 · Buffalo, NY 14202 · Ph: 716-332-3134 · Fax: 716-332-3136

## LABORATORY REPORT

Attn: Jeffrey Robbins  
C & S Engineers  
499 Col. Eileen Collins Blvd  
Syracuse, NY 13212

Date Received: 12/30/2008

Date Analyzed: 12/31/2008

Sienna ID: P160

Phone: 315-455-2000 Fax: 315-455-9667

Project: SET954 **Slisson Hall**

### Polarized Light Microscopy (PLM) by NY State ELAP Method 198.1

Sample	Description	Location	% Fibrous	% Non-Fibrous	% Asbestos Type
1216-SIS-102-1 P160-9	White, Fibrous, Homogenous	Wallpaper - 3rd Floor Hall	5%	95%	NAD
1216-SIS-102-2 P160-10	White, Fibrous, Homogenous	Wallpaper - 2nd Floor Hall	5%	95%	NAD

Tracy Skalski  
Analyst(s)

Approved Signatory

Disclaimers: NAD = No asbestos detected. Results relate only to samples provided by client. This report shall not be reproduced, except in full, without written approval by Sienna. Samples analyzed as NAD or Trace (<1%) cannot be guaranteed. Quantitative transmission electron microscopy is currently the only reliable method that can be used to determine if this material can be considered or treated as non-asbestos containing. Analysis performed by Sienna Environmental Technologies, NY ELAP #11727.



# SIENNA ENVIRONMENTAL TECHNOLOGIES, LLC

429 Franklin St. · Suite 102 · Buffalo, NY 14202 · Ph: 716-332-3134 · Fax: 716-332-3136

## LABORATORY REPORT

Attn: Jeffrey Robbins  
C & S Engineers  
499 Col. Eileen Collins Blvd  
Syracuse, NY 13212

Date Received: 12/30/2008

Date Analyzed: 12/31/2008

Sienna ID: P160

Phone: 315-455-2000 Fax: 315-455-9667

Project: SET954 **Slisson Hall**

### Polarized Light Microscopy (PLM) of Non-Friable, Organically Bound Materials by NY State ELAP Method 198.6

Sample	Description	Location	% Fibrous	% Non-Fibrous	% Asbestos Type
1216-SIS-201B-1 P160-16	Brown, Non-Fibrous, Homogenous	Glue Daubs of 201A - 2nd Floor Hall	0%	100%	Inconclusive: No Asbestos Detected
1216-SIS-201B-2 P160-17	Brown, Non-Fibrous, Homogenous	Glue Daubs of 201A - 2nd Floor Hall	0%	100%	Inconclusive: No Asbestos Detected

Tracy Skalski  
Analyst(s)

Approved Signatory

Disclaimers: Polarized Light Microscopy is not consistently reliable in detecting asbestos in floor coverings and similar non-friable, organically-bound materials. Quantitative transmission electron microscopy is currently the only method that can be used to determine if this material can be considered or treated as non-asbestos containing. Results relate only to samples provided by client. This report shall not be reproduced, except in full, without written approval by Sienna. Analysis performed by Sienna Environmental Technologies, NY ELAP #11727.



Table I  
 Summary of Bulk Asbestos Analysis Results by NYS ELAP 198.4 NOB Method  
 SET 954; C&S Engineers; Sisson Hall

AmeriSci Sample #	Client Sample#	HG Area	Sample Weight (gram)	Heat Sensitive Organic %	Acid Soluble Inorganic %	Insoluble Non-Asbestos Inorganic %	** Asbestos % by TEM
01	1216-SIS-201B-1		0.318	53.5	11.3	35.2	NAD
	Location: Glue Dawks Of 201A / 2nd Fl Hall						
02	1216-SIS-201B-2		0.256	52.3	16.4	31.3	NAD
	Location: Glue Dawks Of 201A / 2nd Fl Hall						

Analyzed by: Madell E. Collins; Data Analyzed 12/30/2008  
 \*\*Quantitative Analysis (Semi/Full): Bulk Asbestos Analysis - PLM by EPA 600/4-92-020 per 40 CFR or ELAP 198.1 for New York, friable samples or ELAP 198.6 for New York NOB samples; TEM (Semi/Full) by EPA 600/R-93/116 (not covered by NYS ELAP Bulk accreditation); or ELAP 198.4 for New York samples; NAD = no asbestos detected during a quantitative analysis; NA = not analyzed; Trace = <1%; Quantitative for beginning weights of <0.1 grams should be considered as qualitative only; Qualitative Analysis: Asbestos analysis results of "Present" or "NVA = No Visible Asbestos" represents results for Qualitative PLM or TEM Analysis only (no accreditation coverage available from any regulatory agency for qualitative analyses); AHA Lab # 102843, NVLAP Lab Code 200546-0, NYSDOH ELAP LAB ID 11480.

Warning Note: PLM limitation, only TEM will resolve fibers <0.25 micrometers in diameter. TEM bulk analysis is representative of the fine grained matrix material and may not be representative of non-uniformly dispersed debris for which PLM evaluation is recommended (i.e. soils and other heterogeneous materials).

Reviewed By: \_\_\_\_\_

# SIENNA ENVIRONMENTAL TECHNOLOGIES, LLC

429 Franklin Street, Suite 102  
Buffalo, NY 14202

Phone 716-332-3134  
Fax 716-332-3136

## Chain of Custody Document

Report to: \_\_\_\_\_

Client/Contact: <u>C.T.S Engineers - Jeffrey Robbins</u>		Turn around (circle)  RUSH 48 Hour <u>24 Hour</u> 72 Hour
Building/Location: <u>SISSON HALL</u> <u>208123749</u>		
Job #: <u>SET954</u>	Total # Samples: <u>22</u>	

PLM     TEM     AAS     OTHER

Sample #	Description of Sample	Location of Sample	Notes
1216-SIS-100A-1	Plaster skim coat	Basement	-1
1216-SIS-100A-2	Plaster skim coat	Rm 343	-2
1216-SIS-100A-3	Plaster skim coat	2nd fl. stairwell	-3
1216-SIS-100B-1	Plaster base coat	Basement	-4
1216-SIS-100B-2	Plaster base coat	Rm 343	-5
1216-SIS-100B-3	Plaster base coat	2nd fl. stairwell	-6
1216-SIS-101-1	lightweight concrete	3rd fl. hall	-7
1216-SIS-101-2	lightweight concrete	2nd fl. hall	-8
1216-SIS-102-1	wallpaper	3rd fl. hall	-9
1216-SIS-102-2	wallpaper	2nd fl. hall	-10
1216-SIS-200-1	Insulation material	Basement	-11
1216-SIS-200-2	Insulation material	Basement	-12
1216-SIS-200-3	Insulation material	Basement	-13
1216-SIS-201A-1	1x1 texture CT	3rd fl. hall	-14
1216-SIS-201A-2	1x1 texture CT	2nd fl. hall	-15
1216-SIS-201B-1	Glue daubs of 201A	2nd fl. hall	-16

Notes:

PS: 1 of 2

Sienna Environmental  
Technologies  
 Accept  
 Reject

Sampled By: Paul J. M... 12/16/08  
 Relinquished By: Paul J. M... 12/30/08  
 Received By: Paul J. M... 12/30/08  
 Received Time: Dec. 30, 2008 2:44PM No. 26295

# SIENNA ENVIRONMENTAL TECHNOLOGIES, LLC

429 Franklin Street, Suite 102  
Buffalo, NY 14202

Phone 716-332-3134  
Fax 716-332-3136

## Chain of Custody Document

Report to: \_\_\_\_\_

Client/Contact: <u>C/S Engineers - Jeffrey Robbins</u>		Turn around (circle)
Building/Location: <u>SISSON HALL</u> <u>208123749</u>		
Job #: <u>SET954</u>	Total # Samples: <u>22</u>	<input type="checkbox"/> RUSH 48 Hour <input checked="" type="checkbox"/> 24 Hour <input type="checkbox"/> 72 Hour

PLM     TEM     AAS     OTHER

Sample #	Description of Sample	Location of Sample	Notes
1216-SIS-201B-2	Glue daubs of 201A	2nd fl. hall	-17
1216-SIS-202-1	2x2 dot CT	Rm 142	-18
1216-SIS-202-2	2x2 dot CT	Rm 142	-19
1216-SIS-203-1	Textured ceiling	Rm S125	-20
1216-SIS-203-2	Textured ceiling	Rm S125	-21
1216-SIS-203-3	Textured ceiling	Rm S125	-22

Sienna Environmental  
Technologies  
 Accept  
 Reject

Notes: PS 2 of 2

Sampled By: Paul J. Mainz Date: 12/16/08  
 Relinquished By: Paul J. Mainz Date: \_\_\_\_\_  
 Received By: [Signature] Date: 12/30/08  
 Received Time: Dec. 30, 2008 2:44PM No. 26295



# SIENNA ENVIRONMENTAL TECHNOLOGIES, LLC

429 Franklin St. · Suite 102 · Buffalo, NY 14202 · Ph: 716-332-3134 · Fax: 716-332-3136

## LABORATORY REPORT

Attn: Jeffrey Robbins  
C & S Engineers  
499 Col. Eileen Collins Blvd  
Syracuse, NY 13212

Date Received: 12/18/2008  
Date Analyzed: 12/26/2008  
Sienna ID: P150

Phone: 315-455-2000 Fax: 315-455-9667

Project: SET954 SUNY Potsdam Brainerd Hall

### Polarized Light Microscopy (PLM) by NY State ELAP Method 198.1

Sample	Description	Location	% Fibrous	% Non-Fibrous	% Asbestos Type
1216-BRA-100A-1 P150-1	White, Non-Fibrous, Homogenous	Plaster Skim Coat - 2nd Floor Hall	0%	100%	NAD
1216-BRA-100A-2 P150-2	White, Non-Fibrous, Homogenous	Plaster Skim Coat - 2nd Floor Hall	0%	100%	NAD
1216-BRA-100A-3 P150-3	White, Non-Fibrous, Homogenous	Plaster Skim Coat - 1st Floor Hall	0%	100%	NAD
1216-BRA-202A-1 P150-4	White, Non-Fibrous, Homogenous	Plaster Skim Coat - 2nd Floor Hall	0%	100%	NAD
1216-BRA-202A-2 P150-5	White, Non-Fibrous, Homogenous	Plaster Skim Coat - 1st Floor Hall	0%	100%	NAD
1216-BRA-100B-1 P150-6	Gray, Non-Fibrous, Homogenous	Plaster Base Coat - 2nd Floor Hall	0%	100%	NAD
1216-BRA-100B-2 P150-7	Gray, Non-Fibrous, Homogenous	Plaster Base Coat - 2nd Floor Hall	0%	100%	NAD
1216-BRA-100B-3 P150-8	Gray, Non-Fibrous, Homogenous	Plaster Base Coat - 1st Floor Hall	0%	100%	NAD
1216-BRA-202B-1 P150-9	Gray, Non-Fibrous, Homogenous	Plaster Base Coat - 2nd Floor Hall	0%	100%	NAD
1216-BRA-202B-2 P150-10	Gray, Non-Fibrous, Homogenous	Plaster Base Coat - 1st Floor Hall	0%	100%	NAD
1216-BRA-101-1 P150-11	Gray, Non-Fibrous, Homogenous	Cinder Block Mortar - 1st Floor Hall	0%	100%	NAD
1216-BRA-101-2 P150-12	Gray, Non-Fibrous, Homogenous	Cinder Block Mortar - 1st Floor Electrical Room	5%	95%	NAD
1216-BRA-200-1 P150-13	Brown, Fibrous, Homogenous	2'x4' Dot Ceiling Tile - 2nd Floor Hall	40%	60%	NAD

Tracy Skalski  
Analyst(s)

Approved Signatory

Disclaimers: NAD = No asbestos detected. Results relate only to samples provided by client. This report shall not be reproduced, except in full, without written approval by Sienna. Samples analyzed as NAD or Trace (<1%) cannot be guaranteed. Quantitative transmission electron microscopy is currently the only reliable method that can be used to determine if this material can be considered or treated as non-asbestos containing. Analysis performed by Sienna Environmental Technologies, NY ELAP #11727.



**LABORATORY REPORT**

Attn: Jeffrey Robbins  
 C & S Engineers  
 499 Col. Eileen Collins Blvd  
 Syracuse, NY 13212

Date Received: 12/18/2008  
 Date Analyzed: 12/26/2008  
 Sienna ID: P150

Phone: 315-455-2000 Fax: 315-455-9667

Project: SET954 SUNY Potsdam **Brainerd Hall**

**Polarized Light Microscopy (PLM)  
 by NY State ELAP Method 198.1**

Sample	Description	Location	% Fibrous	% Non-Fibrous	% Asbestos Type
1216-BRA-200-2 P150-14	Brown, Fibrous, Homogenous	2'x4' Dot Ceiling Tile - 2nd Floor Hall	30%	70%	NAD
1216-BRA-201-1 P150-15	White, Fibrous, Homogenous	Popcorn Ceiling Finish - 2nd Floor Art Room	80%	20%	NAD
1216-BRA-201-2 P150-16	White, Fibrous, Homogenous	Popcorn Ceiling Finish - 2nd Floor Art Room	70%	30%	NAD
1216-BRA-201-3 P150-17	White, Fibrous, Homogenous	Popcorn Ceiling Finish - 2nd Floor Art Room	90%	10%	NAD
1216-BRA-203A-1 P150-18	Gray, Non-Fibrous, Homogenous	Drywall - Room 125	5%	95%	NAD
1216-BRA-203A-2 P150-19	Gray, Non-Fibrous, Homogenous	Drywall - Room 125	5%	95%	NAD
1216-BRA-203B-1 P150-20	White, Non-Fibrous, Homogenous	Joint Compound - Room 125	5%	95%	NAD
1216-BRA-203B-2 P150-21	White, Non-Fibrous, Homogenous	Joint Compound - Room 125	5%	95%	NAD
1216-BRA-203B-3 P150-22	White, Non-Fibrous, Homogenous	Joint Compound - Room 125	0%	100%	NAD
1216-BRA-300-1 P150-23	Gray, Non-Fibrous, Homogenous	Brick Mortar - 2nd Floor Hall	0%	100%	NAD
1216-BRA-300-2 P150-24	Gray, Non-Fibrous, Homogenous	Brick Mortar - 2nd Floor Hall	0%	100%	NAD

Tracy Skalski  
 Analyst(s)

Approved Signatory

Disclaimers: NAD = No asbestos detected. Results relate only to samples provided by client. This report shall not be reproduced, except in full, without written approval by Sienna. Samples analyzed as NAD or Trace (<1%) cannot be guaranteed. Quantitative transmission electron microscopy is currently the only reliable method that can be used to determine if this material can be considered or treated as non-asbestos containing. Analysis performed by Sienna Environmental Technologies, NY ELAP #11727.

# SIENNA ENVIRONMENTAL TECHNOLOGIES, LLC

429 Franklin Street, Suite 102  
Buffalo, NY 14202

Phone 716-332-3134  
Fax 716-332-3136

## Chain of Custody Document

Test Report to: \_\_\_\_\_

Client/Contact: <u>C &amp; S Engineers, Jeffrey Robbins</u>	Turn around (circle) RUSH 48 Hour 24 Hour 72 Hour
Building/Location: <u>Brainerd Hall SUNY Potsdam</u>	
Job #: <u>SET954</u> Total # Samples: <u>24</u>	

PLM     TEM     AAS     OTHER

2150

Sample #	Description of Sample	Location of Sample	Notes
1 1216-BRA-100A-1	Plaster skim coat	2nd floor hall	
2 1216-BRA-100A-2	Plaster skim coat	2nd floor hall	
3 1216-BRA-100A-3	Plaster skim coat	1st floor hall	
4 1216-BRA-202A-1	Plaster skim coat	2nd floor hall	
5 1216-BRA-202A-2	Plaster skim coat	1st floor hall	
6 1216-BRA-100B-1	Plaster base coat	2nd floor hall	
7 1216-BRA-100B-2	Plaster base coat	2nd floor hall	
8 1216-BRA-100B-3	Plaster base coat	1st floor hall	
9 1216-BRA-202B-1	Plaster base coat	2nd floor hall	
10 1216-BRA-202B-2	Plaster base coat	1st floor hall	
11 1216-BRA-101-1	Cinder block mortar	1st floor hall	
12 1216-BRA-101-2	Cinder block mortar	1st floor electrical room	
13 1216-BRA-200-1	2x4 dot ceiling tile	2nd floor hall	
14 1216-BRA-200-2	2x4 dot ceiling tile	2nd floor hall	
15 1216-BRA-201-1	Popcorn ceiling finish	2nd floor art room	
16 1216-BRA-201-2	Popcorn ceiling finish	2nd floor art room	

Notes:

Page 1 of 2

Sienna Environmental  
Technologies

Accept

Reject

Sampled By: Paul T. Manning

Date: 12/16/08

Relinquished By: Paul T. Manning

Date: \_\_\_\_\_

Received By: [Signature]

Date: 12/18/08 1500

DEA

# SIENNA ENVIRONMENTAL TECHNOLOGIES, LLC

429 Franklin Street, Suite 102  
Buffalo, NY 14202

Phone 716-332-3134  
Fax 716-332-3136

## Chain of Custody Document

-ax Report to: \_\_\_\_\_

Client/Contact: <u>C&amp;S Engineers, Jeffrey Robbins</u>	Turn around (circle) RUSH 48 Hour 24 Hour 72 Hour
Building/Location: <u>Brainerd Hall, SUNY Potsdam</u>	
Job #: <u>SET 954</u> Total # Samples: <u>24</u>	

PLM  TEM  AAS  OTHER \_\_\_\_\_

Sample #	Description of Sample	Location of Sample	Notes
17 1216-BRA-201-3	Popcorn ceiling finish	2nd floor art room	
18 1216-BRA-203A-1	Drywall	Room 125	
19 1216-BRA-203A-2	Drywall	Room 125	
20 1216-BRA-203B-1	Joint compound	Room 125	
21 1216-BRA-203B-2	Joint compound	Room 125	
22 1216-BRA-203B-3	Joint compound	Room 125	
23 1216-BRA-300-1	Brick mortar	2nd floor hall	
24 1216-BRA-300-2	Brick mortar	2nd floor hall	

Sienna Environmental Technologies

Notes: Page 2 of 2

Accept  
 Reject

Sampled By: Paul J. Mainz Date: 12/16/08  
 Relinquished By: Paul J. Mainz Date: \_\_\_\_\_  
 Received By: [Signature] Date: 12/18/08 1500  
 (1510)



# SIENNA ENVIRONMENTAL TECHNOLOGIES, LLC

429 Franklin St. · Suite 102 · Buffalo, NY 14202 · Ph: 716-332-3134 · Fax: 716-332-3136

## LABORATORY REPORT

Attn: Jeffrey Robbins  
C & S Engineers  
499 Col. Eileen Collins Blvd  
Syracuse, NY 13212

Date Received: 12/18/2008

Date Analyzed: 12/26/2008

Sienna ID: P149

Phone: 315-455-2000 Fax: 315-455-9667

Project: SET954 Barrington Student Union

### Polarized Light Microscopy (PLM) by NY State ELAP Method 198.1

Sample	Description	Location	% Fibrous	% Non-Fibrous	% Asbestos Type
1216-BAR-100A-1 P149-1	White, Non-Fibrous, Homogenous	Skim Coat Plaster - Mallroom Hall	0%	100%	NAD
1216-BAR-100A-2 P149-2	White, Non-Fibrous, Homogenous	Skim Coat Plaster - Dining Court	0%	100%	NAD
1216-BAR-100A-3 P149-3	White, Non-Fibrous, Homogenous	Skim Coat Plaster - 2nd FI Corridor	0%	100%	NAD
1216-BAR-100A-4 P149-4	White, Non-Fibrous, Homogenous	Skim Coat Plaster - 2nd FI Corridor	0%	100%	NAD
1216-BAR-100A-5 P149-5	White, Non-Fibrous, Homogenous	Skim Coat Plaster - Fireside Lounge	0%	100%	NAD
1216-BAR-100B-1 P149-6	Gray, Non-Fibrous, Homogenous	Base Coat Plaster - Mallroom Hall	0%	100%	NAD
1216-BAR-100B-2 P149-7	Gray, Non-Fibrous, Homogenous	Base Coat Plaster - Dining Court	0%	100%	NAD
1216-BAR-100B-3 P149-8	Gray, Non-Fibrous, Homogenous	Base Coat Plaster - 2nd FI Corridor	0%	100%	NAD
1216-BAR-100B-4 P149-9	Gray, Non-Fibrous, Homogenous	Base Coat Plaster - 2nd FI Corridor	0%	100%	NAD
1216-BAR-100B-5 P149-10	Gray, Non-Fibrous, Homogenous	Base Coat Plaster - Fireside Lounge	0%	100%	NAD
1216-BAR-101A-1 P149-11	Gray, Fibrous, Non- Homogenous	Drywall - Convenience Store	20%	80%	NAD
1216-BAR-101A-2 P149-12	Gray, Fibrous, Homogenous	Drywall - Convenience Store	5%	95%	NAD
1216-BAR-101B-1 P149-13	White, Non-Fibrous, Homogenous	Joint Compound - Convenience Store	0%	100%	NAD

Tracy Skalski  
Analyst(s)

Approved Signatory

Disclaimers: NAD = No asbestos detected. Results relate only to samples provided by client. This report shall not be reproduced, except in full, without written approval by Sienna. Samples analyzed as NAD or Trace (<1%) cannot be guaranteed. Quantitative transmission electron microscopy is currently the only reliable method that can be used to determine if this material can be considered or treated as non-asbestos containing. Analysis performed by Sienna Environmental Technologies, NY ELAP #11727.





# SIENNA ENVIRONMENTAL TECHNOLOGIES, LLC

429 Franklin St. · Suite 102 · Buffalo, NY 14202 · Ph: 716-332-3134 · Fax: 716-332-3136

## LABORATORY REPORT

Attn: Jeffrey Robbins  
C & S Engineers  
499 Col. Eileen Collins Blvd  
Syracuse, NY 13212

Date Received: 12/18/2008  
Date Analyzed: 12/26/2008  
Sienna ID: P149


Phone: 315-455-2000 Fax: 315-455-9667

Project: SET954 Barrington Student Union

### Polarized Light Microscopy (PLM) by NY State ELAP Method 198.1

Sample	Description	Location	% Fibrous	% Non-Fibrous	% Asbestos Type
1216-BAR-101B-2 P149-14	White, Non-Fibrous, Homogenous	Joint Compound - Convenience Store	0%	100%	NAD
1216-BAR-102-1 P149-15	White, Fibrous, Homogenous	Wallpaper - 2nd Fl Rm B	0%	100%	NAD
1216-BAR-102-2 P149-16	White, Fibrous, Homogenous	Wallpaper - 2nd Fl Rm B	0%	100%	NAD
1216-BAR-103-1 P149-17	Gray, Non-Fibrous, Homogenous	Cinder Block Mortar - Attic	5%	95%	NAD
1216-BAR-103-2 P149-18	Gray, Non-Fibrous, Homogenous	Cinder Block Mortar - Attic	0%	100%	NAD
1216-BAR-200-1 P149-19	Gray, Fibrous, Homogenous	2x4 Dot & Fissure CT - Mailroom Corridor	70%	30%	NAD
1216-BAR-200-2 P149-20	Gray, Fibrous, Homogenous	2x4 Dot & Fissure CT - Mailroom Corridor	70%	30%	NAD
1216-BAR-201-1 P149-21	Tan, Fibrous, Homogenous	2x2 Dot & Fissure CT - Bookstore	80%	20%	NAD
1216-BAR-201-2 P149-22	Tan, Fibrous, Homogenous	2x2 Dot & Fissure CT - Bookstore	75%	25%	NAD
1216-BAR-202-1 P149-23	Brown, Fibrous, Non- Homogenous	2x2 Smooth CT - Dining Rm	40%	60%	NAD
1216-BAR-202-2 P149-24	Brown, Fibrous, Homogenous	2x2 Smooth CT - Dining Rm	20%	80%	NAD
1216-BAR-203-1 P149-25	Gray, Fibrous, Homogenous	1x1 Ceiling Tile - Dining Rm	30%	70%	NAD
1216-BAR-203-2 P149-26	Gray, Fibrous, Homogenous	1x1 Ceiling Tile - Dining Rm	70%	30%	NAD

Tracy Skalski  
Analyst(s)

  
Approved Signatory

Disclaimers: NAD = No asbestos detected. Results relate only to samples provided by client. This report shall not be reproduced, except in full, without written approval by Sienna. Samples analyzed as NAD or Trace (<1%) cannot be guaranteed. Quantitative transmission electron microscopy is currently the only reliable method that can be used to determine if this material can be considered or treated as non-asbestos containing. Analysis performed by Sienna Environmental Technologies, NY ELAP #11727.



**LABORATORY REPORT**

Attn: Jeffrey Robbins  
 C & S Engineers  
 499 Col. Eileen Collins Blvd  
 Syracuse, NY 13212  
 Phone: 315-455-2000 Fax: 315-455-9667  
 Project: SET954 Barrington Student Union

Date Received: 12/18/2008  
 Date Analyzed: 12/26/2008  
 Sienna ID: P149

**Polarized Light Microscopy (PLM)  
 by NY State ELAP Method 198.1**

Sample	Description	Location	% Fibrous	% Non-Fibrous	% Asbestos Type
1216-BAR-204-1 P149-27	Tan, Fibrous, Homogenous	Popcorn Ceiling - Fireside Lounge	5%	95%	NAD
1216-BAR-204-2 P149-28	Tan, Fibrous, Homogenous	Popcorn Ceiling - Fireside Lounge	0%	100%	NAD
1216-BAR-204-3 P149-29	Tan, Fibrous, Homogenous	Popcorn Ceiling - Fireside Lounge	0%	100%	NAD

Tracy Skalski  
 Analyst(s)

Approved Signatory

Disclaimers: NAD = No asbestos detected. Results relate only to samples provided by client. This report shall not be reproduced, except in full, without written approval by Sienna. Samples analyzed as NAD or Trace (<1%) cannot be guaranteed. Quantitative transmission electron microscopy is currently the only reliable method that can be used to determine if this material can be considered or treated as non-asbestos containing. Analysis performed by Sienna Environmental Technologies, NY ELAP #11727.

# SIENNA ENVIRONMENTAL TECHNOLOGIES, LLC

429 Franklin Street, Suite 102  
Buffalo, NY 14202

Phone 716-332-3134  
Fax 716-332-3136

## Chain of Custody Document

x Report to: \_\_\_\_\_

Client/Contact: <u>C/S Engineers - Jeffrey Robbins</u>	Turn around (circle) RUSH 48 Hour 24 Hour 72 Hour
Building/Location: <u>BARRINGTON STUDENT UNION</u>	
Job #: <u>SET954</u> Total # Samples: <u>29</u>	

PLM     TEM     AAS     OTHER

Sample #	Description of Sample	Location of Sample	Notes
1	1216-BAR-100A-1 Skim coat plaster	Mailroom Hall	
2	1216-BAR-100A-2 Skim coat plaster	Dining Court	
3	1216-BAR-100A-3 Skim coat plaster	2nd fl. Corridor	
4	1216-BAR-100A-4 Skim coat plaster	2nd fl. Corridor	
5	1216-BAR-100A-5 Skim coat plaster	Fire side Lounge	
6	1216-BAR-100B-1 Base coat plaster	Mailroom Hall	
7	1216-BAR-100B-2 Base coat plaster	Dining Court	
8	1216-BAR-100B-3 Base coat plaster	2nd fl. Corridor	
9	1216-BAR-100B-4 Base coat plaster	2nd fl. Corridor	
10	1216-BAR-100B-5 Base coat plaster	Fire side lounge	
11	1216-BAR-101A-1 Dry wall	Convenience Store	
12	1216-BAR-101A-2 Dry wall	Convenience Store	
13	1216-BAR-101B-1 Joint Compound	Convenience Store	
14	1216-BAR-101B-2 Joint Compound	Convenience Store	
15	1216-BAR-102-1 Wallpaper	2nd fl. Rm B	
16	1216-BAR-102-2 Wallpaper	2nd fl. Rm. B	

Notes:

PS 1 of 2

Environmental Technologies  
 Accept  
 Reject

Sampled By: Paul J. Maney

Date: 12/16/08

Relinquished By: Paul J. Maney

Date: \_\_\_\_\_

Received By: [Signature]

Date: 12/18/08 \$500

P149

# SIENNA ENVIRONMENTAL TECHNOLOGIES, LLC

429 Franklin Street, Suite 102  
Buffalo, NY 14202

Phone 716-332-3134  
Fax 716-332-3136

## Chain of Custody Document

x Report to: \_\_\_\_\_

Client/Contact: <u>C/S Engineers - Jeffrey Robbins</u>	Turn around (circle)  RUSH 48 Hour  24 Hour 72 Hour
Building/Location: <u>BARRINGTON STUDENT UNION</u>	
Job #: <u>SET 954</u> Total # Samples: <u>29</u>	

PLM     TEM     AAS     OTHER

2149

Sample #	Description of Sample	Location of Sample	Notes
17	1216-BAR-103-1 Cinder Block mortar	Attic	
18	1216-BAR-103-2 Cinderblock mortar	Attic	
19	1216-BAR-200-1 2x4 dot & fissure CT	Mailroom corridor	
20	1216-BAR-200-2 2x4 dot & fissure CT	Mailroom corridor	
21	1216-BAR-201-1 2x2 dot & fissure CT	Bookstore	
22	1216-BAR-201-2 2x2 dot & fissure CT	Bookstore	
23	1216-BAR-202-1 2x2 smooth CT	Dining Rm.	
24	1216-BAR-202-2 2x2 smooth CT	Dining Rm.	
25	1216-BAR-203-1 1x1 ceiling tile	Dining Rm.	
26	1216-BAR-203-2 1x1 ceiling tile	Dining Rm.	
27	1216-BAR-204-1 Popcorn Ceiling	Fire side lounge	
28	1216-BAR-204-2 Popcorn ceiling	Fire side lounge	
29	1216-BAR-204-3 Popcorn ceiling	Fire side lounge	

Notes:

PS 20f2

Sienna Environmental Technologies

Accept  
 Reject

sampled By: Paul J. Murray

Date: 12/16/08

Relinquished By: Paul J. Murray

Date:

Received By: \_\_\_\_\_

Date: 12/18/08 1500

2149



# SIENNA ENVIRONMENTAL TECHNOLOGIES, LLC

429 Franklin St. · Suite 102 · Buffalo, NY 14202 · Ph: 716-332-3134 · Fax: 716-332-3136

## LABORATORY REPORT

Attn: Jeffrey Robbins  
C & S Engineers  
499 Col. Eileen Collins Blvd  
Syracuse, NY 13212

Date Received: 12/18/2008

Date Analyzed: 12/31/2008

Sienna ID: P158

Phone: 315-455-2000

Fax: 315-455-9667

Project: SET954 Merritt Hall

### Polarized Light Microscopy (PLM) by NY State ELAP Method 198.1

Sample	Description	Location	% Fibrous	% Non-Fibrous	% Asbestos Type
1217-MER-100A-1 P158-1	Gray, Fibrous, Non-Homogenous	Plaster Skim Coat - Room 129	0%	100%	NAD
1217-MER-100A-2 P158-2	Gray, Non-Fibrous, Homogenous	Plaster Skim Coat - 2nd Floor Hall	0%	100%	NAD
1217-MER-100A-3 P158-3	Gray, Non-Fibrous, Homogenous	Plaster Skim Coat - 3rd Floor Hall	0%	100%	NAD
1217-MER-200A-1 P158-4	White, Non-Fibrous, Homogenous	Plaster Skim Coat - 1st Floor Custodial Room	5%	95%	NAD
1217-MER-200A-2 P158-5	White, Non-Fibrous, Homogenous	Plaster Skim Coat - 1st Floor Hall	0%	100%	NAD
1217-MER-100B-1 P158-6	Gray, Non-Fibrous, Homogenous	Plaster Base Coat - Room 129	0%	100%	NAD
1217-MER-100B-2 P158-7	White, Non-Fibrous, Homogenous	Plaster Base Coat - 2nd Floor Hall	0%	100%	NAD
1217-MER-100B-3 P158-8	Gray, Non-Fibrous, Homogenous	Plaster Base Coat - 3rd Floor Hall	0%	100%	NAD
1217-MER-200B-1 P158-9	Gray, Non-Fibrous, Homogenous	Plaster Base Coat - 1st Floor Custodial Room	0%	100%	NAD
1217-MER-200B-2 P158-10	Gray, Non-Fibrous, Homogenous	Plaster Base Coat - 1st Floor Hall	0%	100%	NAD
1217-MER-101-1 P158-11	Gray, Non-Fibrous, Homogenous	Glazed Block Mortar - Computer Lab	0%	100%	NAD
1217-MER-101-2 P158-12	Gray, Non-Fibrous, Homogenous	Glazed Block Mortar - Room 213 Storage	5%	95%	NAD
1217-MER-102A-1 P158-13	White, Fibrous, Homogenous	Drywall - 2nd Floor Storage	10%	90%	NAD

Tracy Skalski  
Analyst(s)

Approved Signatory

Disclaimers: NAD = No asbestos detected. Results relate only to samples provided by client. This report shall not be reproduced, except in full, without written approval by Sienna. Samples analyzed as NAD or Trace (<1%) cannot be guaranteed. Quantitative transmission electron microscopy is currently the only reliable method that can be used to determine if this material can be considered or treated as non-asbestos containing. Analysis performed by Sienna Environmental Technologies, NY ELAP #11727.



# SIENNA ENVIRONMENTAL TECHNOLOGIES, LLC

429 Franklin St. · Suite 102 · Buffalo, NY 14202 · Ph: 716-332-3134 · Fax: 716-332-3136

## LABORATORY REPORT

Attn: Jeffrey Robbins  
C & S Engineers  
499 Col. Eileen Collins Blvd  
Syracuse, NY 13212

Date Received: 12/18/2008

Date Analyzed: 12/31/2008

Sienna ID: P158

Phone: 315-455-2000

Fax: 315-455-9667

Project: SET954 Merritt Hall

### Polarized Light Microscopy (PLM) by NY State ELAP Method 198.1

Sample	Description	Location	% Fibrous	% Non-Fibrous	% Asbestos Type
1217-MER-102A-2 P158-14	White, Fibrous, Homogenous	Drywall - 2nd Floor Hall	5%	95%	NAD
1217-MER-102B-1 P158-15	White, Fibrous, Homogenous	Joint Compound - 2nd Floor Storage	0%	100%	NAD
1217-MER-102B-2 P158-16	White, Non-Fibrous, Homogenous	Joint Compound - 2nd Floor Hall	0%	100%	NAD
1217-MER-102B-3 P158-17	White, Non-Fibrous, Homogenous	Joint Compound - 2nd Floor Hall	0%	100%	NAD
1217-MER-103A-1 P158-18	White, Non-Fibrous, Homogenous	Grout of Ceramic Tile - Men's Locker Room	0%	100%	NAD
1217-MER-103A-2 P158-19	White, Non-Fibrous, Homogenous	Grout of Ceramic Tile - Men's Locker Room	0%	100%	NAD
1217-MER-103B-1 P158-20	Gray, Non-Fibrous, Homogenous	Thinset of Ceramic Tile - Men's Locker Room	5%	95%	NAD
1217-MER-103B-2 P158-21	Gray, Non-Fibrous, Homogenous	Thinset of Ceramic Tile - Men's Locker Room	0%	100%	NAD
1217-MER-104-1 P158-22	Gray, Non-Fibrous, Homogenous	Cinder Block Mortar - Basement	0%	100%	NAD
1217-MER-104-2 P158-23	Gray, Non-Fibrous, Homogenous	Cinder Block Mortar - Basement	0%	100%	NAD
1217-MER-105-1 P158-24	White, Non-Fibrous, Homogenous	Textured Wall Finish - Room 213 Storage	5%	95%	NAD
1217-MER-105-2 P158-25	White, Non-Fibrous, Homogenous	Textured Wall Finish - Room 213 Storage	5%	95%	NAD
1217-MER-105-3 P158-26	White, Non-Fibrous, Homogenous	Textured Wall Finish - Room 213 Storage	5%	95%	NAD

Tracy Skalski  
Analyst(s)

  
Approved Signatory

Disclaimer: NAD = No asbestos detected. Results relate only to samples provided by client. This report shall not be reproduced, except in full, without written approval by Sienna. Samples analyzed as NAD or Trace (<1%) cannot be guaranteed. Quantitative transmission electron microscopy is currently the only reliable method that can be used to determine if this material can be considered or treated as non-asbestos containing. Analysis performed by Sienna Environmental Technologies, NY ELAP #11727.



# SIENNA ENVIRONMENTAL TECHNOLOGIES, LLC

429 Franklin St. · Suite 102 · Buffalo, NY 14202 · Ph: 716-332-3134 · Fax: 716-332-3136

## LABORATORY REPORT

Attn: Jeffrey Robbins  
C & S Engineers  
499 Col. Eileen Collins Blvd  
Syracuse, NY 13212

Date Received: 12/18/2008

Date Analyzed: 12/31/2008

Sienna ID: P158

Phone: 315-455-2000 Fax: 315-455-9667

Project: SET954 Merritt Hall

### Polarized Light Microscopy (PLM) by NY State ELAP Method 198.1

Sample	Description	Location	% Fibrous	% Non-Fibrous	% Asbestos Type
1217-MER-201A-1 P158-27	Brown / White, Fibrous, Non-Homogenous	1'x1' Dot Ceiling Tile - 1st Floor Hall	10%	90%	NAD
1217-MER-201A-2 P158-28	Brown / White, Fibrous, Non-Homogenous	1'x1' Dot Ceiling Tile - 1st Floor Hall	20%	80%	NAD
1217-MER-202-1 P158-31	Gray, Fibrous, Homogenous	2'x2' Cementitious Tile - Pool	10%	90%	8.2% Chrysotile
1217-MER-202-2 P158-32	Gray, Fibrous, Homogenous	2'x2' Cementitious Tile - Pool <i>ceiling tile</i>	10%	90%	8.2% Chrysotile
1217-MER-203-1 P158-33	Gray / White, Fibrous, Non-Homogenous	2'x4' Dot and Fissure Ceiling Tile - Daycare	50%	50%	NAD
1217-MER-203-2 P158-34	Gray / White, Fibrous, Non-Homogenous	2'x4' Dot and Fissure Ceiling Tile - Daycare	50%	50%	NAD
1217-MER-301-1 P158-39	Brown, Non-Fibrous, Non-Homogenous	Terrazzo - 3rd Floor Hall	0%	100%	NAD
1217-MER-301-2 P158-40	Brown, Non-Fibrous, Non-Homogenous	Terrazzo - 3rd Floor Hall	0%	100%	NAD

Tracy Skalski  
Analyst(s)

Approved Signatory

Disclaimers: NAD = No asbestos detected. Results relate only to samples provided by client. This report shall not be reproduced, except in full, without written approval by Sienna. Samples analyzed as NAD or Trace (<1%) cannot be guaranteed. Quantitative transmission electron microscopy is currently the only reliable method that can be used to determine if this material can be considered or treated as non-asbestos containing. Analysis performed by Sienna Environmental Technologies, NY ELAP #11727.



**LABORATORY REPORT**

Attn: Jeffrey Robbins  
 C & S Engineers  
 499 Col. Eileen Collins Blvd  
 Syracuse, NY 13212

Date Received: 12/18/2008  
 Date Analyzed: 12/31/2008  
 Sienna ID: P158

Phone: 315-455-2000 Fax: 315-455-9667

Project: SET954 Merritt Hall

**Polarized Light Microscopy (PLM)  
 of Non-Friable, Organically Bound Materials by NY State ELAP Method 198.6**

Sample	Description	Location	% Fibrous	% Non-Fibrous	% Asbestos Type
1217-MER-201B-1 P158-29	Brown, Fibrous, Non-Homogenous	Glue of 1'x1' Dot Ceiling Tile - 1st Floor Hall	0%	100%	Inconclusive: No Asbestos Detected
1217-MER-201B-2 P158-30	Brown, Fibrous, Non-Homogenous	Glue of 1'x1' Dot Ceiling Tile - 1st Floor Hall	0%	100%	Inconclusive: No Asbestos Detected
1217-MER-300A-1 P158-35	Black, Non-Fibrous, Homogenous	18"x6" Floor Tile - Women's Locker Room	10%	90%	6.8% Chrysotile
1217-MER-300A-1 P158-36	Black, Non-Fibrous, Homogenous	18"x6" Floor Tile - Women's Locker Room	20%	80%	12.5% Chrysotile
1217-MER-300B-1 P158-37	Black, Non-Fibrous, Homogenous	Mastic of 18"x6" Floor Tile - Women's Locker Room	5%	95%	Inconclusive: No Asbestos Detected
1217-MER-300B-2 P158-38	Black, Non-Fibrous, Homogenous	Mastic of 18"x6" Floor Tile - Women's Locker Room	5%	95%	1.3% Chrysotile

Tracy Skalski  
 Analyst(s)

Approved Signatory

Disclaimers: Polarized Light Microscopy is not consistently reliable in detecting asbestos in floor coverings and similar non-friable, organically-bound materials. Quantitative transmission electron microscopy is currently the only method that can be used to determine if this material can be considered or treated as non-asbestos containing. Results relate only to samples provided by client. This report shall not be reproduced, except in full, without written approval by Sienna. Analysis performed by Sienna Environmental Technologies, NY ELAP #11727.



Table 1  
 Summary of Bulk Asbestos Analysis Results by NYS ELAP 198.4 NOB Method  
 SET 954; C&S Engineers; Merritt Hall / SUNY Potsdam

AmeriSci Sample #	Client Sample#	HG Area	Sample Weight (gram)	Heat Sensitive Organic %	Acid Soluble Inorganic %	Insoluble Non-Asbestos Inorganic %	** Asbestos % by TEM
D1	1217-MER-201B-1		0.890	50.7	6.4	42.9	NAD
Location: Glue Dob Of 201A / 1st Floor Hall							
D2	1217-MER-201B-2		0.340	50.3	7.4	42.4	NAD
Location: Glue Dob Of 201A / 1st Floor Hall							

Analyzed by: Madell E. Collins  
 \*\*Quantitative Analysis (SemiFull); Bulk Asbestos Analysis - PLM by EPA 800/M4-82-020 per 40 CFR or ELAP 198.1 for New York (soluble samples or ELAP 198.6 for New York NOB samples; TEM (SemiFull) by EPA 800/R-93/146 (not covered by NVLAP Bulk accreditation); or ELAP 198.4 for New York samples; NAD = no asbestos detected during a quantitative analysis; NA = not analyzed; Trace = <1%; Quantification for beginning weights of <0.1 grams should be considered as qualitative only; Qualitative Analysis: Asbestos analysis results of "Present" or "NVA = No Visible Asbestos" represents results for Qualitative PLM or TEM Analysis only (no accreditation coverage available from any regulatory agency for qualitative analyses); -AIHA Lab # 102843, NVLAP Lab Code 200543-0, NYSDOH ELAP LAB ID 11480.

Warning Note: PLM limitation: only TEM will resolve fibers <0.25 micrometers in diameter; TEM bulk analysis is representative of the fine grained matrix material and may not be representative of non-uniformly dispersed debris for which PLM evaluation is recommended (i.e. soils and other heterogeneous materials).

Reviewed By: \_\_\_\_\_

# SIENNA ENVIRONMENTAL TECHNOLOGIES, LLC

429 Franklin Street, Suite 102  
Buffalo, NY 14202

Phone 716-332-3134  
Fax 716-332-3136

## Chain of Custody Document

Report to: \_\_\_\_\_

Client/Contact: <u>C&amp;S Engineer, Jeffrey Robbins</u>	Turn around (circle) RUSH 48 Hour 24 Hour 72 Hour
Building/Location: <u>Merritt Hall, SUNY Potsdam</u>	
Job #: <u>SET954</u> Total # Samples: <u>20</u>	

PLM     TEM     AAS     OTHER \_\_\_\_\_

Sample #	Description of Sample	Location of Sample	Notes
1217-MER-100A-1	Plaster skim coat	Room 129	P158-1
1217-MER-100A-2	Plaster skim coat	2nd floor hall	-2
1217-MER-100A-3	Plaster skim coat	3rd floor hall	-3
1217-MER-200A-1	Plaster skim coat	1st floor custodial	-4
1217-MER-200A-2	Plaster skim coat	1st floor hall	-5
1217-MER-100B-1	Plaster base coat	Room 129	-6
1217-MER-100B-2	Plaster base coat	2nd floor hall	-7
1217-MER-100B-3	Plaster base coat	3rd floor hall	-8
1217-MER-200B-1	Plaster base coat	1st floor custodial	-9
1217-MER-200B-2	Plaster base coat	1st floor hall	-10
1217-MER-101-1	Computer <sup>PM</sup> Lab <sup>Glazed block mortar</sup>	Computer lab	-11
1217-MER-101-2	Glazed block mortar	Room 213 storage	-12
1217-MER-102A-1	Drywall	2nd floor storage	-13
1217-MER-102A-2	Drywall	2nd floor hall	-14
1217-MER-102B-1	Joint compound	2nd floor storage	-15
1217-MER-102B-2	Joint compound	2nd floor hall	P158-16

Notes: Page 1 of 2

Sienna Environmental Technologies

Sampled By: Paul J. Mary  Accept  Reject Date: 12/17/08  
 Relinquished By: Paul J. Mary Date: \_\_\_\_\_  
 Received By: Stacy de 1800 P158 Date: 12/18/08

# SIENNA ENVIRONMENTAL TECHNOLOGIES, LLC

429 Franklin Street, Suite 102  
Buffalo, NY 14202

Phone 716-332-3134  
Fax 716-332-3136

## Chain of Custody Document

Report to: \_\_\_\_\_

Client/Contact: <u>C &amp; S Engineers, Jeffrey Robbins</u>	Turn around (circle) RUSH 48 Hour 24 Hour 72 Hour
Building/Location: <u>Merritt Hall / SUNY Potsdam</u>	
Job #: <u>SET954</u> Total # Samples: <u>30</u>	

PLM  TEM  AAS  OTHER

Sample #	Description of Sample	Location of Sample	Notes
1217-MER-102B-3	Joint compound	2nd floor hall	P158-17
1217-MER-103A-1	Grout of ceramic tile	Men's locker room	-18
1217-MER-103A-2	Grout of ceramic tile	Men's locker room	-19
1217-MER-103B-1	Thinset of ceramic tile	Men's locker room	-20
1217-MER-103B-2	Thinset of ceramic tile	Men's locker room	-21
1217-MER-104-1	Cinder block mortar	Basement	-22
1217-MER-104-2	Cinder block mortar	Basement	-23
1217-MER-105-1	Textured wall finish	Room 213 storage	-24
1217-MER-105-2	Textured wall finish	Room 213 storage	-25
1217-MER-105-3	Textured wall finish	Room 213 storage	-26
1217-MER-201A-1	1x1 dot ceiling tile	1st floor hall	-27
1217-MER-201A-2	1x1 dot ceiling tile	1st floor hall	-28
1217-MER-201B-1	Glue job of 201A	1st floor hall	-29
1217-MER-201B-2	Glue job of 201A	1st floor hall	-30
1217-MER-202-1	2x2 cementitious tile	Pool	-31
1217-MER-202-2	2x2 cementitious tile	Pool	P158-32

Notes: Page 2 of 3

Sienna Environmental Technologies  
 Accept  
 Reject

Neg NOBs by PLM for TEM

Sampled By: Paul J. Maty Date: 12/17/08

Relinquished By: Paul J. Maty Date: \_\_\_\_\_

Received By: J. Stead Date: 12/18/08

# SIENNA ENVIRONMENTAL TECHNOLOGIES, LLC

429 Franklin Street, Suite 102  
Buffalo, NY 14202

Phone 716-332-3134  
Fax 716-332-3136

## Chain of Custody Document

Report to: \_\_\_\_\_

Client/Contact: <u>C &amp; S Engineers, Jeffrey Robbins</u>	Turn around (circle)
Building/Location: <u>Merritt Hall, SUNY Potsdam</u>	
Job #: <u>SET954</u> Total # Samples: <u>10</u>	RUSH 48 Hour 24 Hour 72 Hour

PLM  TEM  AAS  OTHER \_\_\_\_\_

Sample #	Description of Sample	Location of Sample	Notes
1217-MER-203-1	2x4 dot + fissure ceiling tile	Daycare	P158-33
1217-MER-203-2	2x4 dot + fissure ceiling tile	Daycare	-34
1217-MER-300A-1	18x6 Black floor tile	Women's locker room	-35
1217-MER-300A-2	18x6 Black floor tile	Women's locker room	-36
1217-MER-300B-1	Black mastic of 300A	Women's locker room	-37
1217-MER-300B-2	Black mastic of 300A	Women's locker room	-38
1217-MER-301-1	Terrazzo	3rd floor hall	-39
1217-MER-301-2	Terrazzo	3rd floor hall	P158-40

Sienna Environmental  
Technologies  
 Accept  
 Reject

Notes: Page 3 of 3

---

Sampled By: <u>Paul J. Maury</u>	Date: <u>12/17/08</u>
Relinquished By: <u>Paul J. Maury</u>	Date: _____
Received By: <u>A. Skarski 1800 P158</u>	Date: <u>12/18/08</u>



# SIENNA ENVIRONMENTAL TECHNOLOGIES, LLC

429 Franklin St. · Suite 102 · Buffalo, NY 14202 · Ph: 716-332-3134 · Fax: 716-332-3136

## LABORATORY REPORT

Attn: Jeffrey Robbins  
C & S Engineers  
499 Col. Eileen Collins Blvd  
Syracuse, NY 13212

Date Received: 12/18/2008

Date Analyzed: 12/29/2008

Sienna ID: P157

Phone: 315-455-2000 Fax: 315-455-9667

Project: SET954 Maxcy Hall

### Polarized Light Microscopy (PLM) by NY State ELAP Method 198.1

Sample	Description	Location	% Fibrous	% Non-Fibrous	% Asbestos Type
1217-MAX-100-1 P157-1	Gray, Non-Fibrous, Homogenous	Cinder Block Mortar - 1st Floor Hall	0%	100%	NAD
1217-MAX-100-2 P157-2	Gray, Non-Fibrous, Homogenous	Cinder Block Mortar - Basement Stairwell	0%	100%	NAD
1217-MAX-101-1 P157-3	Brown, Non-Fibrous, Homogenous	Brick Mortar - 1st Floor Foyer	0%	100%	NAD
1217-MAX-101-2 P157-4	Brown, Non-Fibrous, Homogenous	Brick Mortar - 1st Floor Foyer	0%	100%	NAD
1217-MAX-200-1 P157-5	Gray, Non-Fibrous, Homogenous	2'x4' Dot Ceiling Tile - Ladies' Locker Room	40%	60%	NAD
1217-MAX-200-2 P157-6	Gray, Non-Fibrous, Homogenous	2'x4' Dot Ceiling Tile - Ladies' Locker Room	70%	30%	NAD
1217-MAX-201-1 P157-7	White, Non-Fibrous, Homogenous	Popcorn Ceiling - 1st Floor Foyer	0%	100%	NAD
1217-MAX-201-2 P157-8	White, Non-Fibrous, Homogenous	Popcorn Ceiling - 1st Floor Foyer	0%	100%	NAD
1217-MAX-201-3 P157-9	White, Non-Fibrous, Homogenous	Popcorn Ceiling - 1st Floor Foyer	0%	100%	NAD

Tracy Skalski  
Analyst(s)

Approved Signatory

Disclaimers: NAD = No asbestos detected. Results relate only to samples provided by client. This report shall not be reproduced, except in full, without written approval by Sienna. Samples analyzed as NAD or Trace (<1%) cannot be guaranteed. Quantitative transmission electron microscopy is currently the only reliable method that can be used to determine if this material can be considered or treated as non-asbestos containing. Analysis performed by Sienna Environmental Technologies, NY ELAP #11727.

# SIENNA ENVIRONMENTAL TECHNOLOGIES, LLC

429 Franklin Street, Suite 102  
Buffalo, NY 14202

Phone 716-332-3134  
Fax 716-332-3136

## Chain of Custody Document

x Report to: \_\_\_\_\_

Client/Contact: <u>C&amp;S Engineers - Jeffrey Robbins</u>		Turn around (circle)
Building/Location: <u>MAXCY HALL</u>		
Job #: <u>SET954</u>	Total # Samples: <u>9</u>	RUSH 48 Hour 24 Hour 72 Hour

PLM     TEM     AAS     OTHER \_\_\_\_\_

Sample #	Description of Sample	Location of Sample	Notes
12A-MAX-100-1	Cinder block mortar	1st fl. Hall	PS7-1
12A-MAX-100-2	Cinder block mortar	Basement stairwell	-2
12A-MAX-101-1	Brick mortar	1st fl. foyer	-3
12A-MAX-101-2	Brick mortar	1st fl. foyer	-4
12A-MAX-200-1	2x4 dot CT	Ladies locker Rm.	-5
12A-MAX-200-2	2x4 dot CT	Ladies locker Rm.	-6
12A-MAX-201-1	Popcorn ceiling	1st fl. foyer	-7
12A-MAX-201-2	Popcorn ceiling	1st fl. foyer	-8
12A-MAX-201-3	Popcorn ceiling	1st fl. foyer	PS7-9
Sienna Environmental Technologies			
<input checked="" type="checkbox"/> Accept			
<input type="checkbox"/> Reject			

Notes:

Sampled By: Paul J. Mawg Date: 12/17/08  
 Relinquished By: Paul J. Mawg Date: 12/1/08  
 Received By: J. Skalicki 1500 PS7 Date: 12/18/08



# SIENNA ENVIRONMENTAL TECHNOLOGIES, LLC

429 Franklin St. · Suite 102 · Buffalo, NY 14202 · Ph: 716-332-3134 · Fax: 716-332-3136

## LABORATORY REPORT

Attn: Jeffrey Robbins  
C & S Engineers  
499 Col. Eileen Collins Blvd  
Syracuse, NY 13212

Date Received: 12/18/2008

Date Analyzed: 12/29/2008

Sienna ID: P156

Phone: 315-455-2000 Fax: 315-455-9667

Project: SET954 Lehmann Hall

### Polarized Light Microscopy (PLM) by NY State ELAP Method 198.1

Sample	Description	Location	% Fibrous	% Non-Fibrous	% Asbestos Type
1217-LEH-100A-1 P156-1	Gray, Fibrous, Non-Homogenous	Drywall - Kitchen	10%	90%	NAD
1217-LEH-100A-2 P156-2	Gray, Fibrous, Non-Homogenous	Drywall - Kitchen	20%	80%	NAD
1217-LEH-100B-1 P156-3	Gray, Non-Fibrous, Homogenous	Joint Compound - Kitchen	0%	100%	NAD
1217-LEH-100B-2 P156-4	Gray, Non-Fibrous, Homogenous	Joint Compound - Kitchen	0%	100%	NAD
1217-LEH-100B-3 P156-5	Gray, Non-Fibrous, Homogenous	Joint Compound - Kitchen	0%	100%	NAD

Tracy Skalski  
Analyst(s)

Approved Signatory

Disclaimers: NAD = No asbestos detected. Results relate only to samples provided by client. This report shall not be reproduced, except in full, without written approval by Sienna. Samples analyzed as NAD or Trace (<1%) cannot be guaranteed. Quantitative transmission electron microscopy is currently the only reliable method that can be used to determine if this material can be considered or treated as non-asbestos containing. Analysis performed by Sienna Environmental Technologies, NY ELAP #11727.

SIENNA ENVIRONMENTAL TECHNOLOGIES, LLC

429 Franklin Street, Suite 102  
Buffalo, NY 14202

Phone 716-332-3134  
Fax 716-332-3136

Chain of Custody  
Document

Tax Report to: \_\_\_\_\_

Client/Contact: <u>C/S Engineers - Jeffrey Robbins</u>		Turn around (circle)  RUSH 48 Hour  24 Hour 72 Hour
Building/Location: <u>LEHMANN HALL</u>		
Job #: <u>SET954</u>	Total # Samples: <u>5</u>	

PLM     TEM     AAS     OTHER \_\_\_\_\_

Sample #	Description of Sample	Location of Sample	Notes
127-LEH-100A-1	Dry Wall	Kitchen	P156-1
127-LEH-100A-2	Dry Wall	Kitchen	1-2
127-LEH-100B-1	Joint Compound	Kitchen	-3
127-LEH-100B-2	Joint Compound	Kitchen	-4
127-LEH-100B-3	Joint Compound	Kitchen	P156-5 B

Sienna Environmental  
Technologies  
 Accept  
 Reject

Notes: \_\_\_\_\_

Sampled By: Paul J. Manig Date: 12/17/08

Relinquished By: Paul J. Manig Date: \_\_\_\_\_

Received By: J. S. [unclear] 1500 P156 Date: 12/18/08





# SIENNA ENVIRONMENTAL TECHNOLOGIES, LLC

429 Franklin St. · Suite 102 · Buffalo, NY 14202 · Ph: 716-332-3134 · Fax: 716-332-3136

## LABORATORY REPORT

Attn: Jeffrey Robbins  
C & S Engineers  
499 Col. Eileen Collins Blvd  
Syracuse, NY 13212

Date Received: 12/18/2008

Date Analyzed: 12/28/2008

Sienna ID: P151

Phone: 315-455-2000 Fax: 315-455-9667

Project: SET954 Crane Music Complex

*Hosmer*

### Polarized Light Microscopy (PLM) by NY State ELAP Method 198.1

Sample	Description	Location	% Fibrous	% Non-Fibrous	% Asbestos Type
1217-CRA-100-1 P151-1	Gray, Non-Fibrous, Homogenous	Cinder Block Mortar - Maintenance Shop	0%	100%	NAD
1217-CRA-100-2 P151-2	Gray, Non-Fibrous, Homogenous	Cinder Block Mortar - Room 410	0%	100%	NAD
1217-CRA-101A-1 P151-3	Gray, Non-Fibrous, Homogenous	Drywall - Hosmer Gallery	0%	100%	NAD
1217-CRA-101A-2 P151-4	Gray, Non-Fibrous, Homogenous	Drywall - Hosmer Gallery	5%	95%	NAD
1217-CRA-101B-1 P151-5	White, Non-Fibrous, Homogenous	Joint Compound - Hosmer Gallery	0%	100%	NAD
1217-CRA-101B-2 P151-6	Tan, Non-Fibrous, Homogenous	Joint Compound - Hosmer Gallery	0%	100%	NAD
1217-CRA-101B-3 P151-7	Tan, Non-Fibrous, Homogenous	Joint Compound - Hosmer Gallery	0%	100%	NAD
1217-CRA-102-1 P151-8	Gray, Fibrous, Homogenous	Transite Wall Board - Room 407	15%	85%	9.8% Chrysotile
1217-CRA-102-2 P151-9	Gray, Fibrous, Homogenous	Transite Wall Board - Room 407	25%	75%	21.1% Chrysotile

Tracy Skalski  
Analyst(s)

*[Signature]*  
Approved Signatory

Disclaimers: NAD = No asbestos detected. Results relate only to samples provided by client. This report shall not be reproduced, except in full, without written approval by Sienna. Samples analyzed as NAD or Trace (<1%) cannot be guaranteed. Quantitative transmission electron microscopy is currently the only reliable method that can be used to determine if this material can be considered or treated as non-asbestos containing. Analysis performed by Sienna Environmental Technologies, NY ELAP #11727.

# SIENNA ENVIRONMENTAL TECHNOLOGIES, LLC

429 Franklin Street, Suite 102  
Buffalo, NY 14202

Phone 716-332-3134  
Fax 716-332-3136

## Chain of Custody Document

Report to: \_\_\_\_\_

Client/Contact: <u>C/S Engineers - Jeffrey Robbins</u>		Turn around (circle)
Building/Location: <u>CRANE MUSIC COMPLEX</u>		
Job #: <u>SET954</u>	Total # Samples: <u>9</u>	RUSH 48 Hour 24 Hour 72 Hour

PLM     TEM     AAS     OTHER

Sample #	Description of Sample	Location of Sample	Notes
1217-CRA-100-1	Cinder block mortar	Maintenance Shop	PS1-1
1217-CRA-100-2	Cinder block mortar	Rm 410	-2
1217-CRA-101A-1	Dry wall	Hosmer gallery	-3
1217-CRA-101A-2	Dry wall	Hosmer gallery	-4
1217-CRA-101B-1	Joint compound	Hosmer gallery	-5
1217-CRA-101B-2	Joint compound	Hosmer gallery	-6
1217-CRA-101B-3	Joint compound	Hosmer gallery	-7
1217-CRA-102-1	Transite wall board	Rm 407	-8
1217-CRA-102-2	Transite wall board	Rm 407	PS1-9
		Sienna Environmental Technologies <input checked="" type="checkbox"/> Accept <input type="checkbox"/> Reject	

Notes:

Sampled By: Paul J. Maw Date: 12/17/08  
 Relinquished By: Paul J. Maw Date: \_\_\_\_\_  
 Received By: A. Stalski 1500 P151 Date: 12/18/08



# SIENNA ENVIRONMENTAL TECHNOLOGIES, LLC

429 Franklin St. · Suite 102 · Buffalo, NY 14202 · Ph: 716-332-3134 · Fax: 716-332-3136

## LABORATORY REPORT

Attn: Jeffrey Robbins  
C & S Engineers  
499 Col. Eileen Collins Blvd  
Syracuse, NY 13212

Date Received: 12/18/2008  
Date Analyzed: 12/29/2008  
Sienna ID: P154

Phone: 315-455-2000 Fax: 315-455-9867

Project: SET954 Healing Plant / **Service Center**

### Polarized Light Microscopy (PLM) by NY State ELAP Method 198.1

Sample	Description	Location	% Fibrous	% Non-Fibrous	% Asbestos Type
1217-HPL-100-1 P154-1	Gray, Non-Fibrous, Homogenous	Cinder Block Mortar - Garage	0%	100%	NAD
1217-HPL-100-2 P154-2	Gray, Non-Fibrous, Homogenous	Cinder Block Mortar - Garage	0%	100%	NAD
1217-HPL-101-1 P154-3	Gray, Non-Fibrous, Homogenous	Brick Mortar - Switch Gear Room	0%	100%	NAD
1217-HPL-101-2 P154-4	Gray, Non-Fibrous, Homogenous	Brick Mortar - Switch Gear Room	0%	100%	NAD

Tracy Skalski  
Analyst(s)

Approved Signatory

Disclaimers: NAD = No asbestos detected. Results relate only to samples provided by client. This report shall not be reproduced, except in full, without written approval by Sienna. Samples analyzed as NAD or Trace (<1%) cannot be guaranteed. Quantitative transmission electron microscopy is currently the only reliable method that can be used to determine if this material can be considered or treated as non-asbestos containing. Analysis performed by Sienna Environmental Technologies, NY ELAP #11727.

# SIENNA ENVIRONMENTAL TECHNOLOGIES, LLC

429 Franklin Street, Suite 102  
Buffalo, NY 14202

Phone 716-332-3134  
Fax 716-332-3136

## Chain of Custody Document

..x Report to: \_\_\_\_\_

Client/Contact: <u>C/S Engineers - Jeffrey Robbins</u>	Turn around (circle) RUSH 48 Hour 24 Hour 72 Hour
Building/Location: <u>HEATING PLANT / SERVICE CENTER</u>	
Job #: <u>SET954</u> Total # Samples: <u>4</u>	

PLM     TEM     AAS     OTHER \_\_\_\_\_

Sample #	Description of Sample	Location of Sample	Notes
127-HPL-100-1	Cinder block mortar	Garage	P154-1
127-HPL-100-2	cinder block mortar	Garage	-2
127-HPL-101-1	Brick mortar	Switch gear Rm.	-3
127-HPL-101-2	Brick mortar	Switch gear Rm.	P154-4

Sienna Environmental  
Technologies  
 Accept  
 Reject

Notes: \_\_\_\_\_

Sampled By: Paul J. Mainz Date: 12/17/08  
Relinquished By: Paul J. Mainz Date: \_\_\_\_\_  
Received By: A. Stalski 1500 P154 Date: 12/18/08



# SIENNA ENVIRONMENTAL TECHNOLOGIES, LLC

429 Franklin St. · Suite 102 · Buffalo, NY 14202 · Ph: 716-332-3134 · Fax: 716-332-3136

## LABORATORY REPORT

Attn: Jeffrey Robbins  
C & S Engineers  
499 Col. Eileen Collins Blvd  
Syracuse, NY 13212

Date Received: 12/18/2008

Date Analyzed: 12/29/2008

Sienna ID: P155

Phone: 315-455-2000 Fax: 315-455-9667

Project: SET954 Knowles Dining Hall

### Polarized Light Microscopy (PLM) by NY State ELAP Method 198.1

Sample	Description	Location	% Fibrous	% Non-Fibrous	% Asbestos Type
1217-KNO-100-1 P155-1	Brown, Non-Fibrous, Homogenous	Brick Mortar - Dining Room	0%	100%	NAD
1217-KNO-100-2 P155-2	Brown, Non-Fibrous, Homogenous	Brick Mortar - Dining Room	0%	100%	NAD

Tracy Skalski  
Analyst(s)

Approved Signatory

Disclaimers: NAD = No asbestos detected. Results relate only to samples provided by client. This report shall not be reproduced, except in full, without written approval by Sienna. Samples analyzed as NAD or Trace (<1%) cannot be guaranteed. Quantitative transmission electron microscopy is currently the only reliable method that can be used to determine if this material can be considered or treated as non-asbestos containing. Analysis performed by Sienna Environmental Technologies, NY ELAP #11727.

# SIENNA ENVIRONMENTAL TECHNOLOGIES, LLC

429 Franklin Street, Suite 102  
 Buffalo, NY 14202

Phone 716-332-3134  
 Fax 716-332-3136

## Chain of Custody Document

Lab Report to: \_\_\_\_\_


Client/Contact: <u>C &amp; S Engineers, Jeffrey Robbins</u>	Turn around (circle)
Building/Location: <u>Knowles Dining Hall</u>	
Job #: <u>SET954</u> Total # Samples: <u>2</u>	RUSH    48 Hour 24 Hour    72 Hour

PLM     TEM     AAS     OTHER \_\_\_\_\_

Sample #	Description of Sample	Location of Sample	Notes
KNO <del>1217-BRA-100-1</del>	Brick mortar	Dining room	P155-1
KNO <del>1217-BRA-100-2</del>	Brick mortar	Dining room	P155-2
Sienna Environmental Technologies		<input checked="" type="checkbox"/> Accept <input type="checkbox"/> Reject	

Notes: Page 1 of 1

Sampled By: Paul J. Murray Date: 12/17/08  
 Relinquished By: Paul J. Murray Date: \_\_\_\_\_  
 Received By: [Signature] 1800 P155 Date: 12/18/08

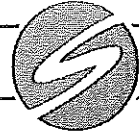


---

**SIENNA** ENVIRONMENTAL TECHNOLOGIES, LLC

---

429 Franklin St. · Suite 102 · Buffalo, NY 14202 · Ph: 716-332-3134 · Fax: 716-332-3136


**Appendix D Asbestos sample location maps**

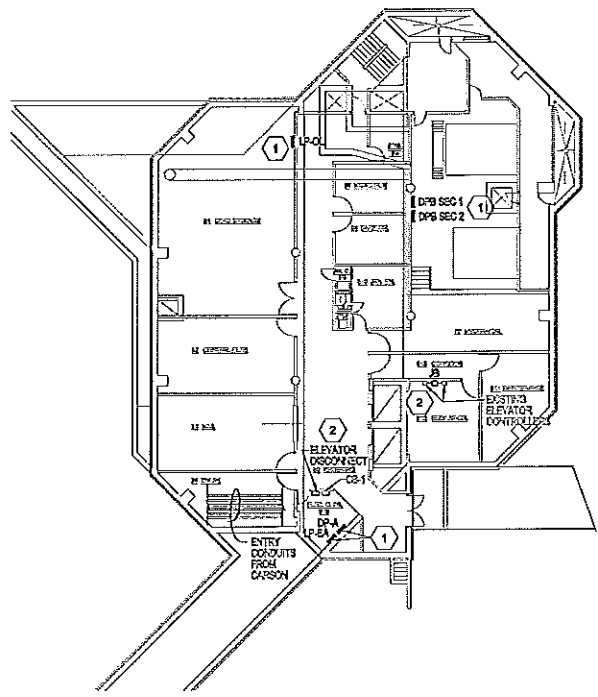

**DRAWING SPECIFIC NOTES:**  
 1 REMOVE EXISTING PANELBOARD IN THIS LOCATION AND REPLACE WITH NEW PANEL BOARD AS SHOWN.  
 SEE A1 E-100-1 FOR WORK ASSOCIATED IN THESE AREAS.




C1 RAYMOND - BASEMENT PLAN  
SCALE: 1/8" = 1'-0"

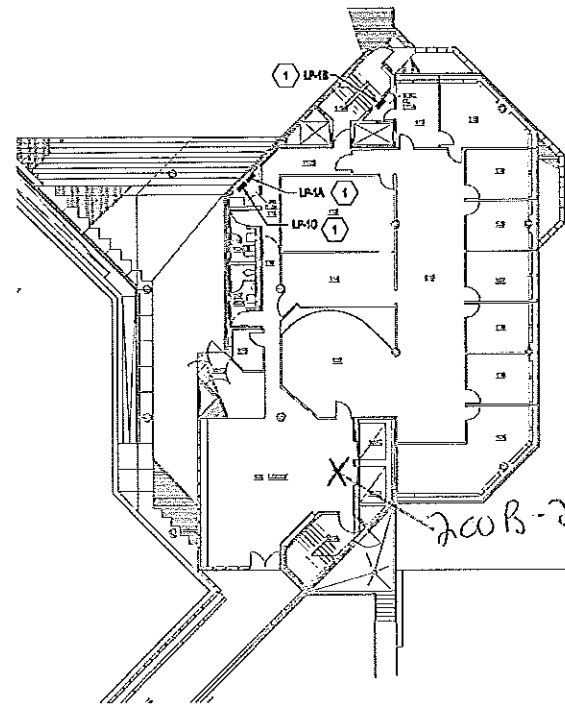

**DRAWING SPECIFIC NOTES:**  
 1 REMOVE EXISTING PANELBOARD IN THIS LOCATION AND REPLACE WITH NEW PANEL BOARD AS SHOWN.




C3 RAYMOND - FIRST FLOOR PLAN  
SCALE: 1/8" = 1'-0"

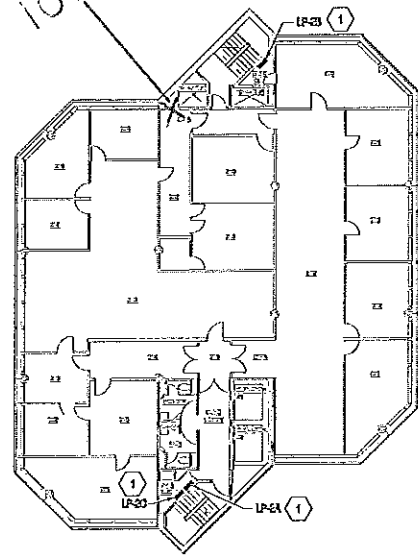

**DRAWING SPECIFIC NOTES:**  
 1 REMOVE EXISTING PANELBOARD IN THIS LOCATION AND REPLACE WITH NEW PANEL BOARD AS SHOWN.



A1 RAYMOND - SECOND FLOOR PLAN  
SCALE: 1/8" = 1'-0"

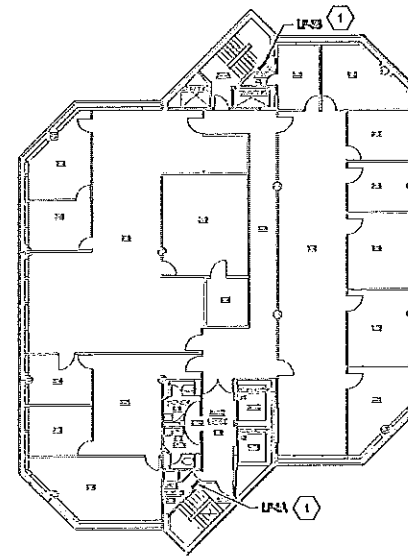

**DRAWING SPECIFIC NOTES:**  
 1 REMOVE EXISTING PANELBOARD IN THIS LOCATION AND REPLACE WITH NEW PANEL BOARD AS SHOWN.




A3 RAYMOND - THIRD FLOOR PLAN  
SCALE: 1/8" = 1'-0"



C&S Engineers, Inc.  
 499 Col. Eileen Collins Blvd.  
 Syracuse, New York 13212  
 Phone: 315-455-2000  
 Fax: 315-455-9687  
 www.cscos.com

INSERT C&S  
 PE SEAL HERE

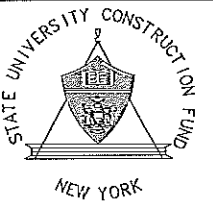

STATE UNIVERSITY CONSTRUCTION FUND  
 SU-CF PROJECT NO. 12290  
 STATE UNIVERSITY OF NEW YORK AT POTSDAM  
 PRE-BID SUBMISSION - NOT FOR CONSTRUCTION  
 UPGRADE ELECTRICAL DISTRIBUTION SYSTEMS  
 VARIOUS BUILDINGS

MARK	DATE	DESCRIPTION
REVISIONS		
PROJECT NO: 190-453-001		
DATE: DECEMBER 5, 2008		
SCALE: AS SHOWN		
DRAWN BY: P.N.LUN		
DESIGNED BY: T.A.KLIKIEWICZ		
CHECKED BY: J.L.ROBBINS, P.E.		

NO ALTERATION PERMITTED HEREOF  
 EXCEPT AS PROVIDED UNDER SECTION  
 2208 SUBDIVISION 2 OF THE NEW YORK  
 EDUCATION LAW

ELECTRICAL  
 RAYMOND  
 BASEMENT, 1ST  
 2ND & 3RD  
 PLANS


E-100-1a





C&S Engineers, Inc.  
 499 Col. Eileen Collins Blvd.  
 Syracuse, New York 13212  
 Phone: 315-455-2000  
 Fax: 315-455-6687  
 www.cscos.com

ISSUED BY C&S  
 SEE SEAL HERE

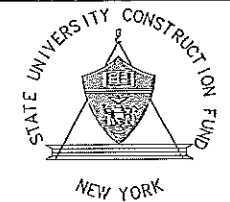


STATE UNIVERSITY CONSTRUCTION FUND  
 SUCCF PROJECT NO. 12250  
 STATE UNIVERSITY OF NEW YORK AT POTSDAM  
**PRE-BID SUBMISSION - NOT FOR CONSTRUCTION**  
 UPGRADE ELECTRICAL DISTRIBUTION SYSTEMS  
 VARIOUS BUILDINGS

MARK	DATE	DESCRIPTION
		REVISIONS
		PROJECT NO: 190,453,001
		DATE: DECEMBER 5, 2003
		SCALE: AS SHOWN
		DRAWN BY: P.H. LUJ
		DESIGNED BY: T.G. HUKIEWICZ
		CHECKED BY: J.L. ROSSINI, P.E.

NO ALTERATION PERMITTED HEREON  
 EXCEPT AS PROVIDED UNDER SECTION  
 7209 SUBDIVISION 2 OF THE NEW YORK  
 EDUCATION LAW

**ELECTRICAL**  
**RAYMOND**  
**4TH, 5TH, 6TH, 7TH**  
**& 8TH FLOOR PLANS**

**E-100-1b**

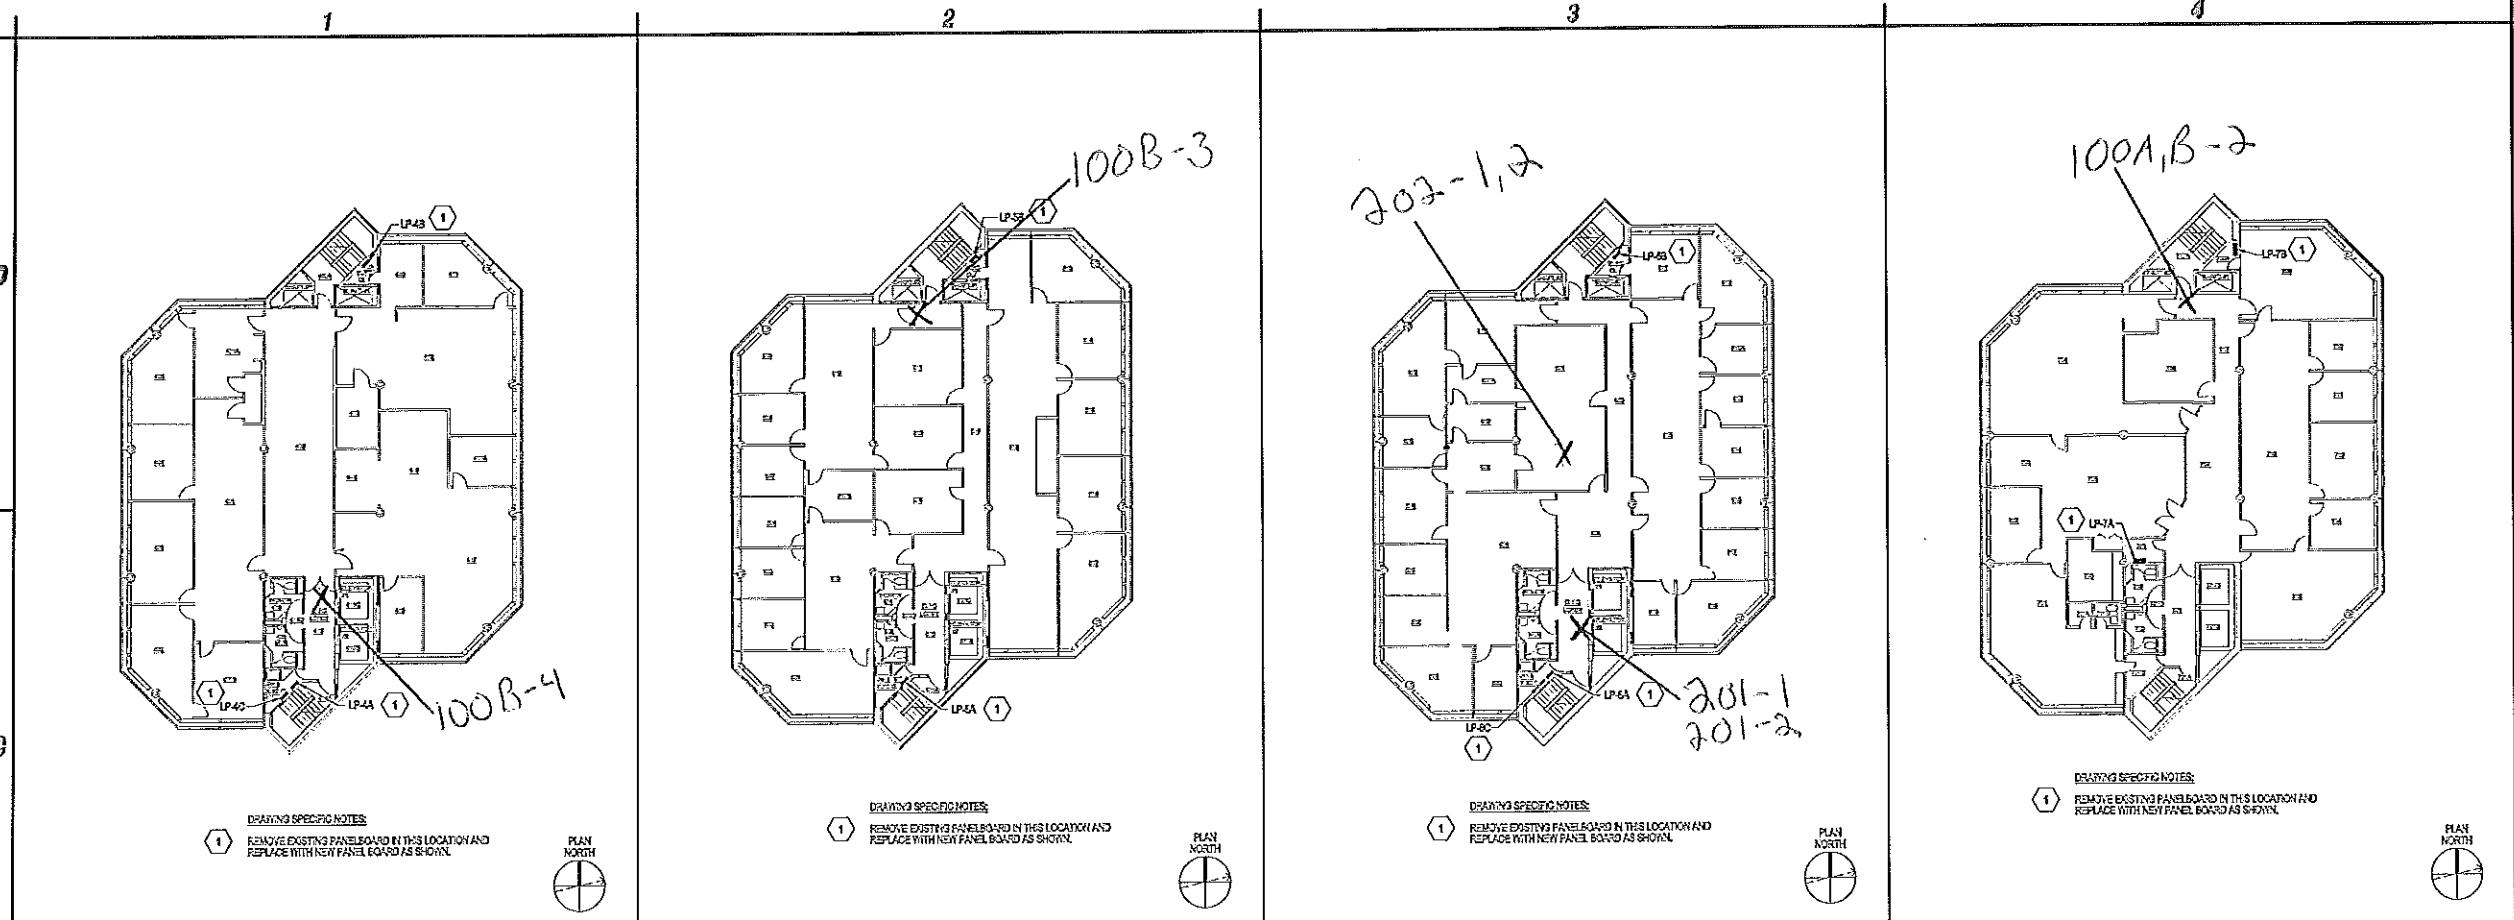


**C1 RAYMOND - FOURTH FLOOR PLAN**  
 SCALE: 1/8" = 1'-0"


**C2 RAYMOND - FIFTH FLOOR PLAN**  
 SCALE: 1/8" = 1'-0"

**C3 RAYMOND - SIXTH FLOOR PLAN**  
 SCALE: 1/8" = 1'-0"

**C4 RAYMOND - SEVENTH FLOOR PLAN**  
 SCALE: 1/8" = 1'-0"


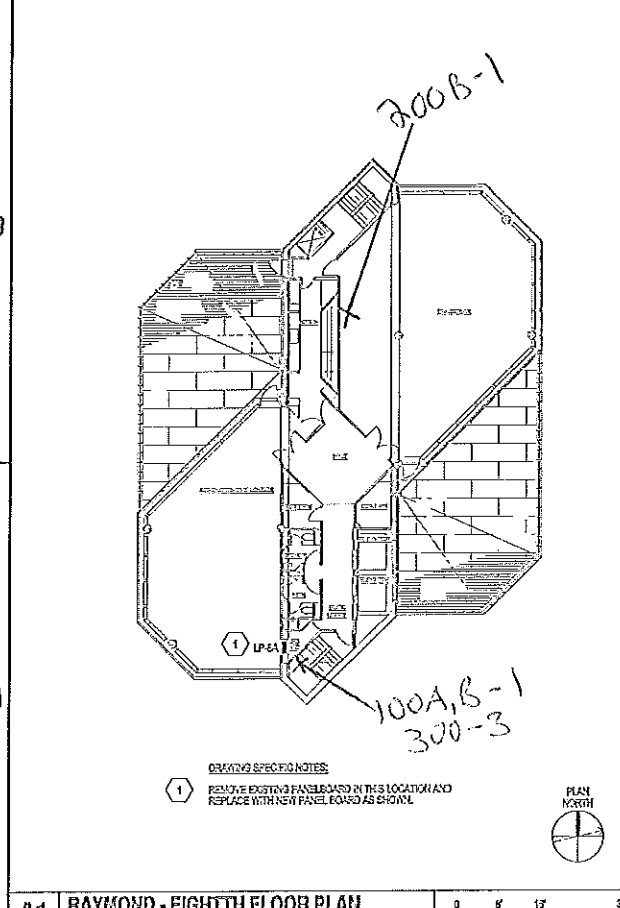


**A1 RAYMOND - EIGHTH FLOOR PLAN**  
 SCALE: 1/8" = 1'-0"

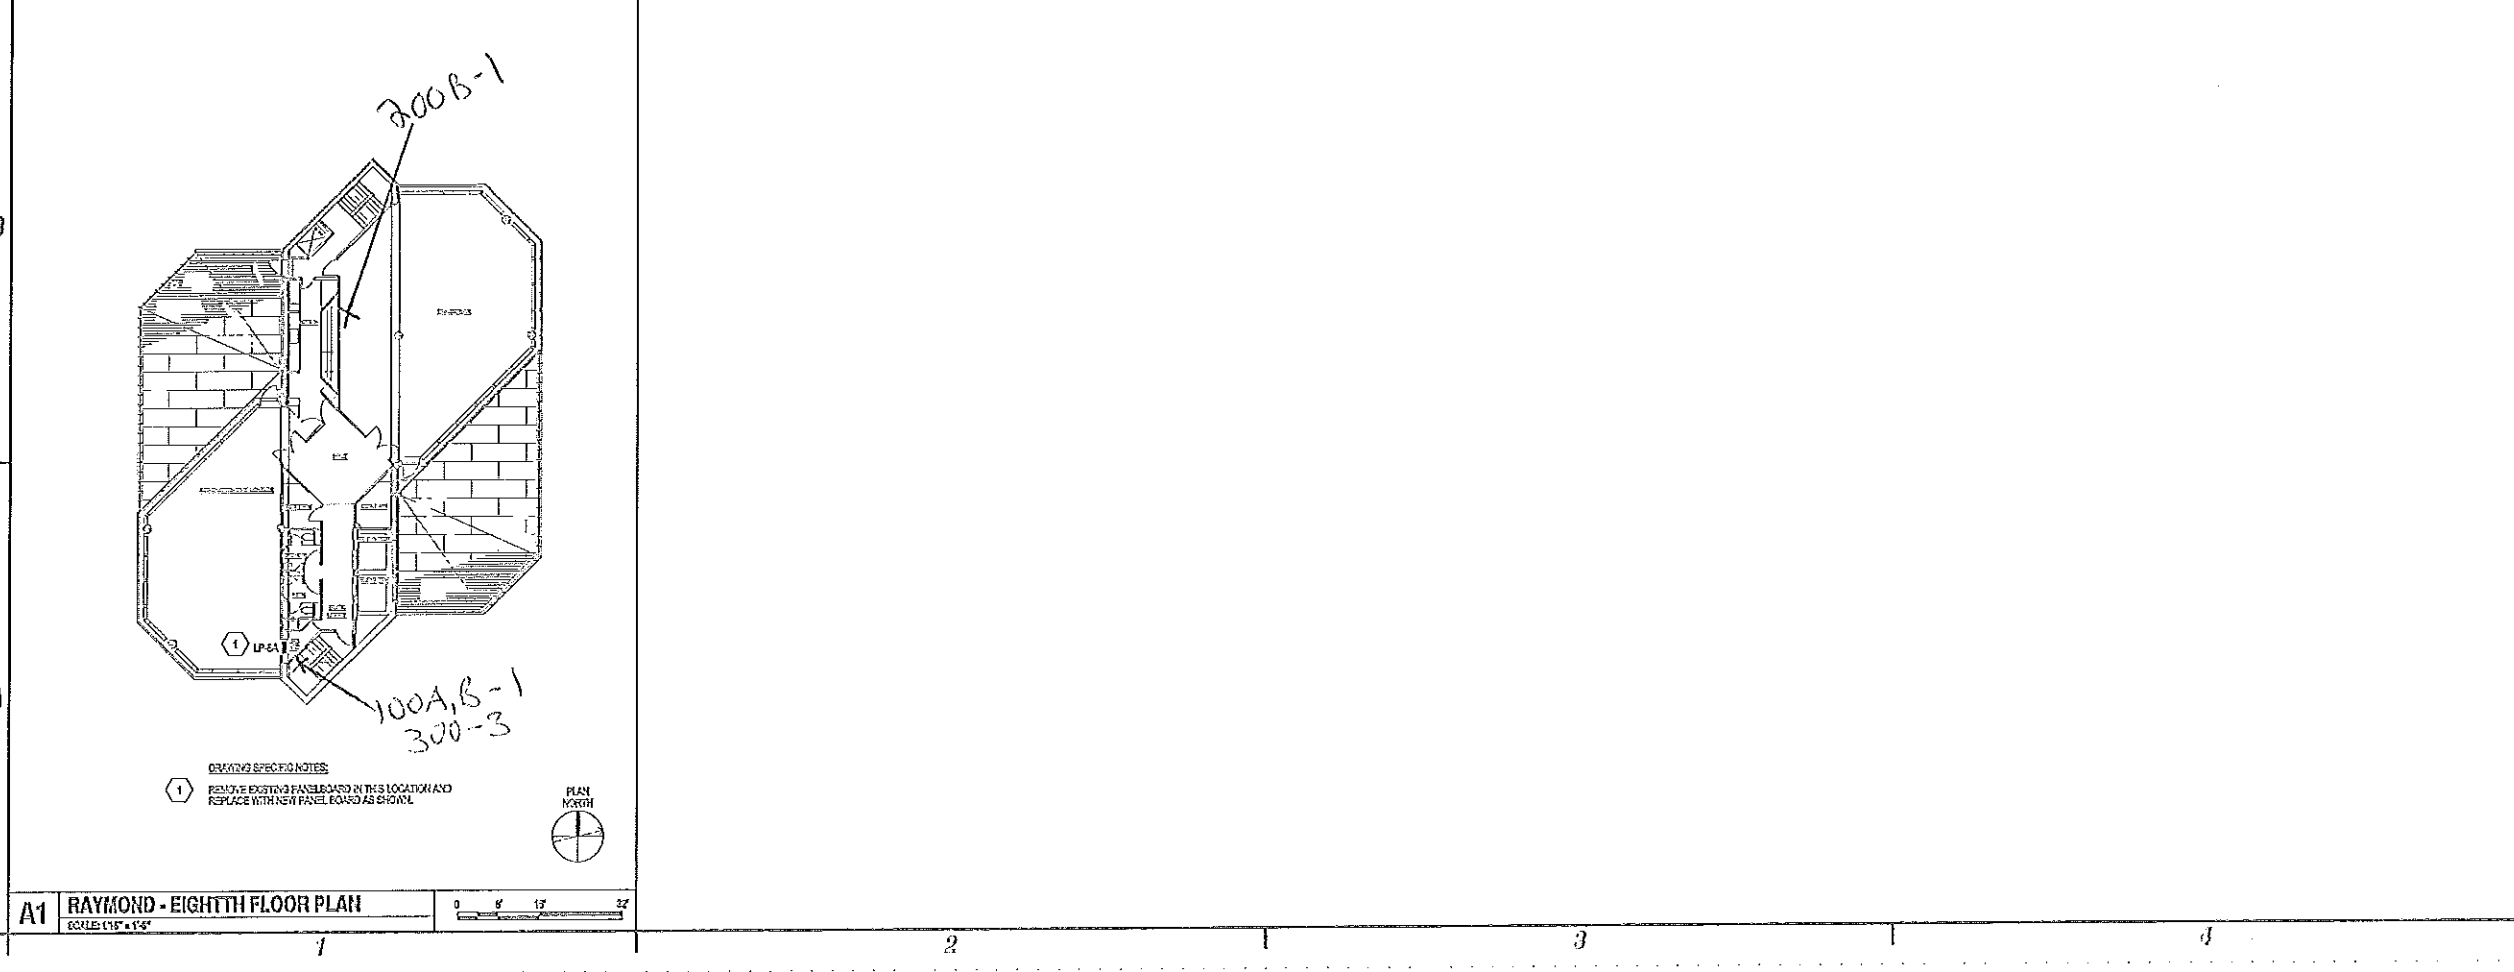



C&S Engineers, Inc.  
 499 Col. Elson Collins Blvd.  
 Syracuse, New York 13212  
 Phone: 315-455-2000  
 Fax: 315-455-5667  
 www.ccsos.com

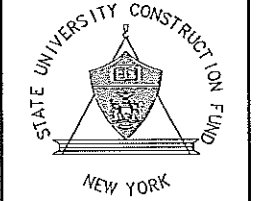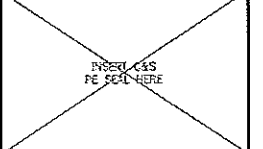

STATE UNIVERSITY CONSTRUCTION FUND  
 SUCF PROJECT NO. 12290  
 STATE UNIVERSITY OF NEW YORK AT POITSDAM  
 PRE-BID SUBMISSION - NOT FOR CONSTRUCTION  
 UPGRADE ELECTRICAL DISTRIBUTION SYSTEMS  
 VARIOUS BUILDINGS


MARK	DATE	DESCRIPTION

REVISIONS	
PROJECT NO.	190433001
DATE	DECEMBER 5, 2008
SCALE	AS SHOWN
DRAWN BY	P.H. LIU
DESIGNED BY	T.D. KUREWICZ
CHECKED BY	J.L. ROBBINS, P.E.


NO ALTERATION PERMITTED HEREON EXCEPT AS PROVIDED UNDER SECTION 7209 SUBSECTION 2 OF THE NEW YORK EDUCATION LAW

**ELECTRICAL**  
**FLAGG BASEMENT & 1ST FLOOR PLANS**

**E-100-3a**

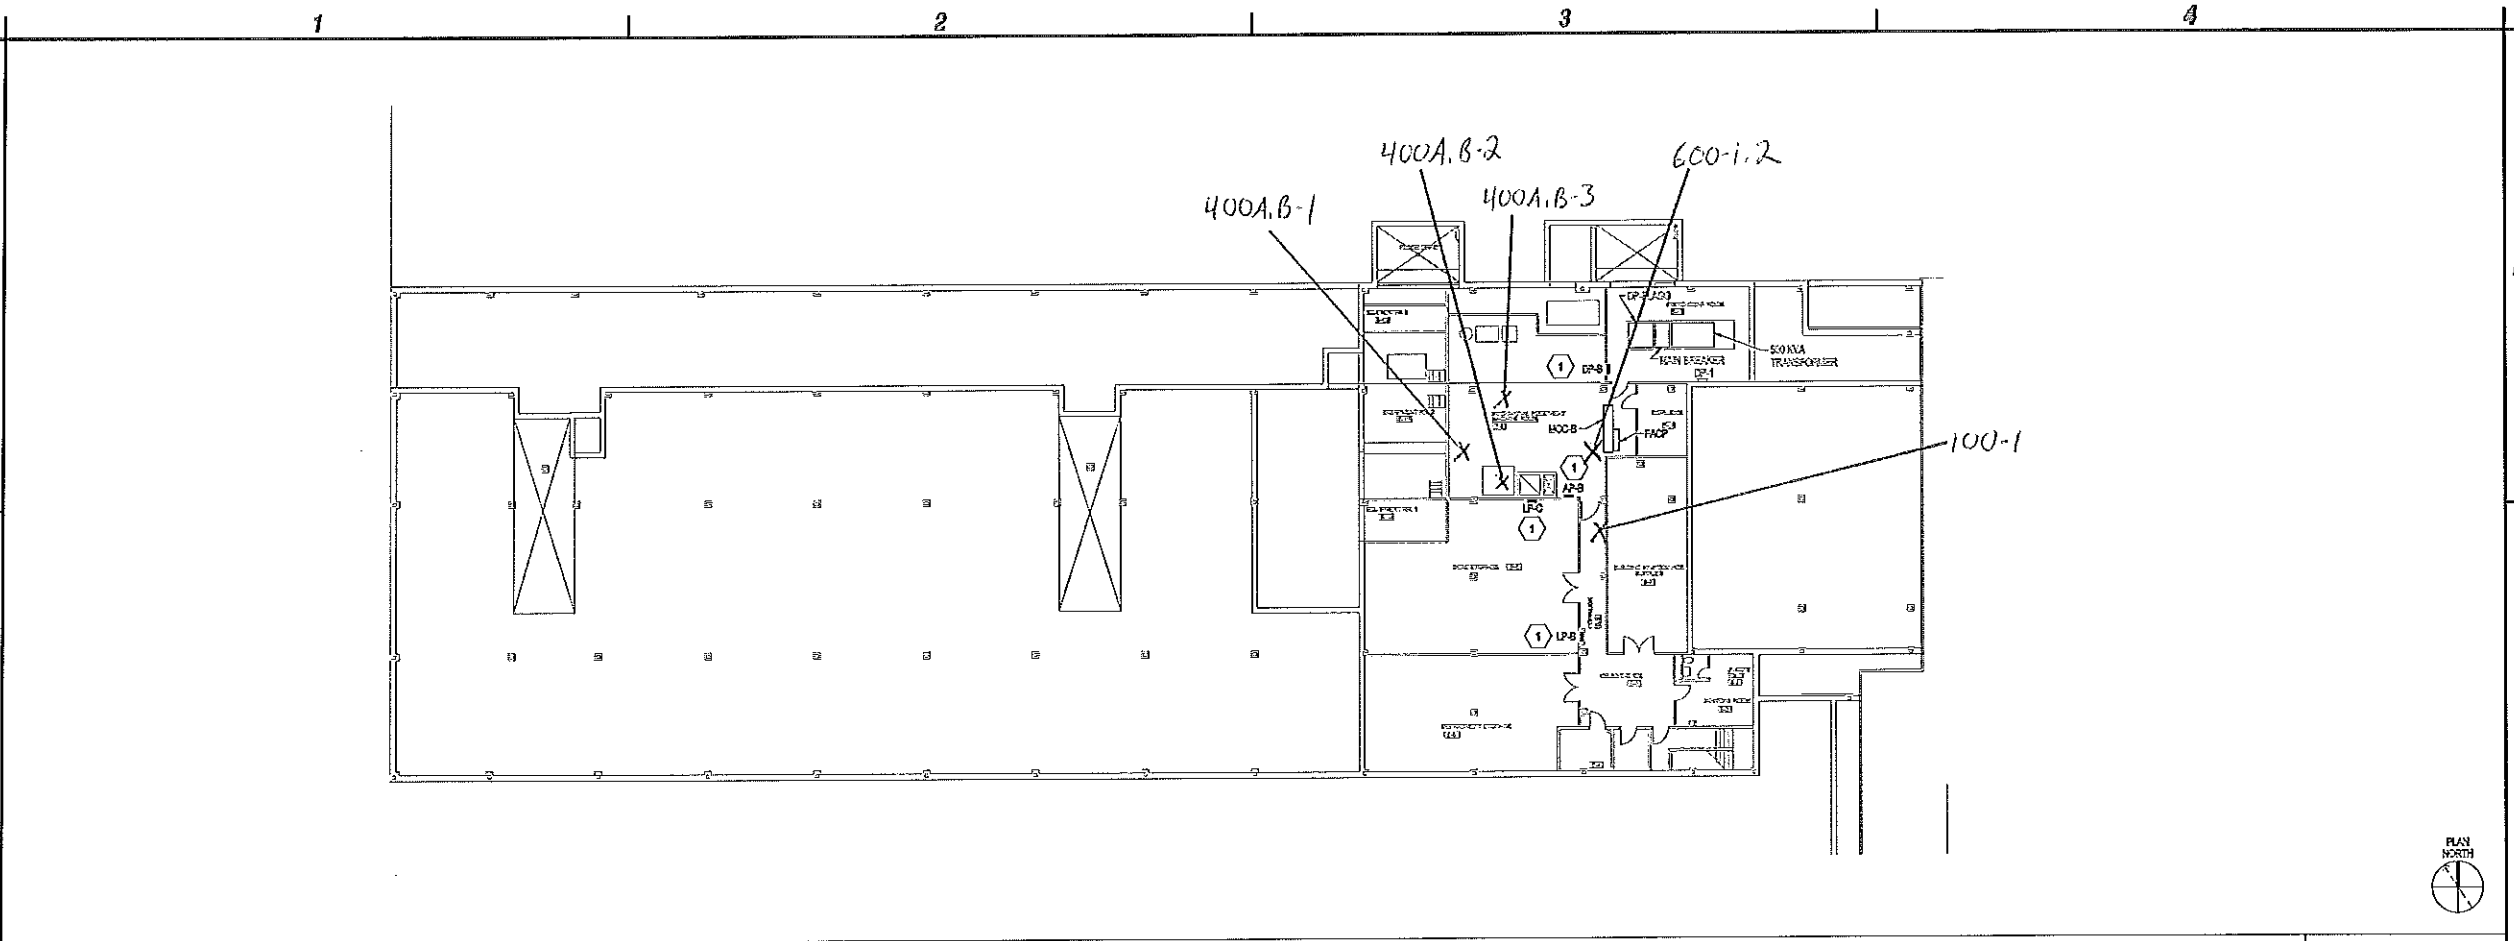

**C1 FLAGG - BASEMENT PLAN**  
 SCALE: 1/4" = 1'-0"

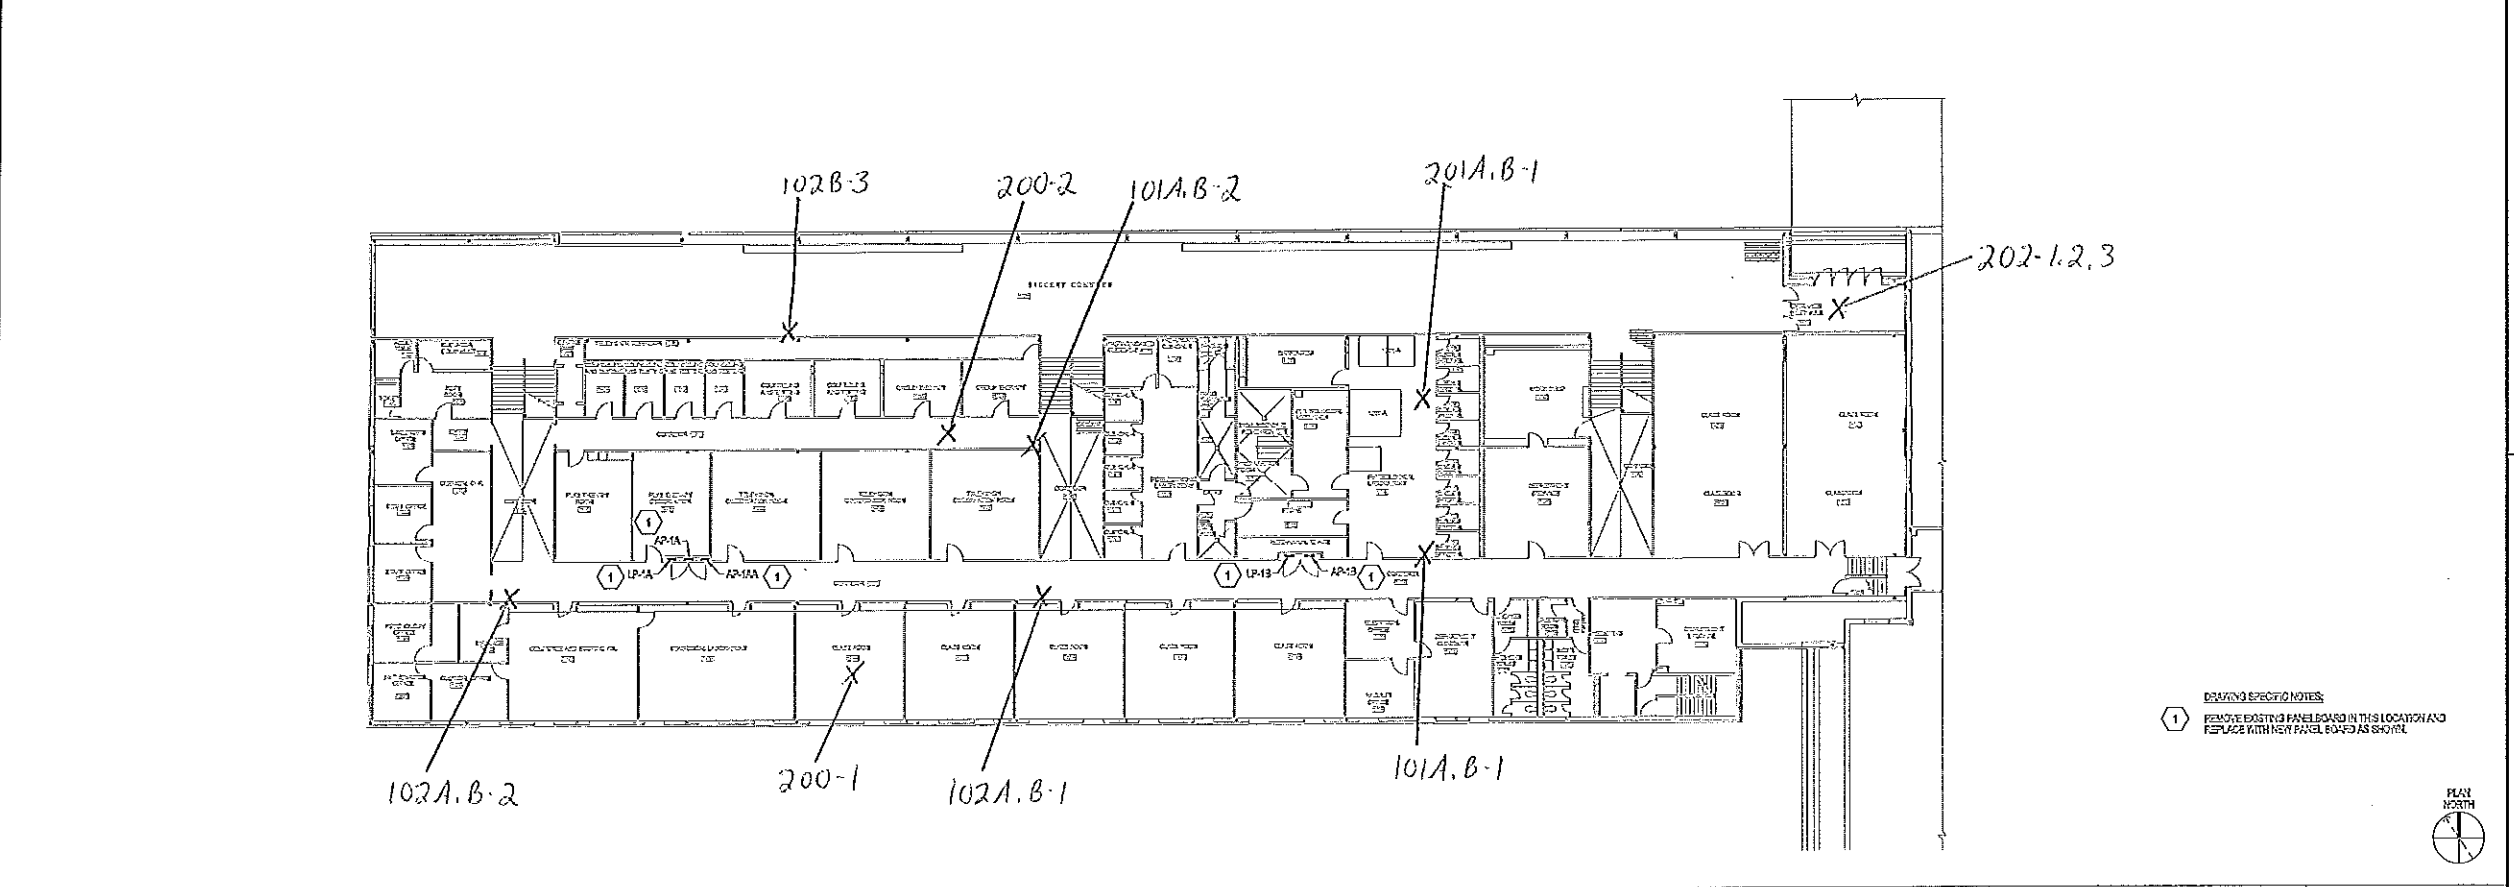


**A1 FLAGG - FIRST FLOOR PLAN**  
 SCALE: 1/4" = 1'-0"

Jan. 10, 2008 - SUCF  
 E-100-3a  
 STATE UNIVERSITY CONSTRUCTION FUND  
 STATE UNIVERSITY OF NEW YORK AT POITSDAM  
 PRE-BID SUBMISSION - NOT FOR CONSTRUCTION  
 UPGRADE ELECTRICAL DISTRIBUTION SYSTEMS  
 VARIOUS BUILDINGS



**C&S Engineers, Inc.**  
 499 Col. Eileen Collins Blvd.  
 Syracuse, New York 13212  
 Phone: 315-455-2000  
 Fax: 315-455-9997  
 www.cscos.com

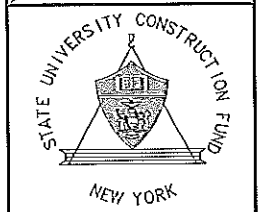

STATE UNIVERSITY CONSTRUCTION FUND  
 SUCF PROJECT NO. 12290  
 STATE UNIVERSITY OF NEW YORK AT POTSDAM  
**PRE-BID SUBMISSION - NOT FOR CONSTRUCTION**  
**UPGRADE ELECTRICAL DISTRIBUTION SYSTEMS  
 VARIOUS BUILDINGS**

REV	DATE	DESCRIPTION

REVISIONS


PROJECT NO: 190453.001  
 DATE: DECEMBER 5, 2009  
 SCALE: AS SHOWN  
 DRAWN BY: P.H. LUU  
 DESIGNED BY: T.B. HIRENKOZ  
 CHECKED BY: J.L. ROSSINI, P.E.

NO ALTERATION PERMITTED HEREON  
 EXCEPT AS PROVIDED UNDER SECTION  
 2209 SUBDIVISION 2 OF THE NEW YORK  
 EDUCATION LAW

**ELECTRICAL**

**FLAGG  
 SECOND FLOOR  
 PLAN**


**E-100-3b**

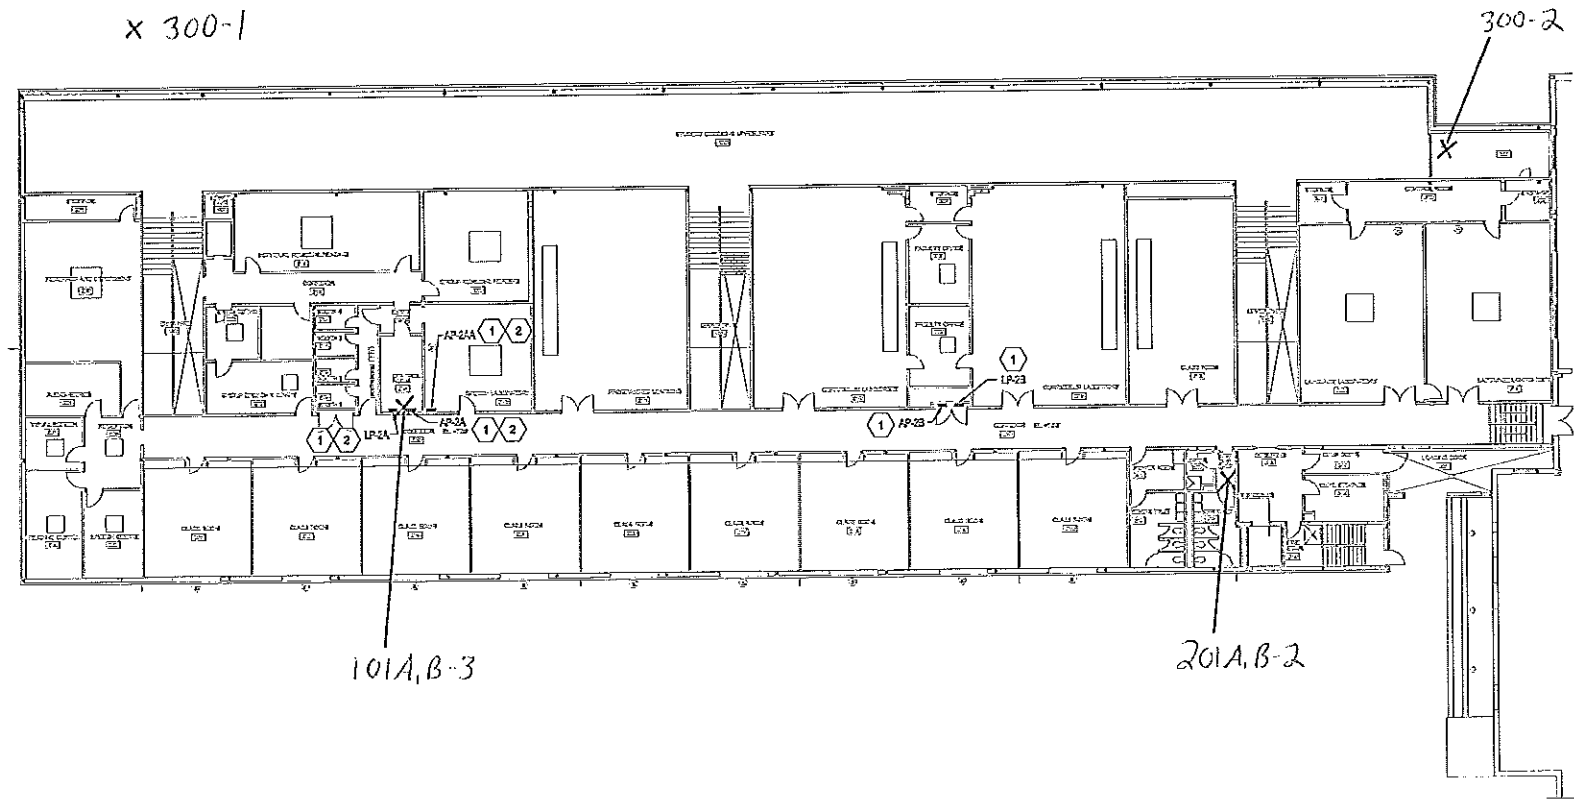


- DRAWING SPECIFIC NOTES**
- 1 RELATIVE EXISTING PANELBOARD IN THIS LOCATION AND REPLACE WITH NEW PANELBOARD AS SHOWN
  - 2 SEE DETAIL A24-51 FOR ARCHITECTURAL WORK



**A1 FLAGG - SECOND FLOOR PLAN**  
 SCALE: 1/8" = 1'-0"

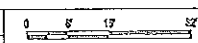


DATE: 12/5/09  
 DRAWN BY: P.H. LUU  
 CHECKED BY: J.L. ROSSINI, P.E.

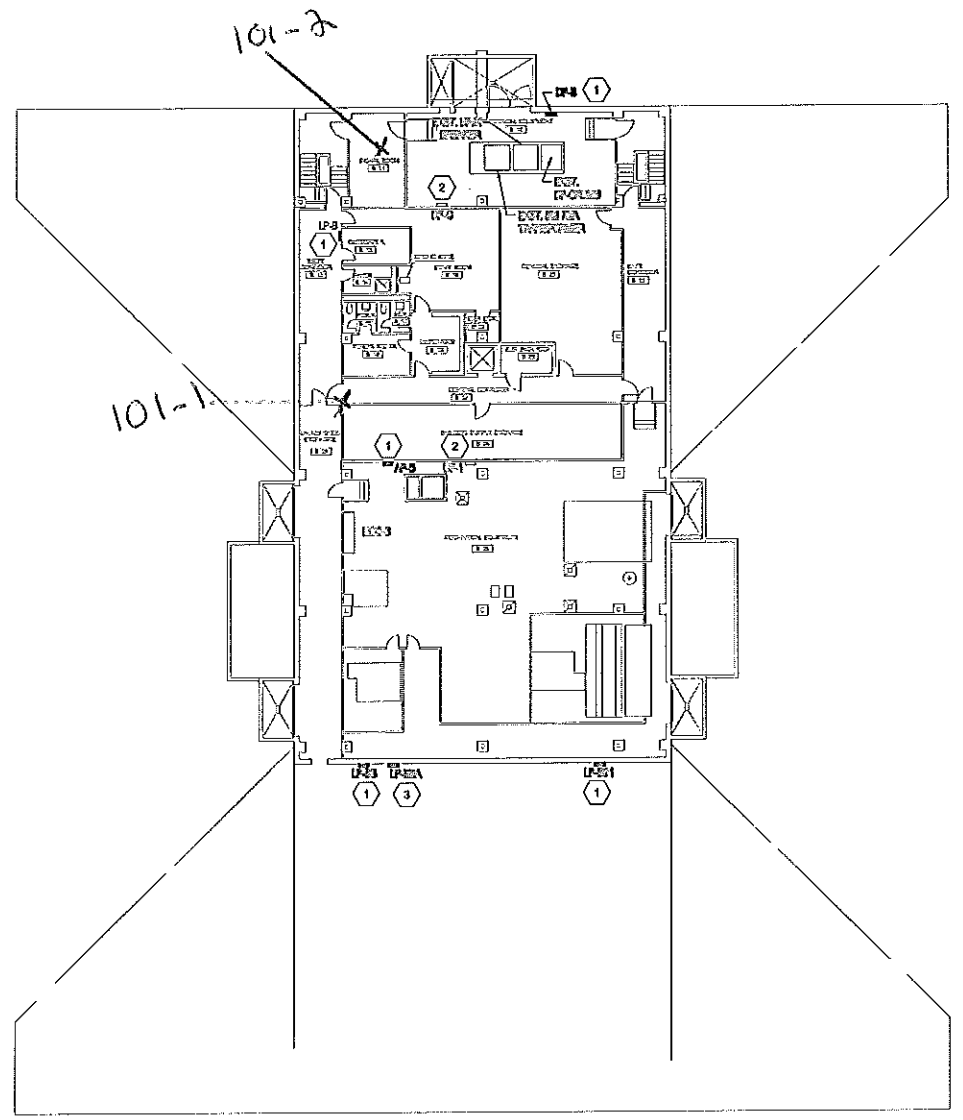

- DRAWING SPECIFIC NOTES:**
- 1 REMOVE EXISTING PANELBOARD IN THIS LOCATION AND REPLACE WITH NEW PANEL BOARD AS SHOWN
  - 2 REMAINS
  - 3 CIRCUITS TO BE RELOCATED TO NEW ELECTRICAL PANEL



**A1 CRUMB LIBRARY - BASEMENT PLAN**  
SCALE: 1/8" = 1'-0"

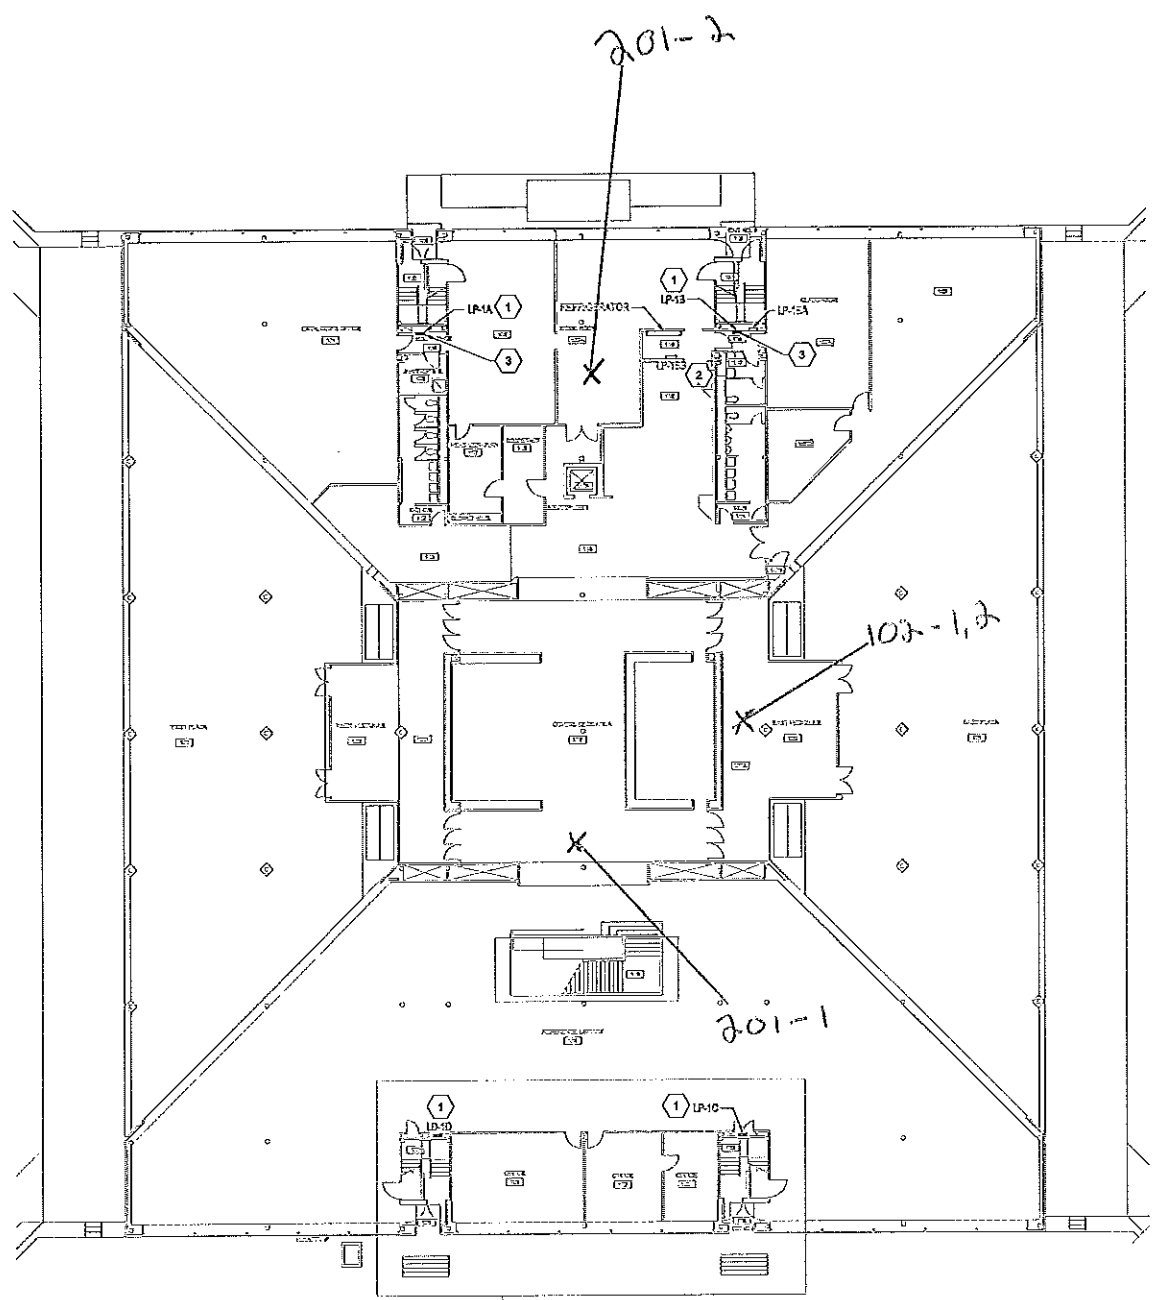



- DRAWING SPECIFIC NOTES:**
- 1 REMOVE EXISTING PANELBOARD IN THIS LOCATION AND REPLACE WITH NEW PANEL BOARD AS SHOWN
  - 2 REMAINS
  - 3 SEE DETAIL A3-A41 FOR ARCHITECTURAL WORK



**A3 CRUMB LIBRARY - FIRST FLOOR PLAN**  
SCALE: 1/8" = 1'-0"



**C&S Engineers, Inc.**  
499 Col. Eileen Collins Blvd.  
Syracuse, New York 13212  
Phone: 315-455-2000  
Fax: 315-455-9687  
www.cscos.com

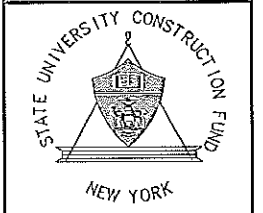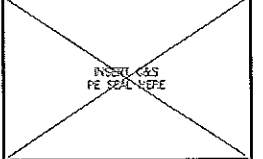

**STATE UNIVERSITY CONSTRUCTION FUND**  
SUCF PROJECT NO. 12290  
**STATE UNIVERSITY OF NEW YORK AT POTSDAM**  
**PRE-BID SUBMISSION - NOT FOR CONSTRUCTION**  
**UPGRADE ELECTRICAL DISTRIBUTION SYSTEMS**  
**VARIOUS BUILDINGS**



MARK	DATE	DESCRIPTION
		REVISIONS
		PROJECT NO: 150453-001
		DATE: DECEMBER 5, 2008
		SCALE: AS SHOWN
		DRAWN BY: P.N.LIU
		DESIGNED BY: T.G. HILKINOWICZ
		CHECKED BY: J.L. ROSSINI, P.E.

NO ALTERATION PERMITTED HEREOF EXCEPT AS PROVIDED UNDER SECTION 7209 SUBDIVISION 2 OF THE NEW YORK EDUCATION LAW

**ELECTRICAL**  
**CRUMB LIBRARY**  
**BASEMENT & 1ST**  
**FLOOR PLANS**

**E-100-4a**



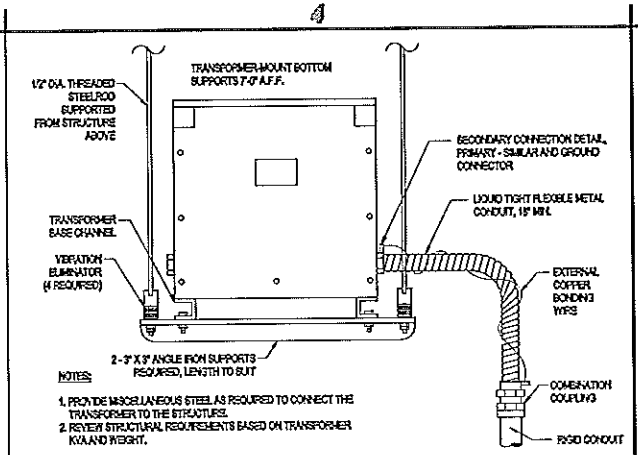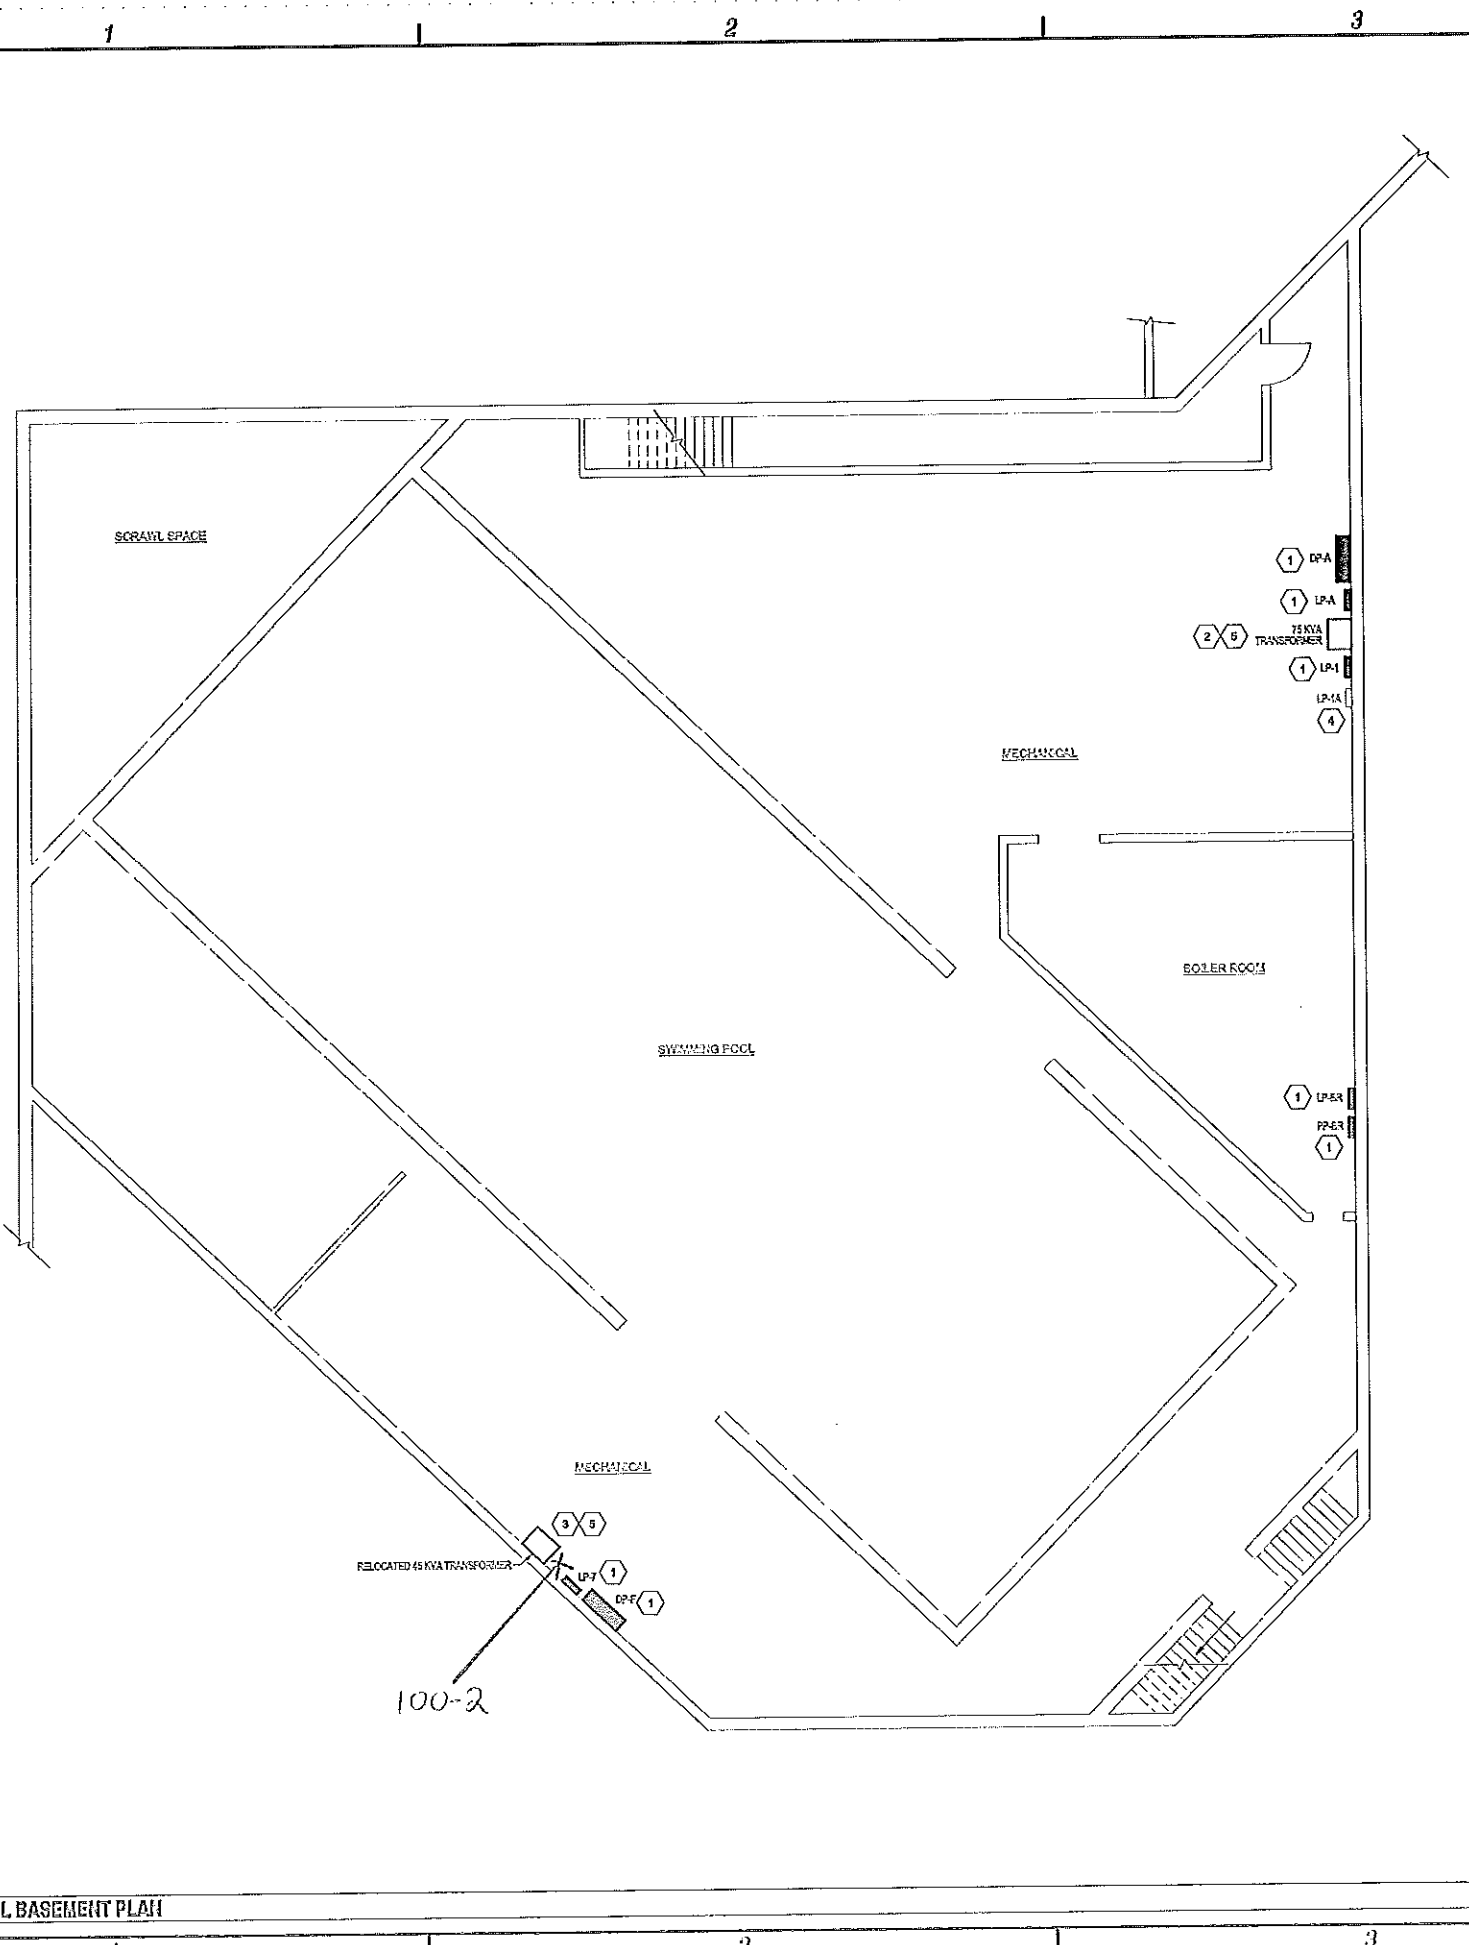

**D4 TRANSFORMER SUSPENSION DETAIL**  
SCALE: NOT TO SCALE

- NOTES:**
1. PROVIDE MISCELLANEOUS STEEL AS REQUIRED TO CONNECT THE TRANSFORMER TO THE STRUCTURE.
  2. REVIEW STRUCTURAL REQUIREMENTS BASED ON TRANSFORMER KVA AND HEIGHT.


- DRAWING SPECIFIC NOTES:**
1. REMOVE EXISTING PANELS AS SHOWN IN THE LOCATION AND REPLACE WITH NEW PANELS AS SHOWN.
  2. REMOVE EXISTING 45 KVA TRANSFORMER AND REPLACE WITH 75 KVA TRANSFORMER. RELOCATE EXISTING 45 KVA TRANSFORMER PER NOTE 3 BELOW.
  3. REMOVE EXISTING 30 KVA TRANSFORMER. REPLACE WITH RELOCATED 45 KVA TRANSFORMER.
  4. REMAINS.
  5. TRAPEZE MOUNT TRANSFORMER. REMOVE EXISTING SUPPORTS AND PROVIDE NEW AS REQUIRED.
  6. MOVE PANEL UP AS REQUIRED TO MAINTAIN WORK SPACE AS REQUIRED BY NEG ARTICLE 110.



**KEY PLAN**  
SCALE: NOT TO SCALE



**C&S Engineers, Inc.**  
499 Col. Eileen Collins Blvd.  
Syracuse, New York 13212  
Phone: 315-455-2000  
Fax: 315-455-9937  
www.cscs.com

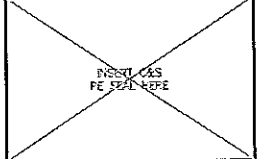

STATE UNIVERSITY CONSTRUCTION FUND  
NEW YORK

STATE UNIVERSITY CONSTRUCTION FUND  
SUCF PROJECT NO. 12290  
STATE UNIVERSITY OF NEW YORK AT POITSDAM  
PRE-BID SUBMISSION - NOT FOR CONSTRUCTION  
UPGRADE ELECTRICAL DISTRIBUTION SYSTEMS  
VARIOUS BUILDINGS

MARK	DATE	DESCRIPTION

REVISIONS	
PROJECT NO:	193.433.001
DATE:	DECEMBER 5, 2008
SCALE:	AS SHOWN
DRAWN BY:	P. H. LIU
DESIGNED BY:	M. R. HAYES, P.E.
CHECKED BY:	J. L. ROSSINI, P.E.

NO ALTERATION PERMITTED HEREON  
EXCEPT AS PROVIDED UNDER SECTION  
7207 SUBDIVISION 2 OF THE NEW YORK  
EDUCATION LAW


**ELECTRICAL**


**MAXCY  
PARTIAL  
BASEMENT PLAN**

**E-200-5**


**A1 MAXCY - PARTIAL BASEMENT PLAN**  
DATE: 12-5-08

**A1 KEY PLAN**  
DATE: 12-5-08

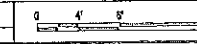

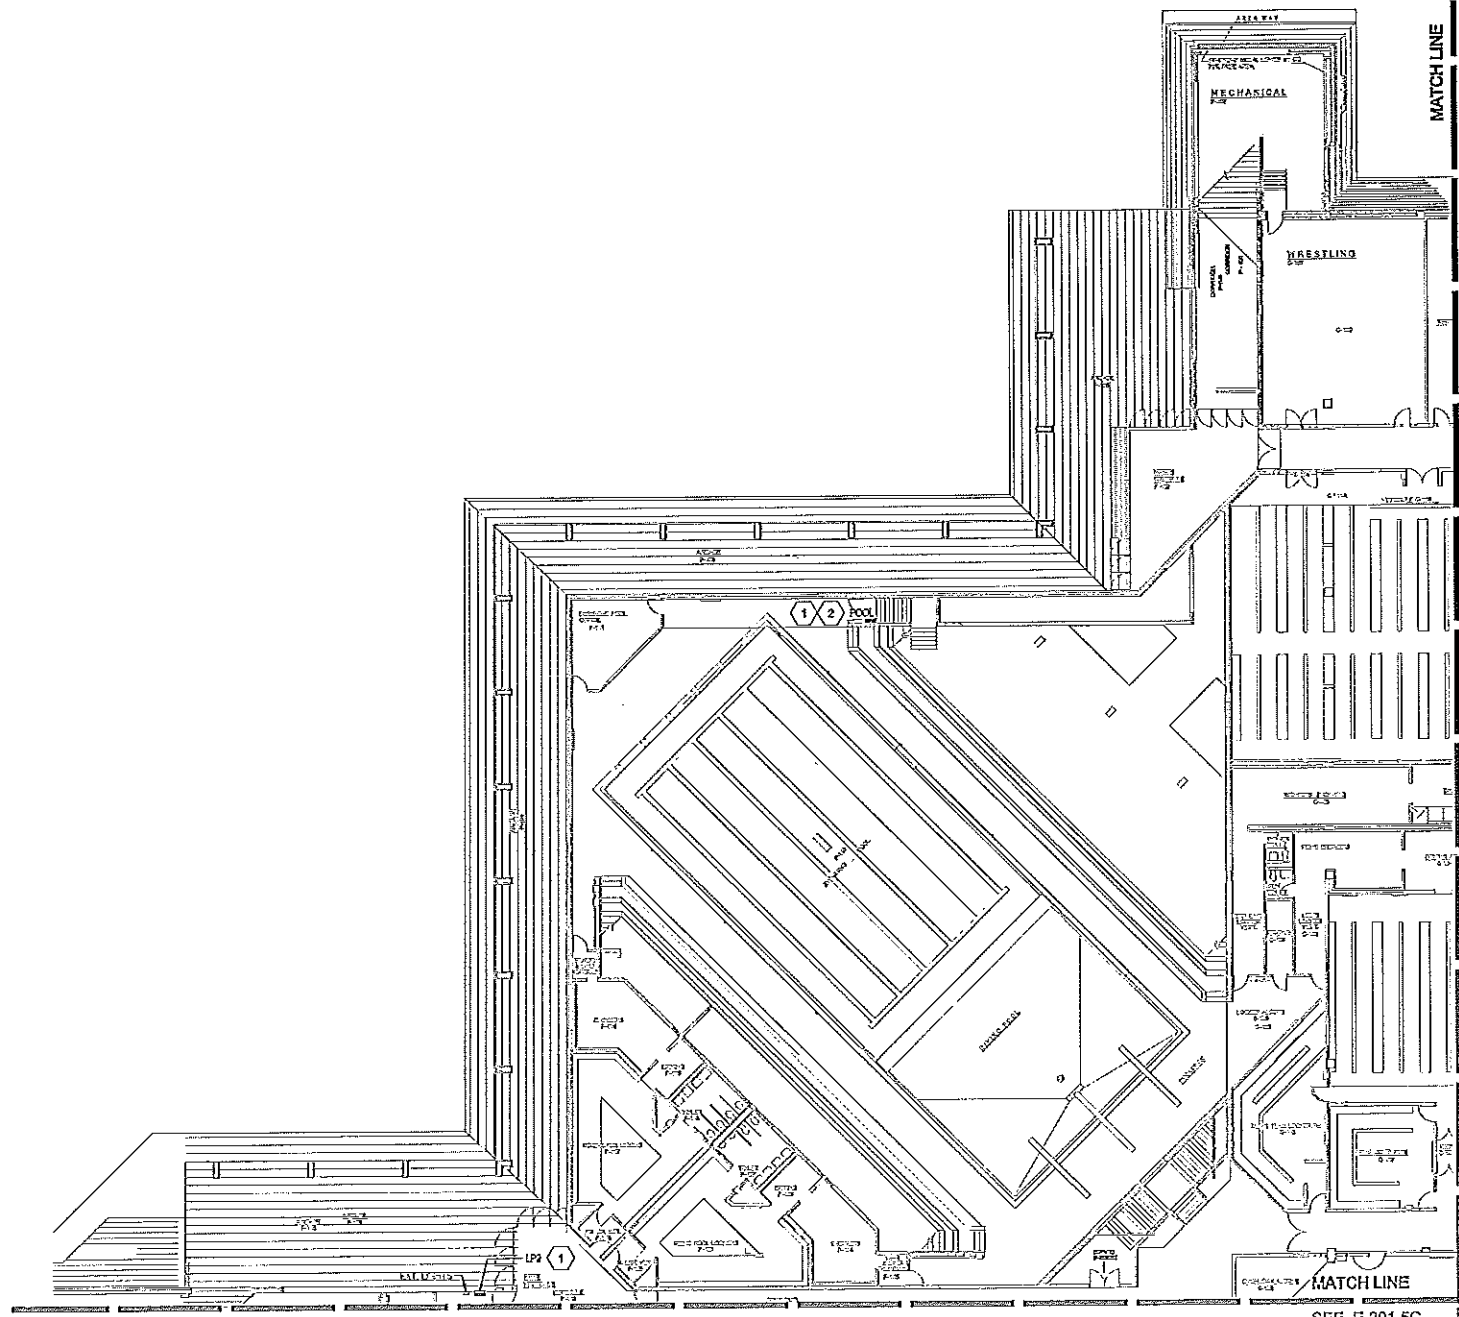

- DRAWING SPECIFIC NOTES:**
- 1 REMOVE EXISTING PANELBOARD IN THIS LOCATION AND REPLACE WITH NEW PANELBOARD AS SHOWN.
  - 2 PROVIDE NEW ENCLOSURE FOR THIS ELECTRICAL PANEL.


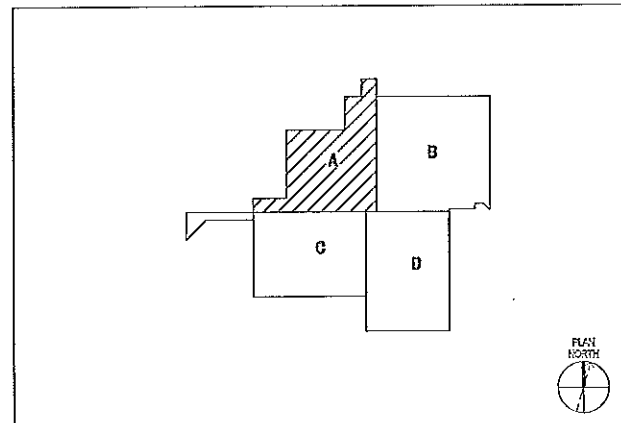


**A1 MAXCY - FIRST FLOOR PLAN**  
SCALE: 1/8" = 1'-0"

**A4 KEY PLAN**  
SCALE: 1/4" = 1'-0"



**C&S Engineers, Inc.**  
499 Col. Elton Collins Blvd.  
Syosset, New York 11791  
Phone: 516-455-2000  
Fax: 516-455-9687  
www.cscos.com

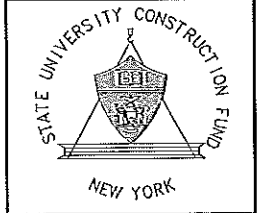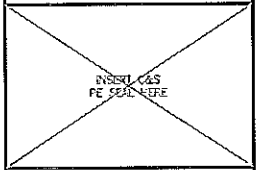

**STATE UNIVERSITY CONSTRUCTION FUND**  
SUCF PROJECT NO. 12290  
STATE UNIVERSITY OF NEW YORK AT POTSDAM  
**PRE-BID SUBMISSION - NOT FOR CONSTRUCTION**  
**UPGRADE ELECTRICAL DISTRIBUTION SYSTEMS**  
**VARIOUS BUILDINGS**


NO.	DATE	DESCRIPTION
REVISIONS		
PROJECT NO:	191453001	
DATE:	DECEMBER 5, 2003	
SCALE:	AS SHOWN	
DRAWN BY:	P.N. LIU	
DESIGNED BY:	M.R. HAYES, P.E.	
CHECKED BY:	J.L. ROBERTS, P.E.	
NO ALTERATION PERMITTED HEREON EXCEPT AS PROVIDED UNDER SECTION 7209 SUBDIVISION 2 OF THE NEW YORK EDUCATION LAW		

**ELECTRICAL**  
**MAXCY**  
**FIRST FLOOR**  
**PLAN**

**E-201-5a**


1 2 3 4

D  
C  
B  
A

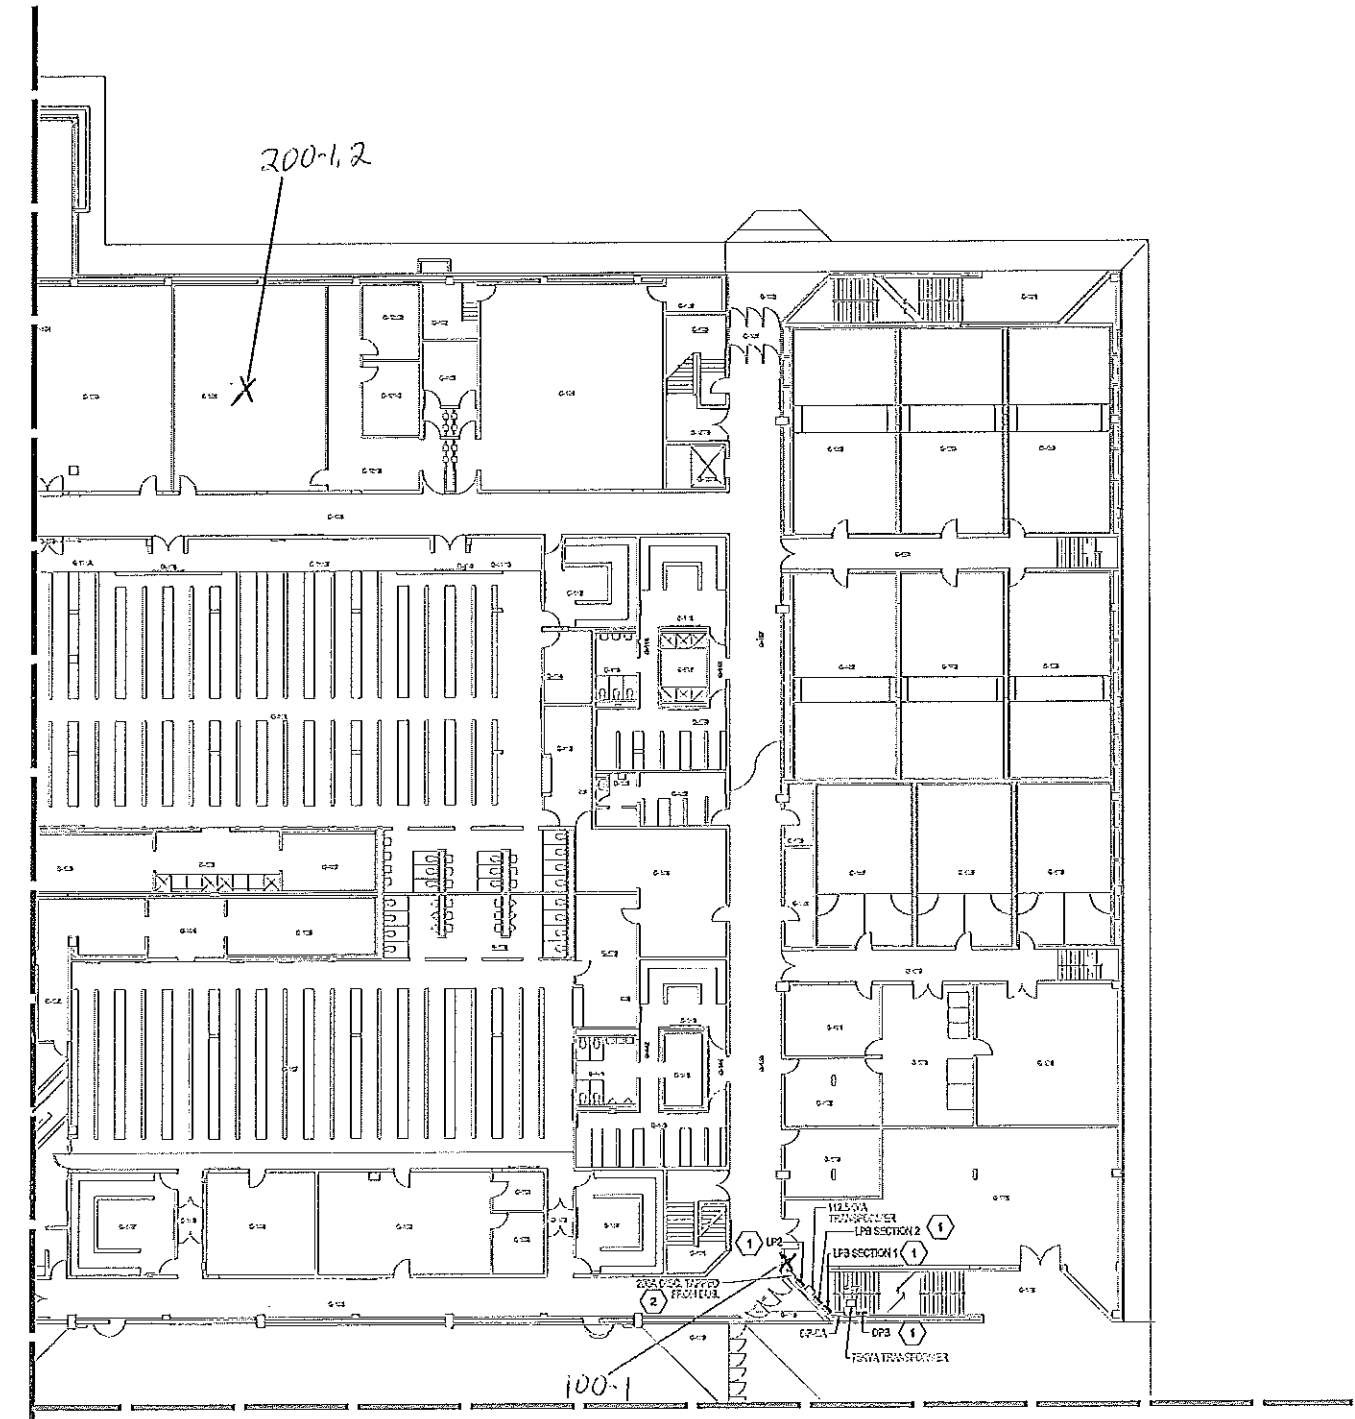

MATCH LINE  
SEE E-201-5A

- DRAWING SPECIFIC NOTES:**
- ① REMOVE EXISTING PANELS SHOWN IN THIS LOCATION AND REPLACE WITH NEW PANELS AS SHOWN
  - ② SWITCH REMOVED

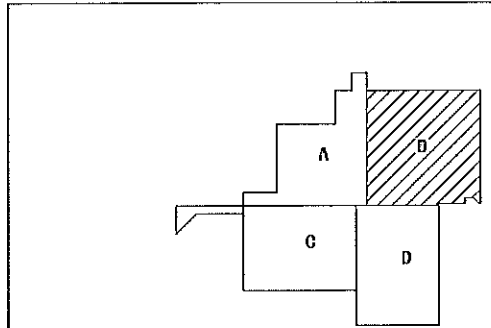

A1 MAXCY - FIRST FLOOR PLAN  
DATE: 11/14/12

A4 KEY PLAN  
DATE: 11/14/12



**C&S Engineers, Inc.**  
499 Col. Elson Collins Blvd.  
Syracuse, New York 13212  
Phone: 315-455-2000  
Fax: 315-455-9637  
www.cscos.com



STATE UNIVERSITY CONSTRUCTION FUND  
NEW YORK

STATE UNIVERSITY CONSTRUCTION FUND  
SUCF PROJECT NO. 12290  
STATE UNIVERSITY OF NEW YORK AT POTSDAM  
PRE-BID SUBMISSION - NOT FOR CONSTRUCTION  
UPGRADE ELECTRICAL DISTRIBUTION SYSTEMS  
VARIOUS BUILDINGS

MARK	DATE	DESCRIPTION

REVISIONS	
PROJECT NO:	190453-001
DATE:	DECEMBER 5, 2008
SCALE:	AS SHOWN
DRAWN BY:	P. H. LUJ
DESIGNED BY:	M. R. HAYES, P.E.
CHECKED BY:	J. L. ROBBINS, P.E.

NO ALTERATION PERMITTED HEREON EXCEPT AS PROVIDED UNDER SECTION 7209 SUBSECTION 2 OF THE NEW YORK EDUCATION LAW

**ELECTRICAL**

**MAXCY FIRST FLOOR PLAN**

E-201-5b


12/15/2008 - 01/06/2009  
 P. H. LUJ - SURVEYOR  
 M. R. HAYES - ELECTRICAL ENGINEER  
 J. L. ROBBINS - ELECTRICAL ENGINEER  
 E-201-5b





**C&S Engineers, Inc.**  
 499 Col. Elson Collins Blvd.  
 Syracuse, New York 13212  
 Phone: 315-455-2000  
 Fax: 315-455-9697  
 www.ccsinc.com

INSTALL GAS  
 PE SCHE HERE

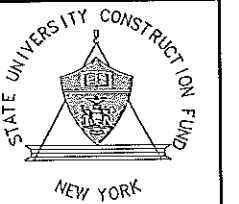

STATE UNIVERSITY CONSTRUCTION FUND  
 SUFC PROJECT NO. 12290  
 STATE UNIVERSITY OF NEW YORK AT POTSDAM  
**PRE-BID SUBMISSION - NOT FOR CONSTRUCTION**  
**UPGRADE ELECTRICAL DISTRIBUTION SYSTEMS  
 VARIOUS BUILDINGS**


MARK	DATE	DESCRIPTION

REVISIONS  
 PROJECT NO: 190.453.001  
 DATE: DECEMBER 5, 2003  
 SCALE: AS SHOWN  
 DRAWN BY: P.H. LIU  
 DESIGNED BY: R.M. HAYES, P.E.  
 CHECKED BY: J.L. ROBANS, P.E.  
 NO ALTERATION PERMITTED HEREON  
 EXCEPT AS PROVIDED UNDER SECTION  
 2209 SUBDIVISION 2 OF THE NEW YORK  
 EDUCATION LAW

ELECTRICAL  
**MAXCY  
 FIRST FLOOR  
 PLAN**



E-201-5c

**C3 MAXCY - PARTIAL FIRST FLOOR PLAN**  
 SCALE: 1/4" = 1'-0"

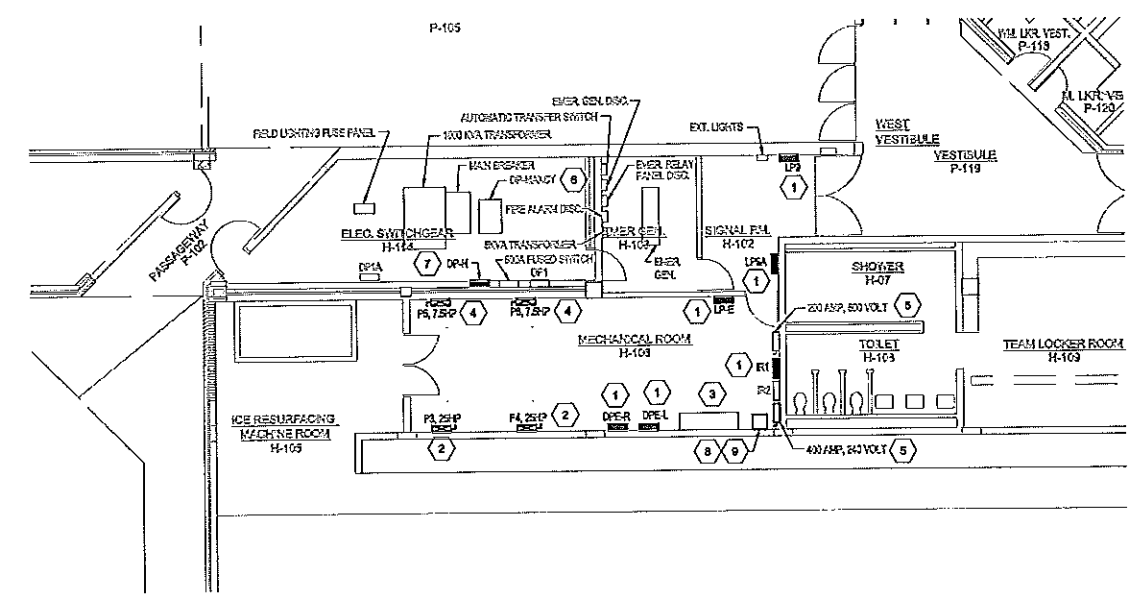

MATCH LINE  
 SEE E-201-5A


- GENERAL NOTE**  
 1. PANELS R1 AND R2 NOT LABELED IN FIELD. R1 STANDS FOR ICE RINK.
- DRAWING SPECIFIC NOTES**
- ① REMOVE EXISTING PANEL BOARD IN THIS LOCATION AND REPLACE WITH NEW PANEL BOARD AS SHOWN.
  - ② REMOVE EXISTING MOTOR STARTERS REPLACE WITH NEMA SIZE 2 CONVENTION STARTERS IN NEMA 4X ENCLOSURES. RECONNECT EXISTING CONTROLS.
  - ③ EXISTING MOTOR STARTERS REMAIN.
  - ④ REMOVE EXISTING MOTOR STARTERS REPLACE WITH NEMA SIZE 1 CONVENTION STARTERS IN NEMA 4X ENCLOSURES. RECONNECT EXISTING CONTROLS.
  - ⑤ REMOVE EXISTING FUSED DISCONNECT SWITCH REPLACE WITH 200 AMP, 3 POLE UNFUSED SWITCH.
  - ⑥ PROVIDE CIRCUIT BREAKER IN SPACE IN EXISTING SWITCH BOARD. SEE SHEET E-201-5 ON LINE DIAGRAM.
  - ⑦ PROVIDE DISTRIBUTION PANEL DP#1. SEE PANEL SCHEDULE ON E-201-5.
  - ⑧ REMOVE EXISTING 45 KVA TRANSFORMER MOUNTED ON FRAME SUPPORTED FROM CEILING. REMOVE FRAME.
  - ⑨ PROVIDE 112.5 KVA TRANSFORMER. PROVIDE NEW TRAFFIC MOUNT. SEE DETAIL ON SHEET E-201-5.

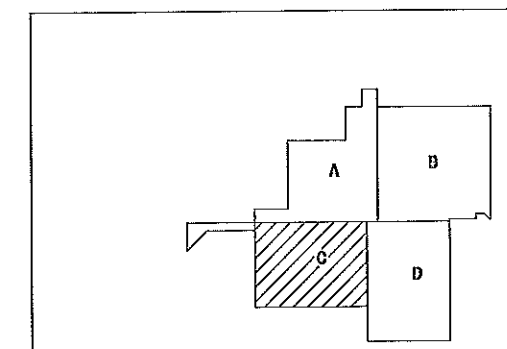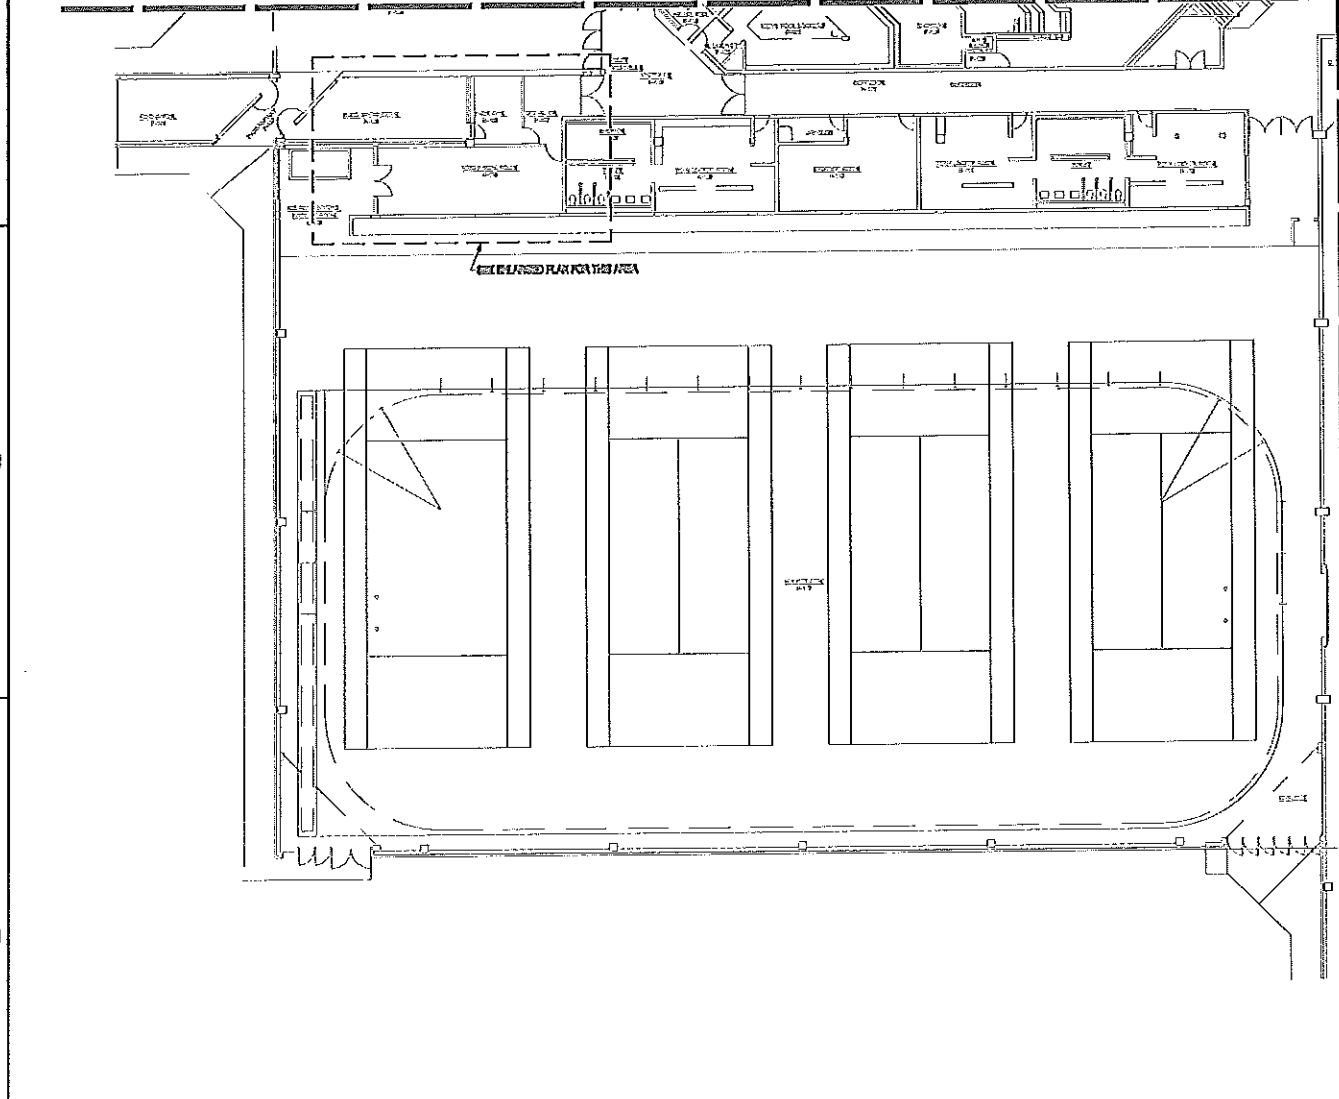

**A1 MAXCY - FIRST FLOOR PLAN**  
 SCALE: 1/4" = 1'-0"

**A4 KEY PLAN**  
 SCALE: 1/4" = 1'-0"



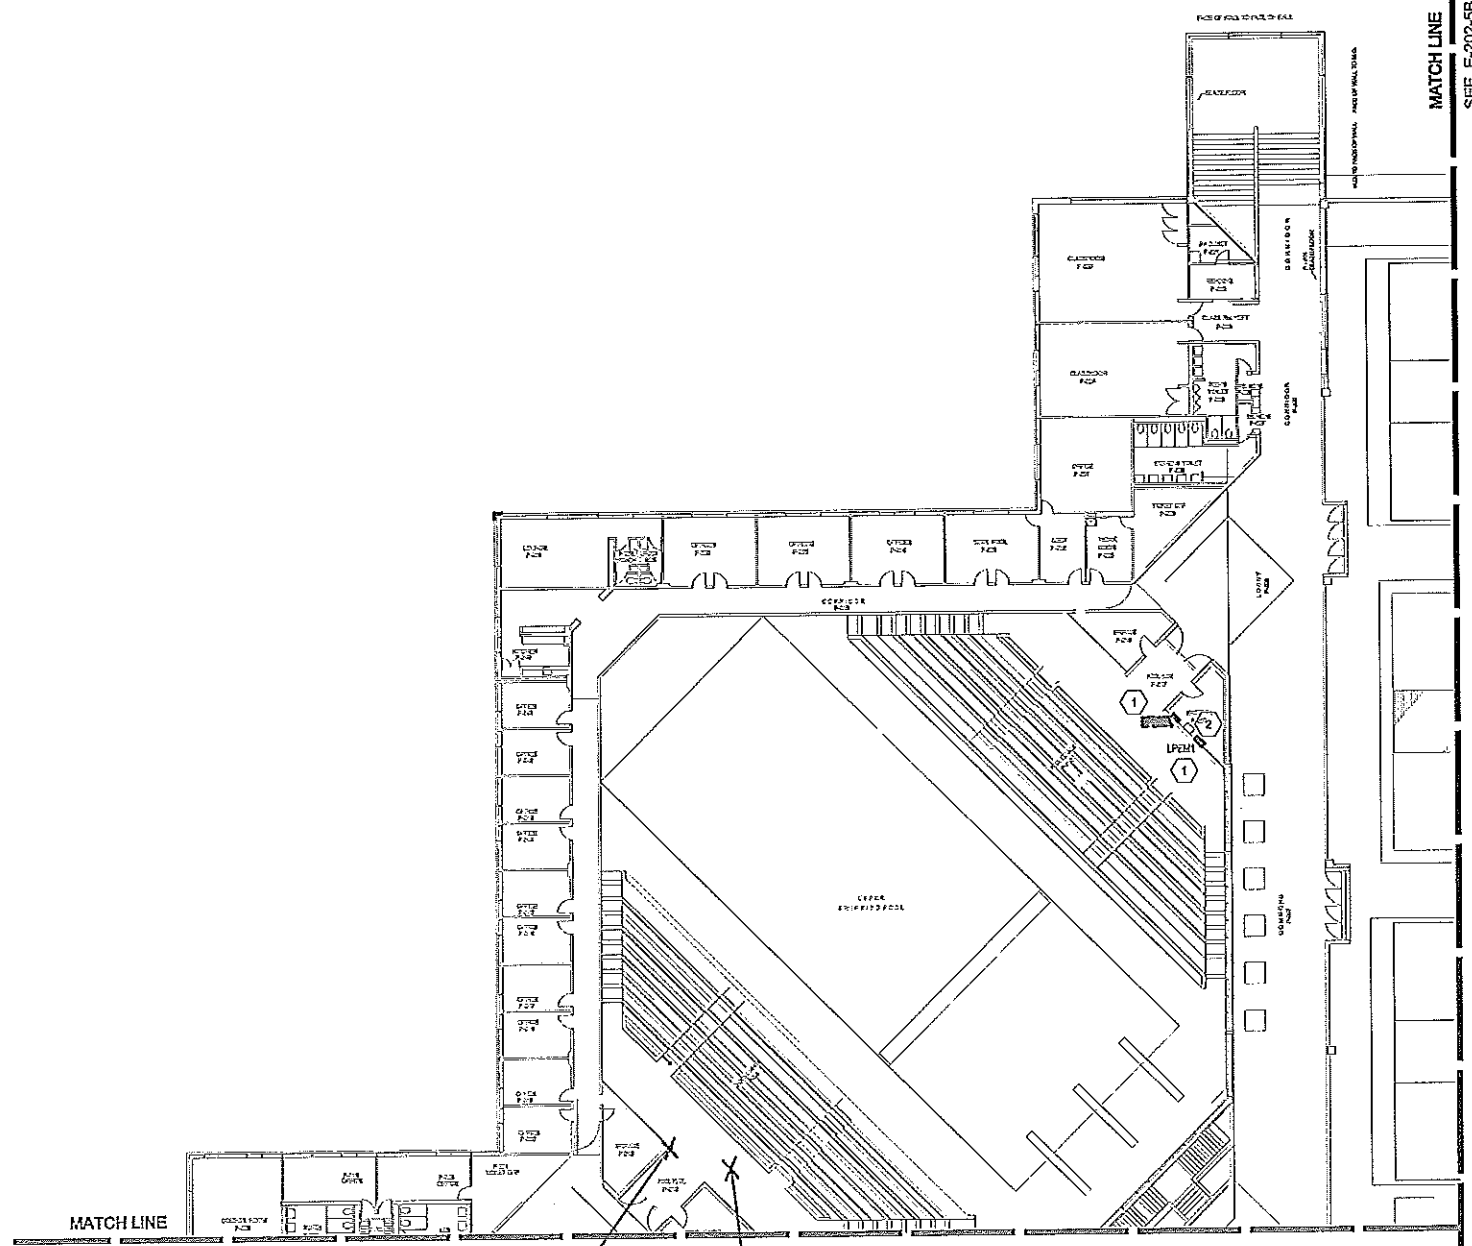


MATCH LINE  
SEE E-202-5C


MATCH LINE  
SEE E-202-5B

101-1,2  
201-1,2,3

- DRAWING SPECIFIC NOTES:
- ① REMOVE EXISTING PANELS IN THIS LOCATION AND REPLACE WITH NEW PANEL BOARD AS SHOWN.
  - ② EMERGENCY RELAY PANEL AND TRANSFORMER AS SHOWN.

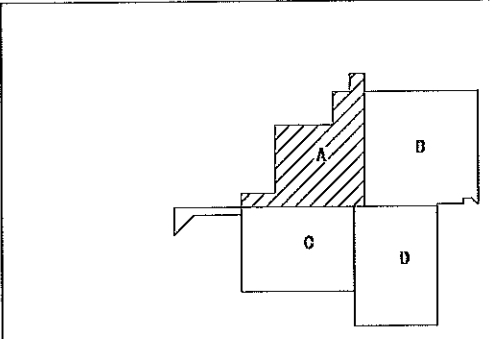


A1 MAXCY - SECOND FLOOR PLAN  
SCALE: 1/8" = 1'-0"

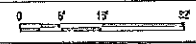

A4 KEY PLAN  
SCALE: 1/8" = 1'-0"



C&S Engineers, Inc.  
499 Col. Elton Collins Blvd.  
Syracuse, New York 13212  
Phone: 315-455-2000  
Fax: 315-455-9687  
www.ccsos.com

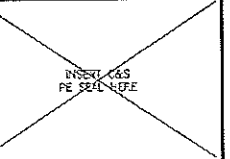

STATE UNIVERSITY CONSTRUCTION FUND  
NEW YORK

STATE UNIVERSITY CONSTRUCTION FUND  
SUCF PROJECT NO. 12290  
STATE UNIVERSITY OF NEW YORK AT POTSDAM  
PRE-BID SUBMISSION - NOT FOR CONSTRUCTION  
UPGRADE ELECTRICAL DISTRIBUTION SYSTEMS  
VARIOUS BUILDINGS

MARK	DATE	DESCRIPTION

PROJECT NO: 100453.001  
DATE: DECEMBER 5, 2009  
SCALE: AS SHOWN  
DRAWN BY: P.H.UJ  
DESIGNED BY: M.R.HAYES, P.E.  
CHECKED BY: J.L.ROSEN, P.E.  
NO ALTERATION PERMITTED HEREON  
EXCEPT AS PROVIDED UNDER SECTION  
7209 SUBDIVISION 2 OF THE NEW YORK  
EDUCATION LAW


ELECTRICAL  
MAXCY  
SECOND FLOOR  
PLAN

E-202-5a


JUN 10, 2010 10:00 AM - 06/10/2010 10:00 AM - 06/10/2010 10:00 AM - 06/10/2010 10:00 AM - 06/10/2010 10:00 AM  
 PLOT: E-202-5a.dwg  
 PLOT DATE: 6/10/2010 10:00 AM  
 PLOT TIME: 10:00 AM  
 PLOT USER: J.L.ROSEN  
 PLOT DEVICE: HPGL  
 PLOT SCALE: 1/8" = 1'-0"  
 PLOT SHEET: 1 OF 1  
 PLOT STATUS: SUCCESS

1 2 3 4

D  
C  
B  
A

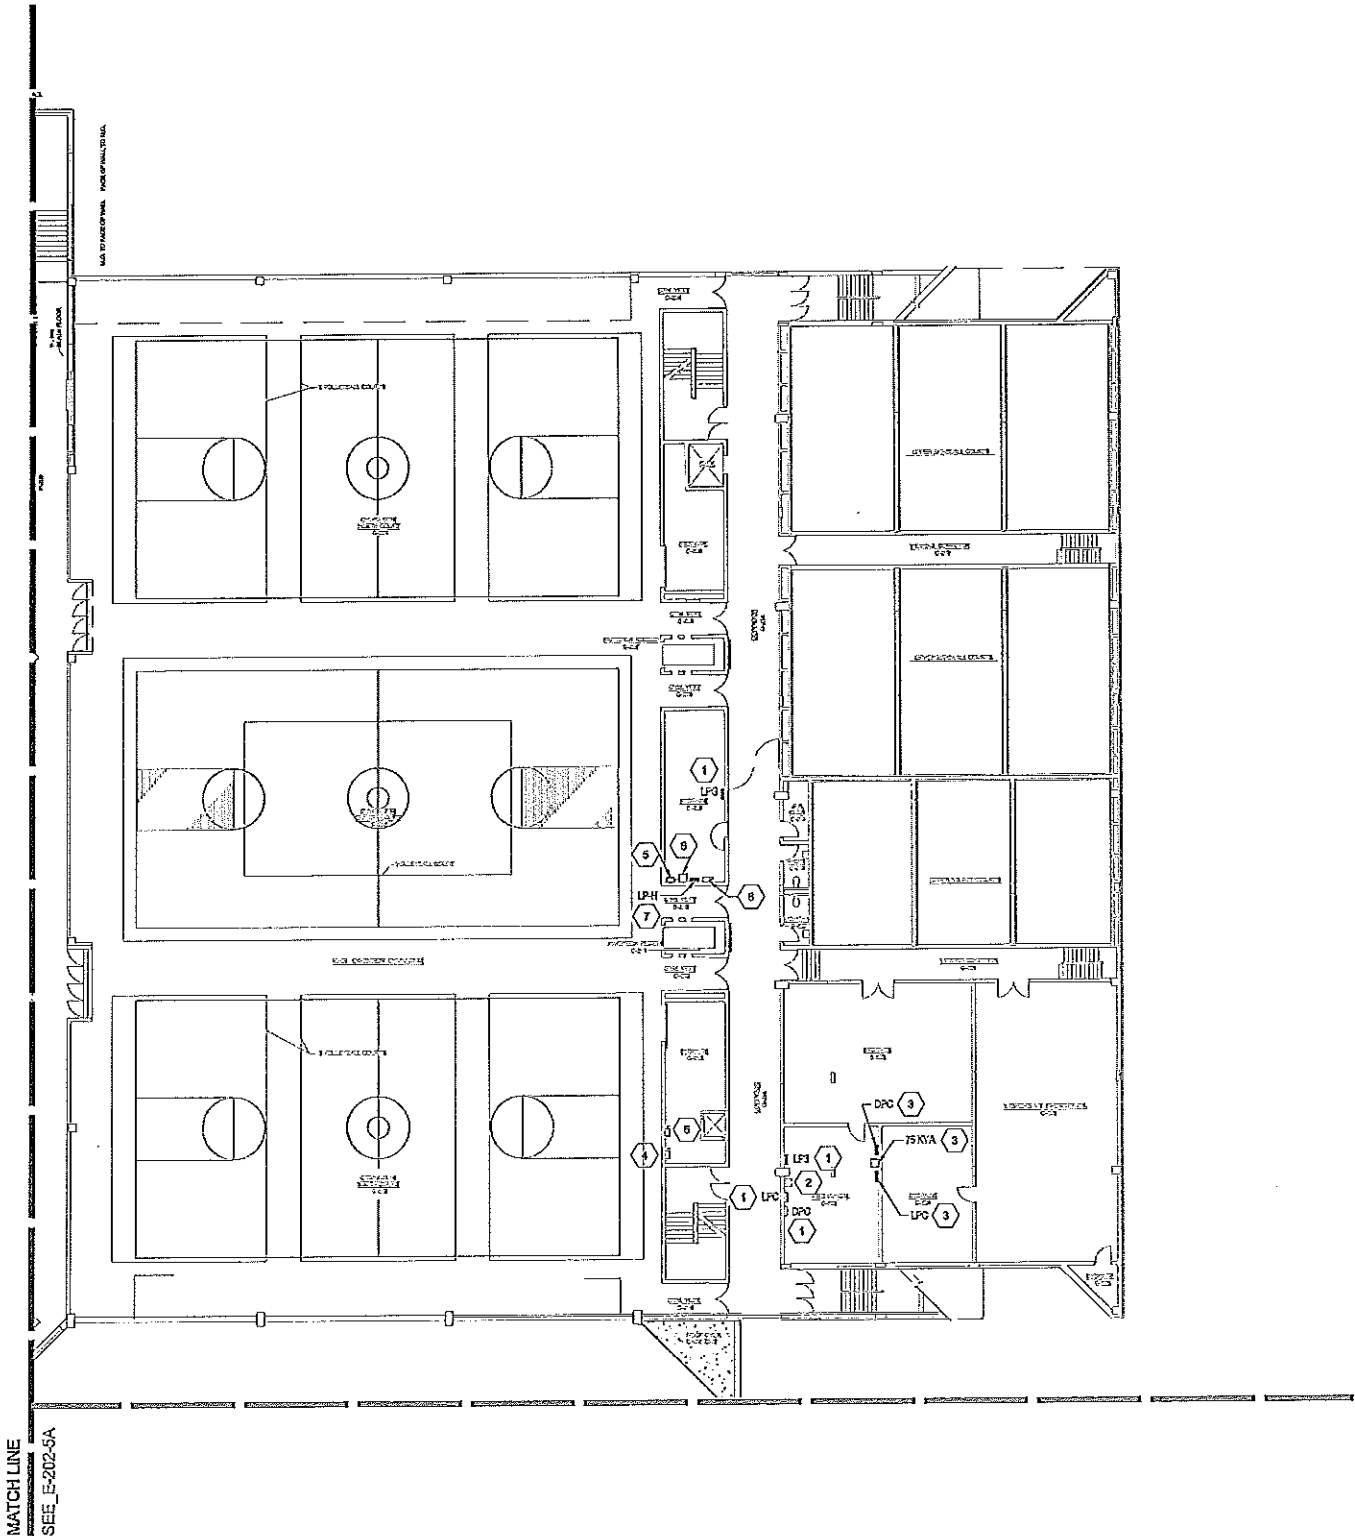

- GENERAL NOTE**  
1. EXTEND CIRCUITS TO NEW PANELBOARDS AS REQUIRED.
- DRAWING SPECIFIC NOTES**
- 1 REMOVE EXISTING PANELBOARD IN THIS LOCATION AND REPLACE WITH NEW PANEL BOARD AS SHOWN. LPO AND DPO TO BE RELOCATED. REPLACEMENT PANELBOARD FOR LPS SHALL BE INSTALLED IN SAME LOCATION AS EXISTING.
  - 2 REMOVE 50 KVA TRANSFORMER. INSTALL 75 KVA TRANSFORMER RELOCATED FROM ELECTRIC ROOM SHOWN ON SHEET E-202-5A.
  - 3 NEW LOCATION FOR DPO, LPO, AND TRANSFORMER. EXTEND BRANCH CIRCUITS AS REQUIRED.
  - 4 EXISTING 200 AMP FUSED SWITCH REMAINS.
  - 5 PROVIDE 400 AMP UNFUSED SWITCH.
  - 6 PROVIDE 150 KVA TRANSFORMER.
  - 7 PROVIDE PANEL LPHL.
  - 8 PROVIDE 200 AMP UNFUSED SWITCH.

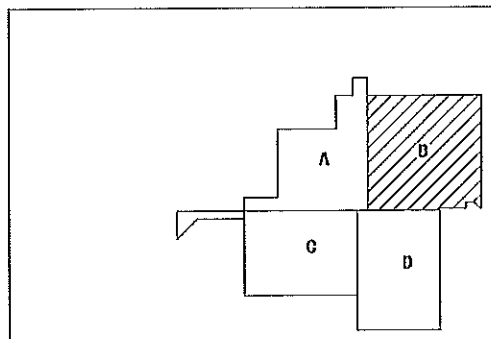


A1 MAXCY - SECOND FLOOR PLAN  
SCALE: 1/8" = 1'-0"

0 6 12 24  
A4 KEY PLAN  
SCALE: 1/8" = 1'-0"



**C&S Engineers, Inc.**  
499 Col. Eisen Collins Blvd.  
Syosset, New York 11791  
Phone: 315-455-2000  
Fax: 315-455-6667  
www.cscos.com

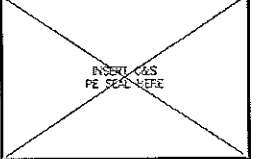

STATE UNIVERSITY CONSTRUCTION FUND  
NEW YORK

STATE UNIVERSITY CONSTRUCTION FUND  
SUCF PROJECT NO. 12290  
STATE UNIVERSITY OF NEW YORK AT POTSDAM  
PRE-BID SUBMISSION - NOT FOR CONSTRUCTION  
UPGRADE ELECTRICAL DISTRIBUTION SYSTEMS  
VARIOUS BUILDINGS



MARK	DATE	DESCRIPTION
		REVISIONS
		PROJECT NO: 191-453101
		DATE: DECEMBER 5, 2009
		SCALE: AS SHOWN
		DRAWN BY: P.M. LUU
		DESIGNED BY: R.M. HAVES, P.E.
		CHECKED BY: J.L. ROSSINI, P.E.
NO ALTERATION PERMITTED HEREON EXCEPT AS PROVIDED UNDER SECTION 7203 SUBDIVISION 2 OF THE NEW YORK EDUCATION LAW		

ELECTRICAL  
MAXCY  
SECOND FLOOR  
PLAN

E-202-5b



**C&S Engineers, Inc.**  
 499 Co. J. Eisen Collins Blvd.  
 Syracuse, New York 13212  
 Phone: 315-455-2000  
 Fax: 315-455-9687  
 www.cscos.com

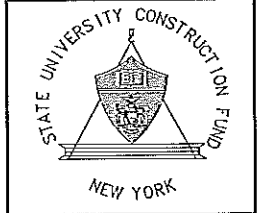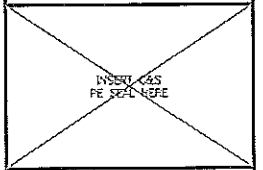


**STATE UNIVERSITY CONSTRUCTION FUND**  
 SUCC PROJECT NO. 12290  
 STATE UNIVERSITY OF NEW YORK AT POTSDAM  
**PRE-BID SUBMISSION - NOT FOR CONSTRUCTION**  
**UPGRADE ELECTRICAL DISTRIBUTION SYSTEMS**  
**VARIOUS BUILDINGS**


MARK	DATE	DESCRIPTION
REVISIONS		
PROJECT NO: 191.631.001		
DATE: DECEMBER 5, 2003		
SCALE: AS SHOWN		
DRAWN BY: P.H. LIU		
DESIGNED BY: MR. HAYES, P.E.		
CHECKED BY: J.L. ROBERTS, P.E.		
NO ALTERATION PERMITTED HEREON EXCEPT AS PROVIDED UNDER SECTION 7209 SUBDIVISION 2 OF THE NEW YORK EDUCATION LAW		

**ELECTRICAL**  
**MAXCY**  
**SECOND FLOOR**  
**PLAN**

**E-202-5c**

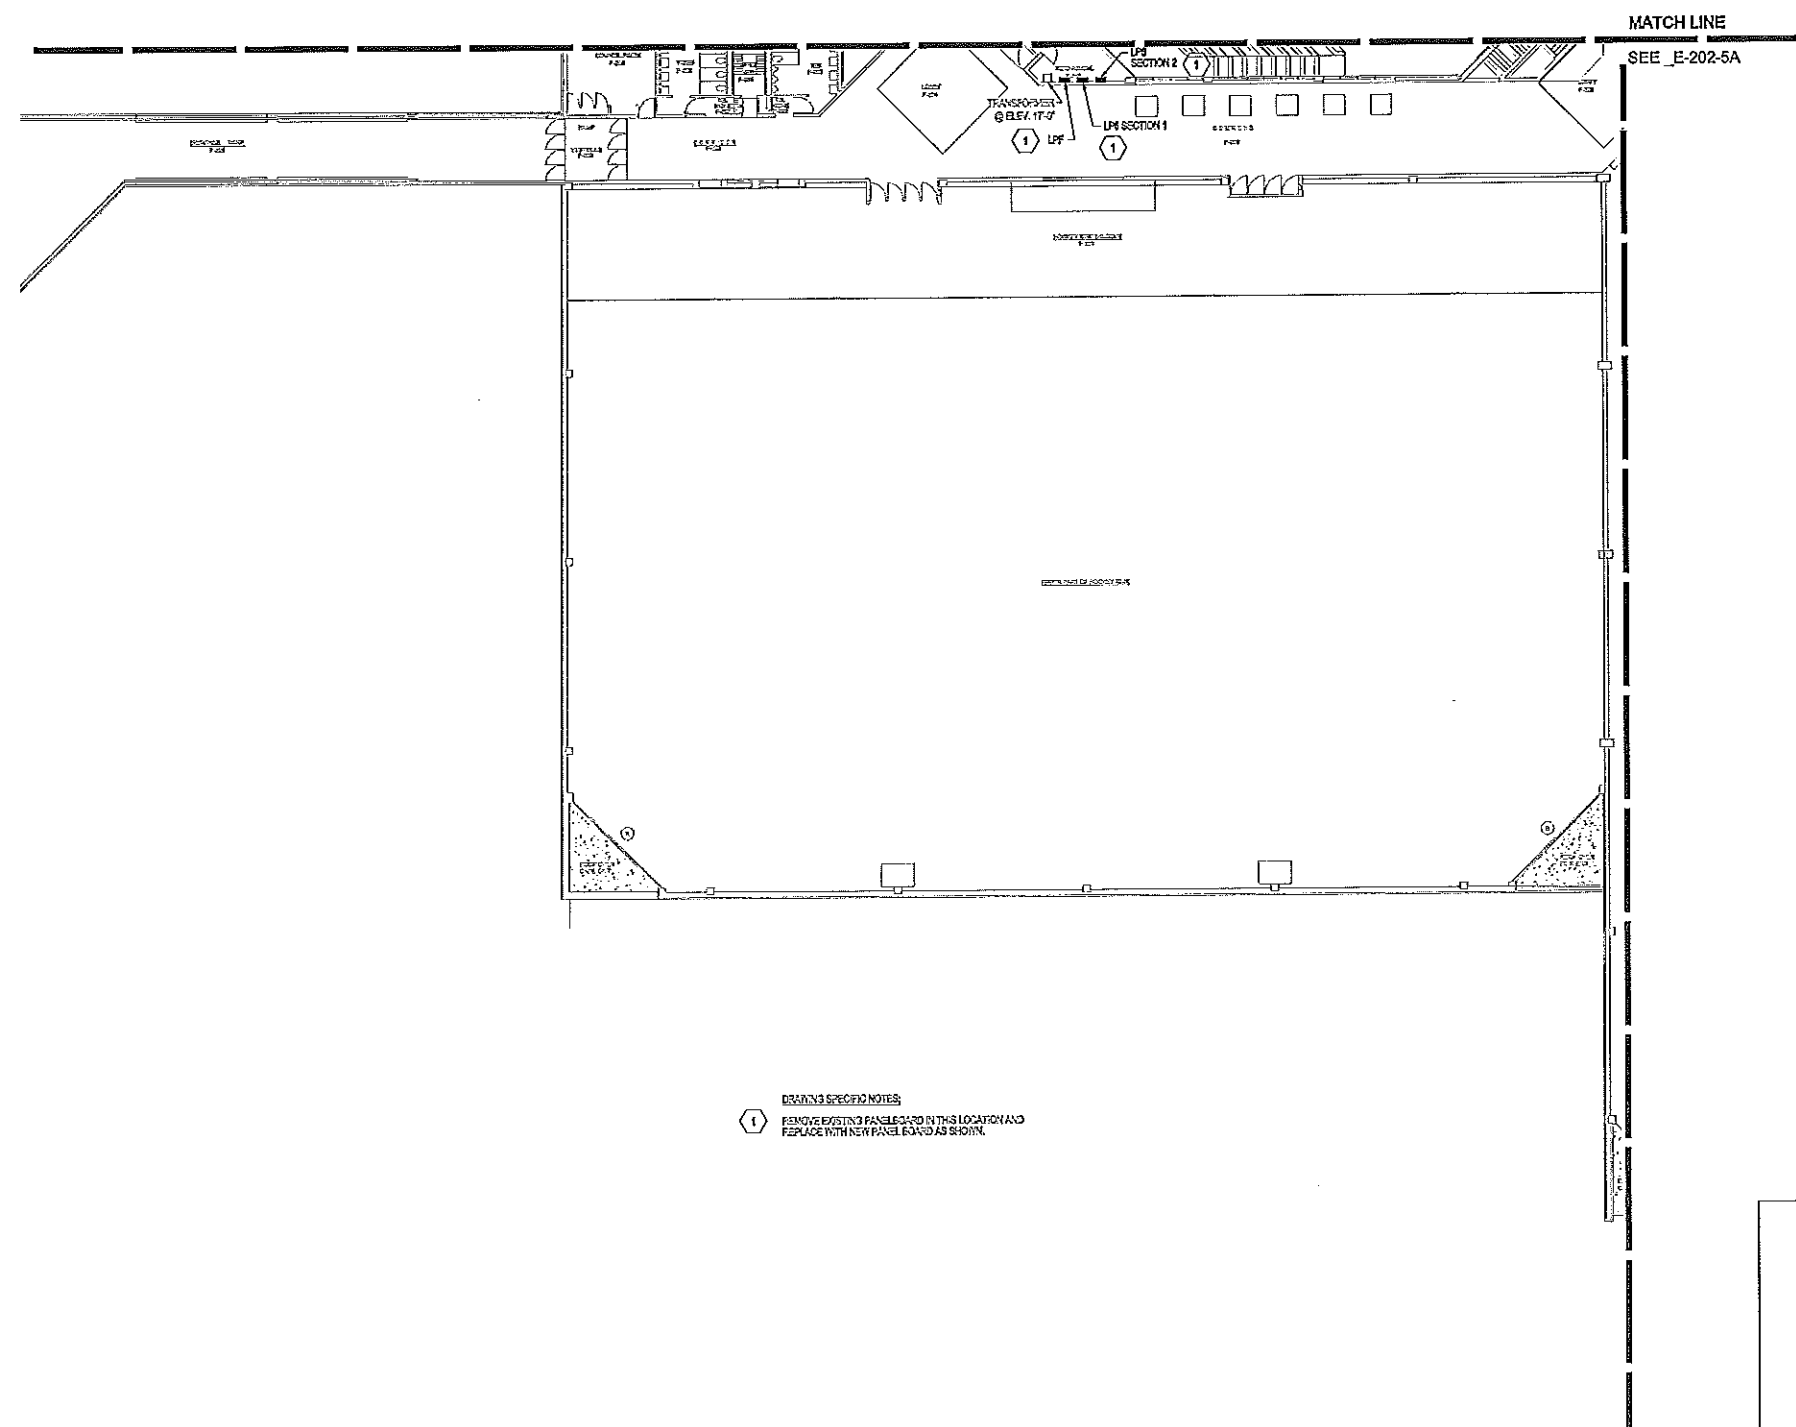


**DRAWING SPECIFIC NOTES**  
 1 REMOVE EXISTING PANEL BOARD IN THIS LOCATION AND REPLACE WITH NEW PANEL BOARD AS SHOWN.

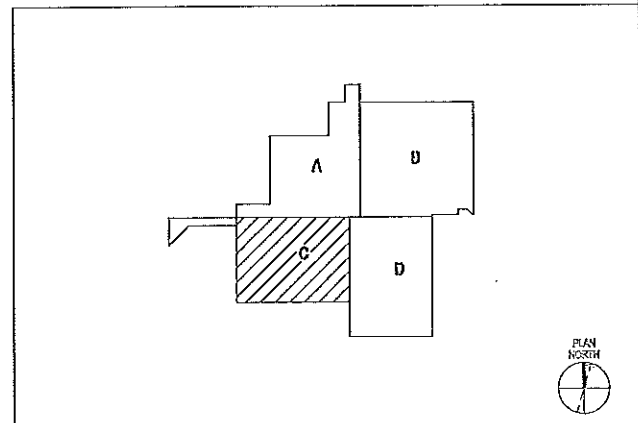

**A1 MAXCY - SECOND FLOOR PLAN**  
 SCALE: 1/8" = 1'-0"

**A4 KEY PLAN**  
 SCALE: NOT TO SCALE

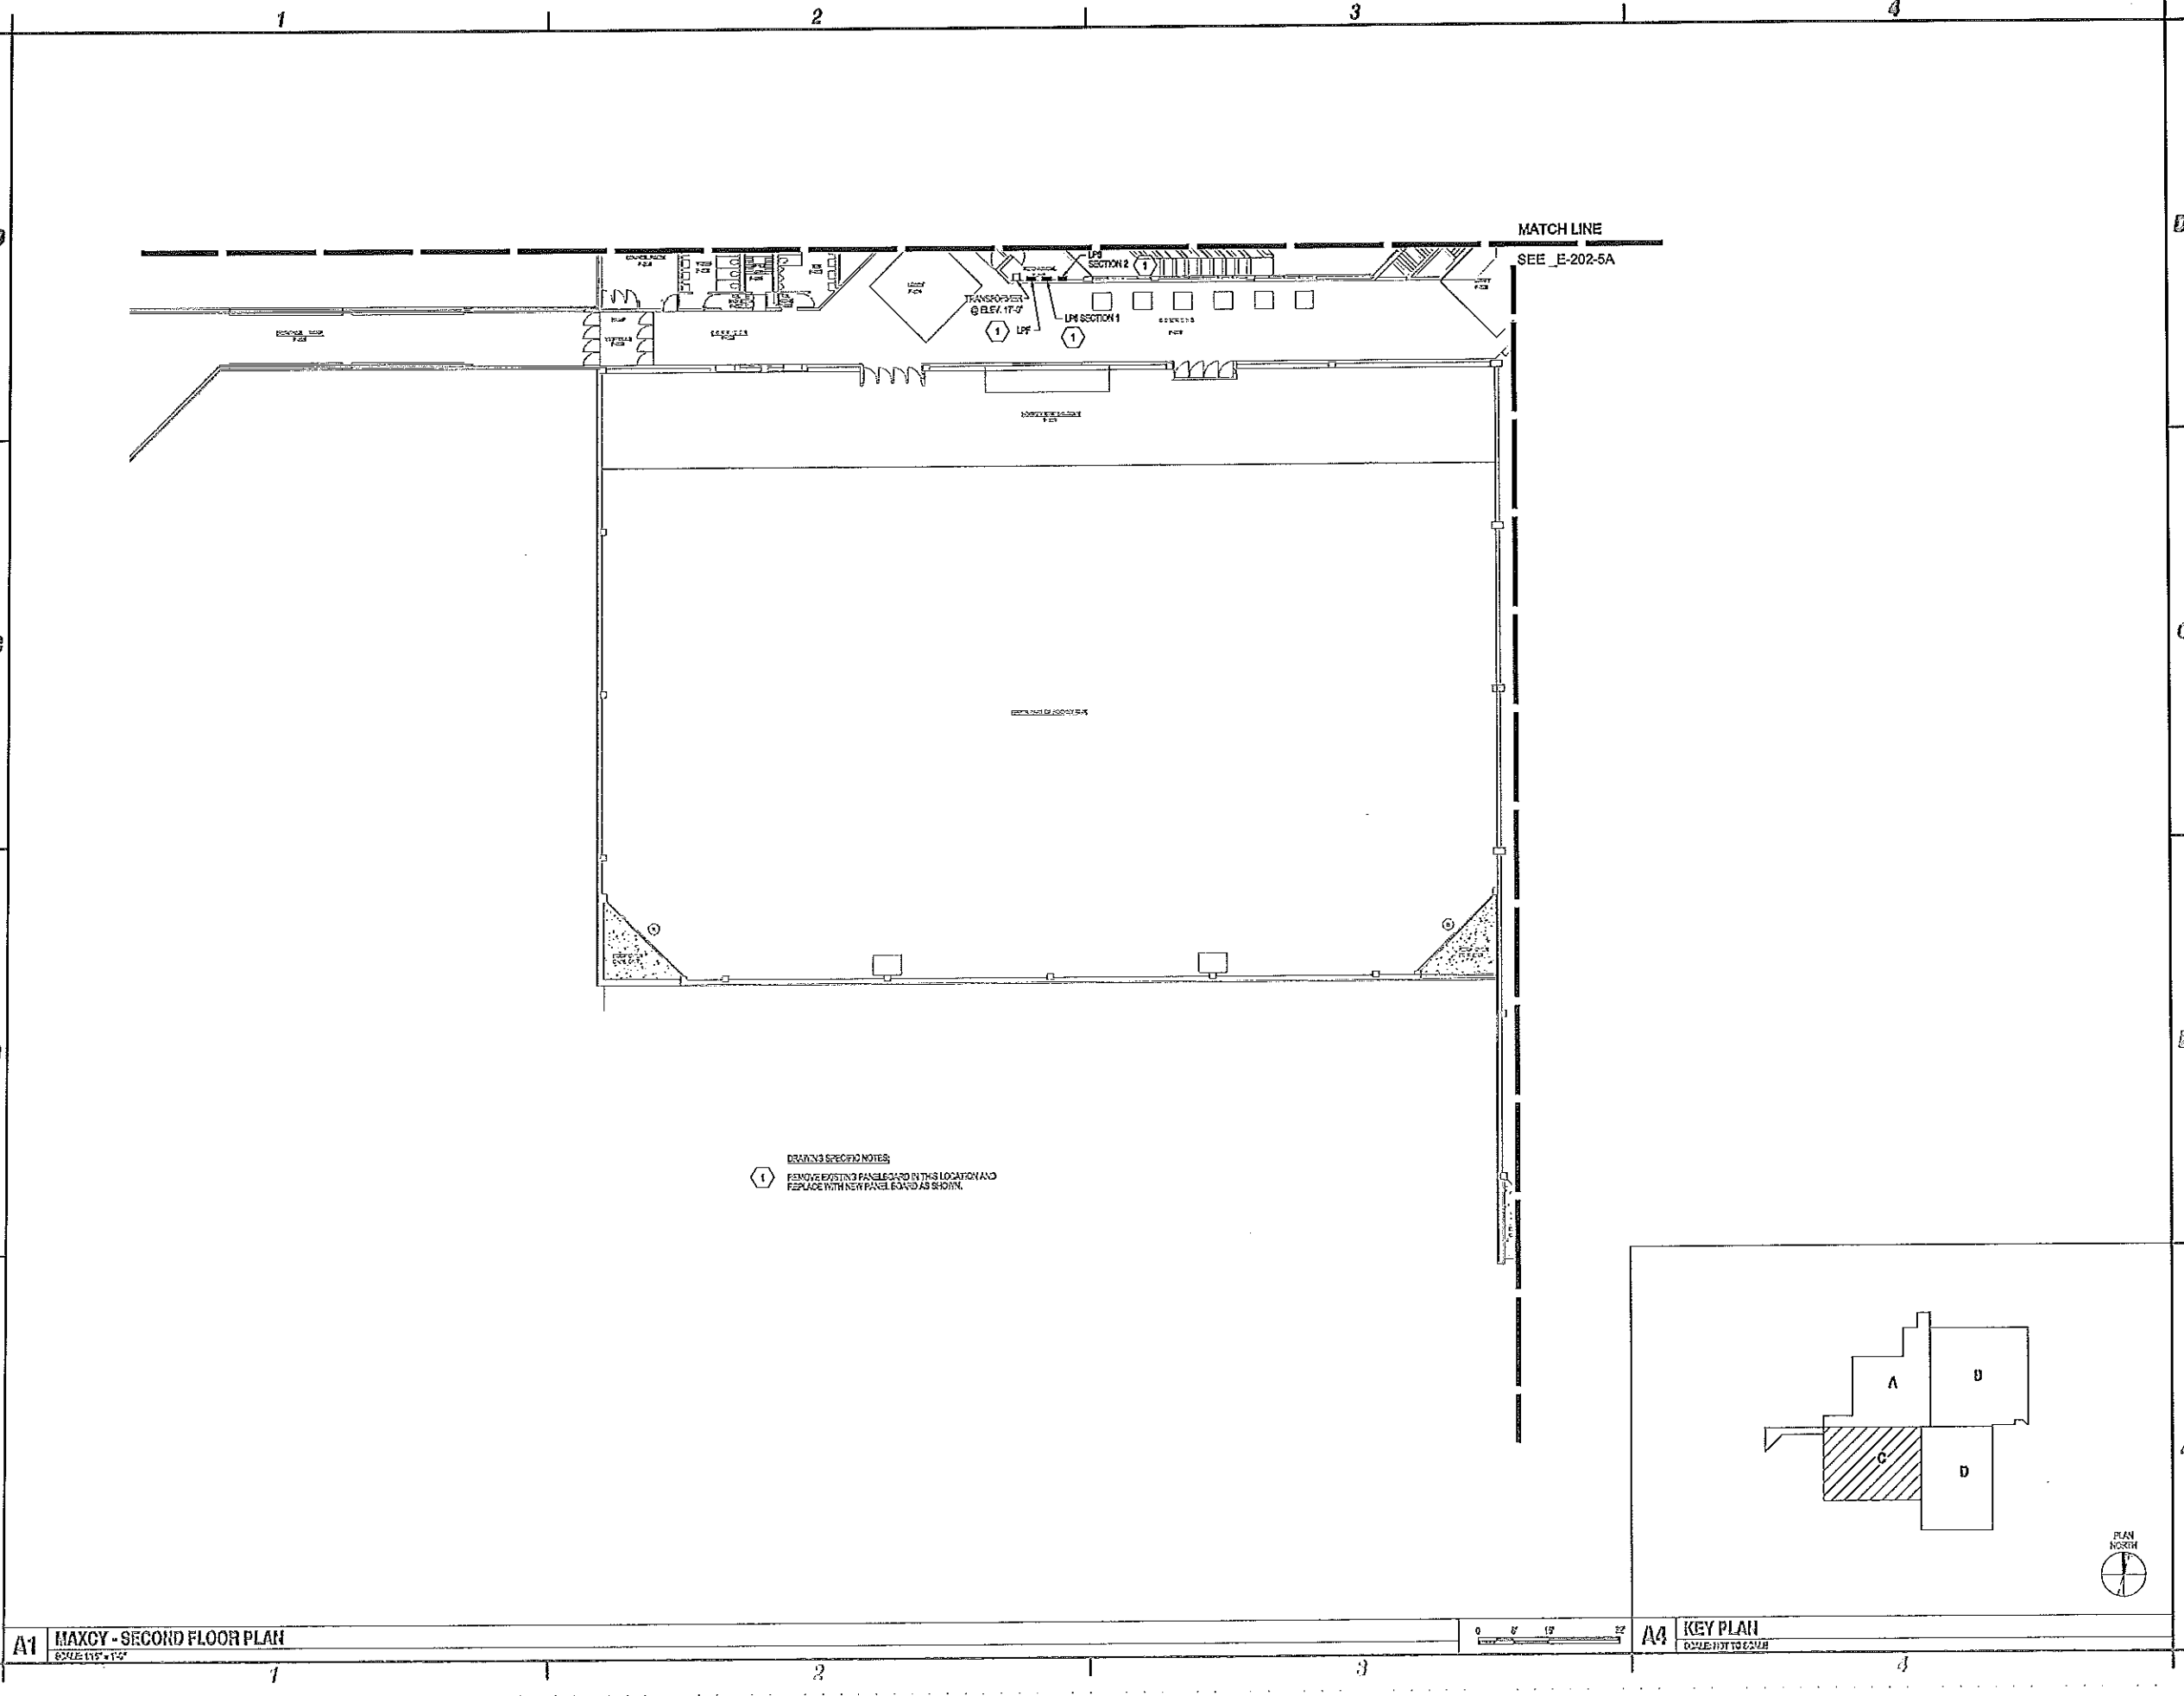



C&S Engineers, Inc.  
499 Col. Eileen Collins Blvd.  
Syracuse, New York 13212  
Phone: 315-455-2000  
Fax: 315-455-9697  
www.cscs.com



STATE UNIVERSITY CONSTRUCTION FUND  
NEW YORK

STATE UNIVERSITY CONSTRUCTION FUND  
SUCF PROJECT NO. 12290  
STATE UNIVERSITY OF NEW YORK AT POTSDAM  
PRE-BID SUBMISSION - NOT FOR CONSTRUCTION  
UPGRADE ELECTRICAL DISTRIBUTION SYSTEMS  
VARIOUS BUILDINGS

MARK	DATE	DESCRIPTION







REVISIONS

PROJECT NO: 190453.001  
DATE: DECEMBER 5, 2003  
SCALE: AS SHOWN  
DRAWN BY: R.N.UJJ  
DESIGNED BY: M.R.HAVES, P.E.  
CHECKED BY: J.L.ROSEN, P.E.

NO ALTERATION PERMITTED HEREON  
EXCEPT AS PROVIDED UNDER SECTION  
2209 SUBDIVISION 2 OF THE NEW YORK  
EDUCATION LAW

ELECTRICAL  
MAXCY  
THIRD FLOOR  
PLANS

E-203-5b

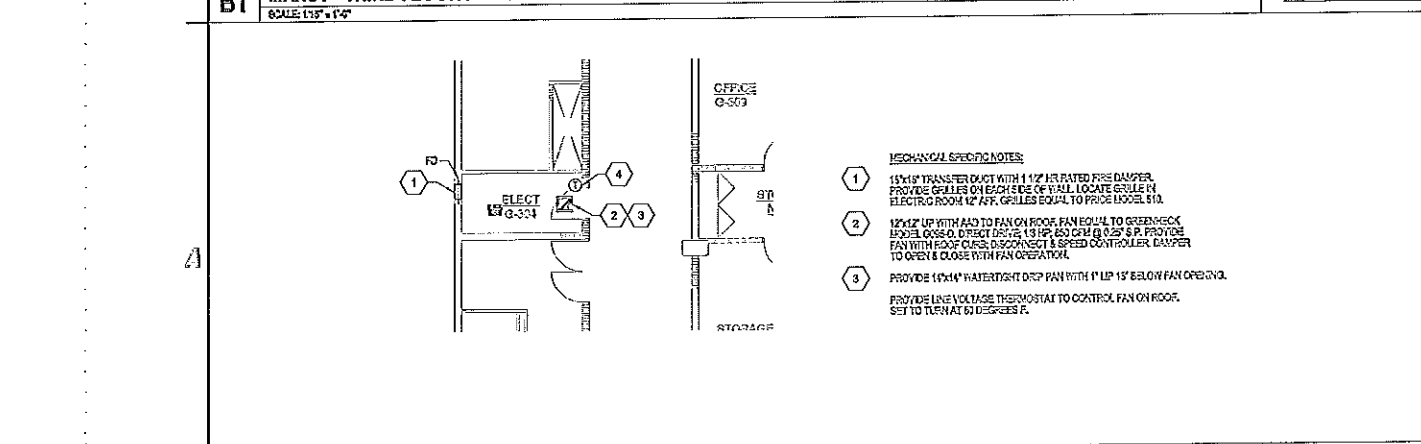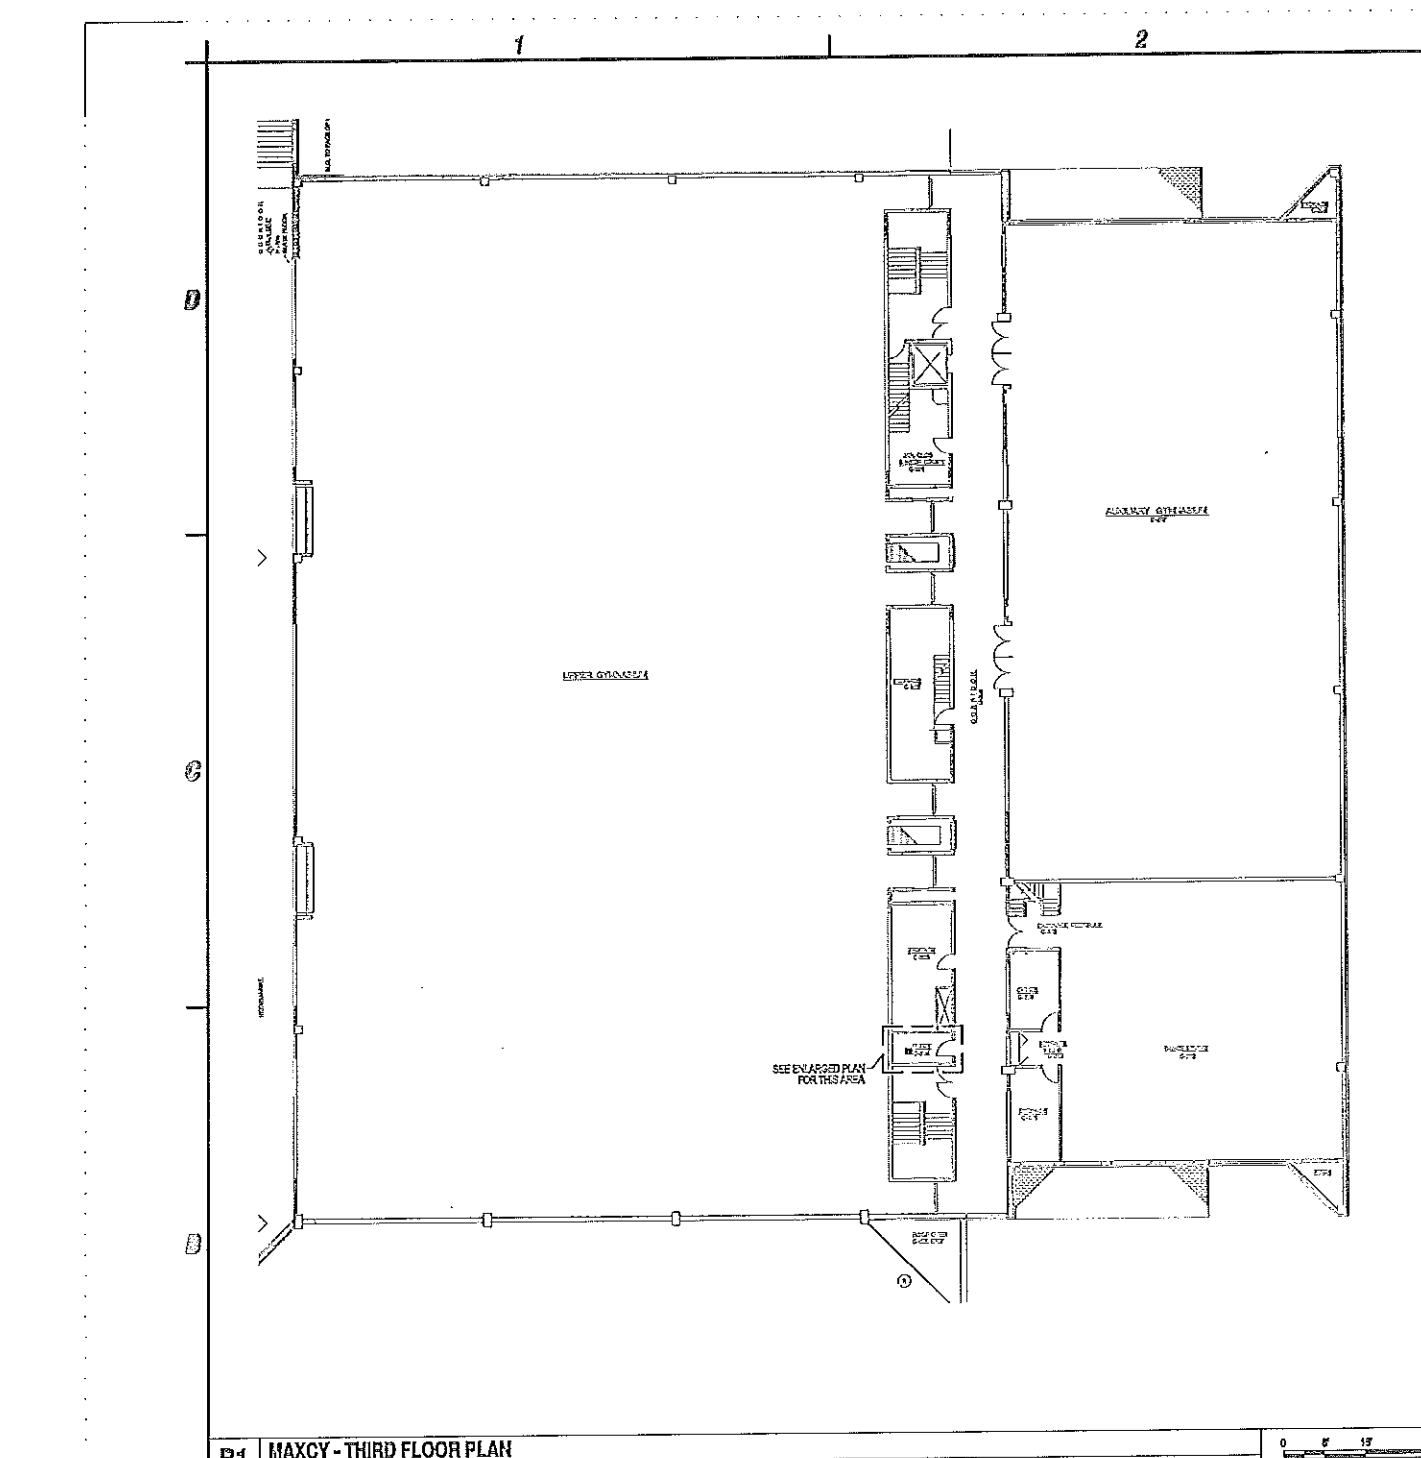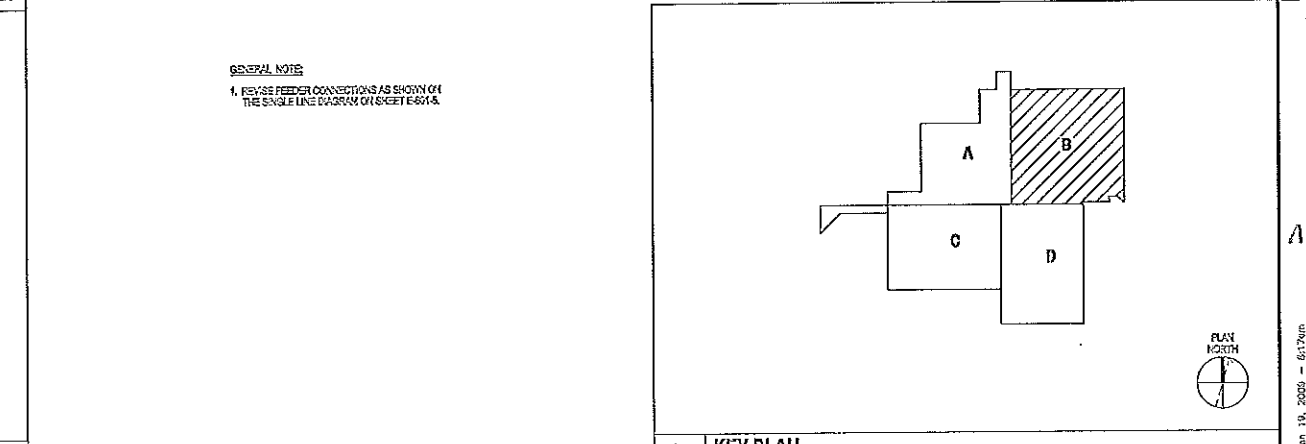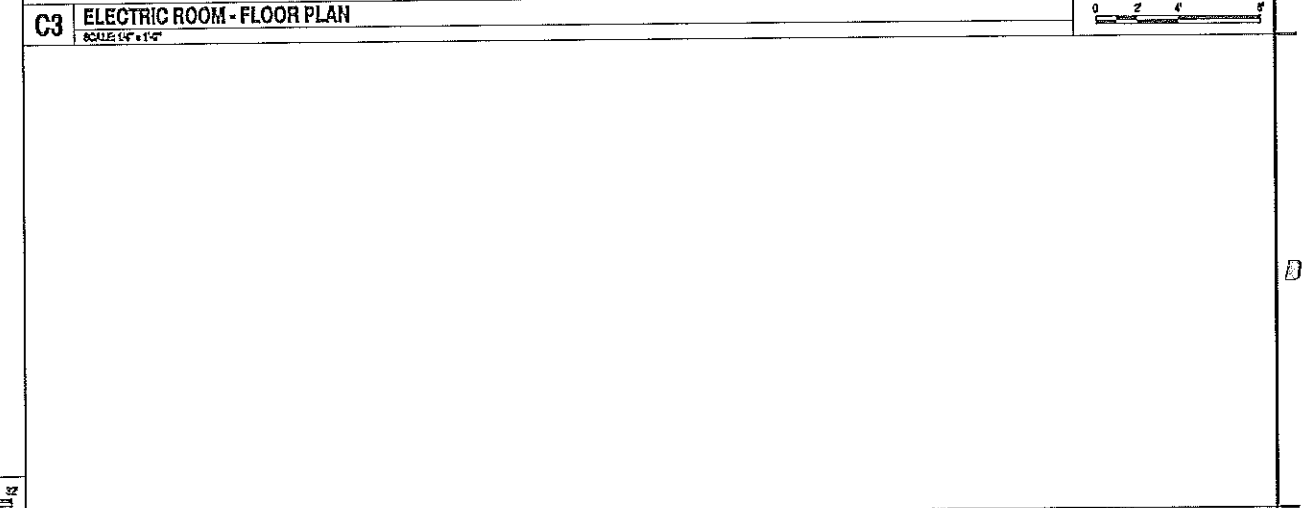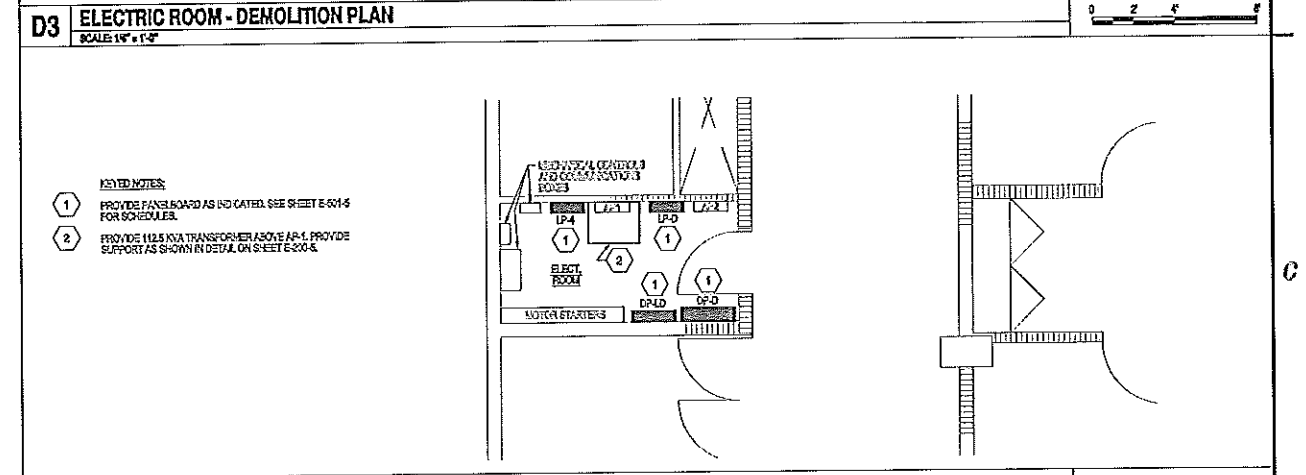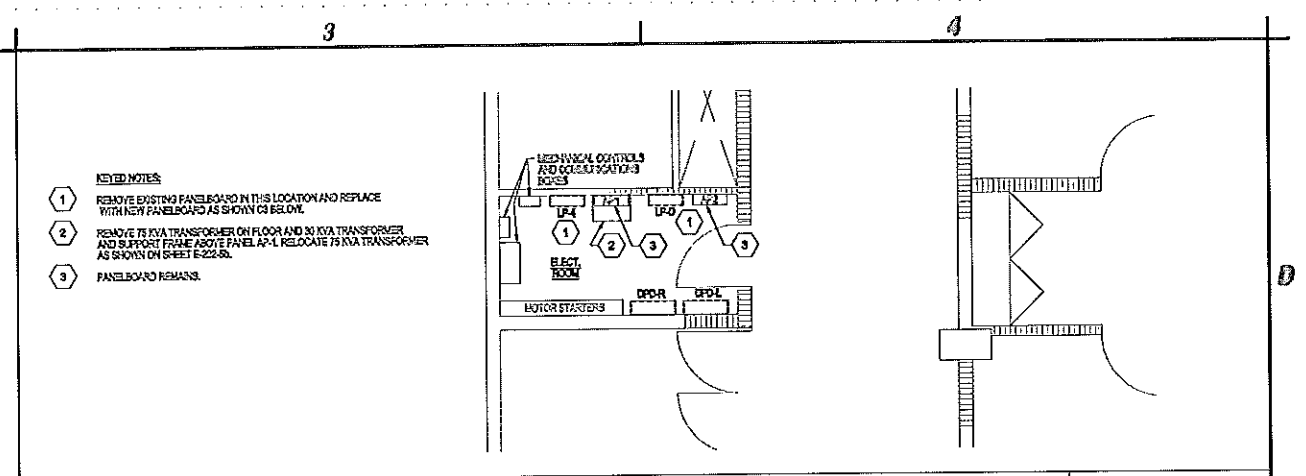

GENERAL NOTE:  
1. REVISE FINDER CONNECTIONS AS SHOWN ON THE SINGLE LINE DRAWING ON SHEET E-801-S.

REVISED BY: R.N.UJJ  
DATE: 12/5/03  
DRAWN BY: R.N.UJJ  
CHECKED BY: J.L.ROSEN, P.E.  
PROJECT NO: 190453.001  
DATE: DECEMBER 5, 2003  
SCALE: AS SHOWN  
DRAWN BY: R.N.UJJ  
DESIGNED BY: M.R.HAVES, P.E.  
CHECKED BY: J.L.ROSEN, P.E.  
NO ALTERATION PERMITTED HEREON  
EXCEPT AS PROVIDED UNDER SECTION  
2209 SUBDIVISION 2 OF THE NEW YORK  
EDUCATION LAW

**C&S COMPANIES**  
 C&S Engineers, Inc.  
 499 Col. Eileen Collins Blvd.  
 Syracuse, New York 13212  
 Phone: 315-455-2000  
 Fax: 315-455-6667  
 www.cscos.com



STATE UNIVERSITY CONSTRUCTION FUND  
 NEW YORK

STATE UNIVERSITY CONSTRUCTION FUND  
 SUCH PROJECT NO. 12290  
 STATE UNIVERSITY OF NEW YORK AT POTSDAM  
 PRE-BID SUBMISSION - NOT FOR CONSTRUCTION  
 UPGRADE ELECTRICAL DISTRIBUTION SYSTEMS  
 VARIOUS BUILDINGS


MARK	DATE	DESCRIPTION
REVISIONS		
	PROJECT NO:	190453 001
	DATE:	DECEMBER 5, 2009
	SCALE:	AS SHOWN
	DRAWN BY:	P.R.UJ
	DESIGNED BY:	TOMLAKIEWICZ, M.R.HAYES, P.E.
	CHECKED BY:	J.L. ROSSAS, P.E.

NO ALTERATION PERMITTED HEREON EXCEPT AS PROVIDED UNDER SECTION 7209 SUBDIVISION 2 OF THE NEW YORK EDUCATION LAW


**ELECTRICAL**

**CRANE MUSIC COMPLEX BASEMENT PLANS**


**E-100-9a**

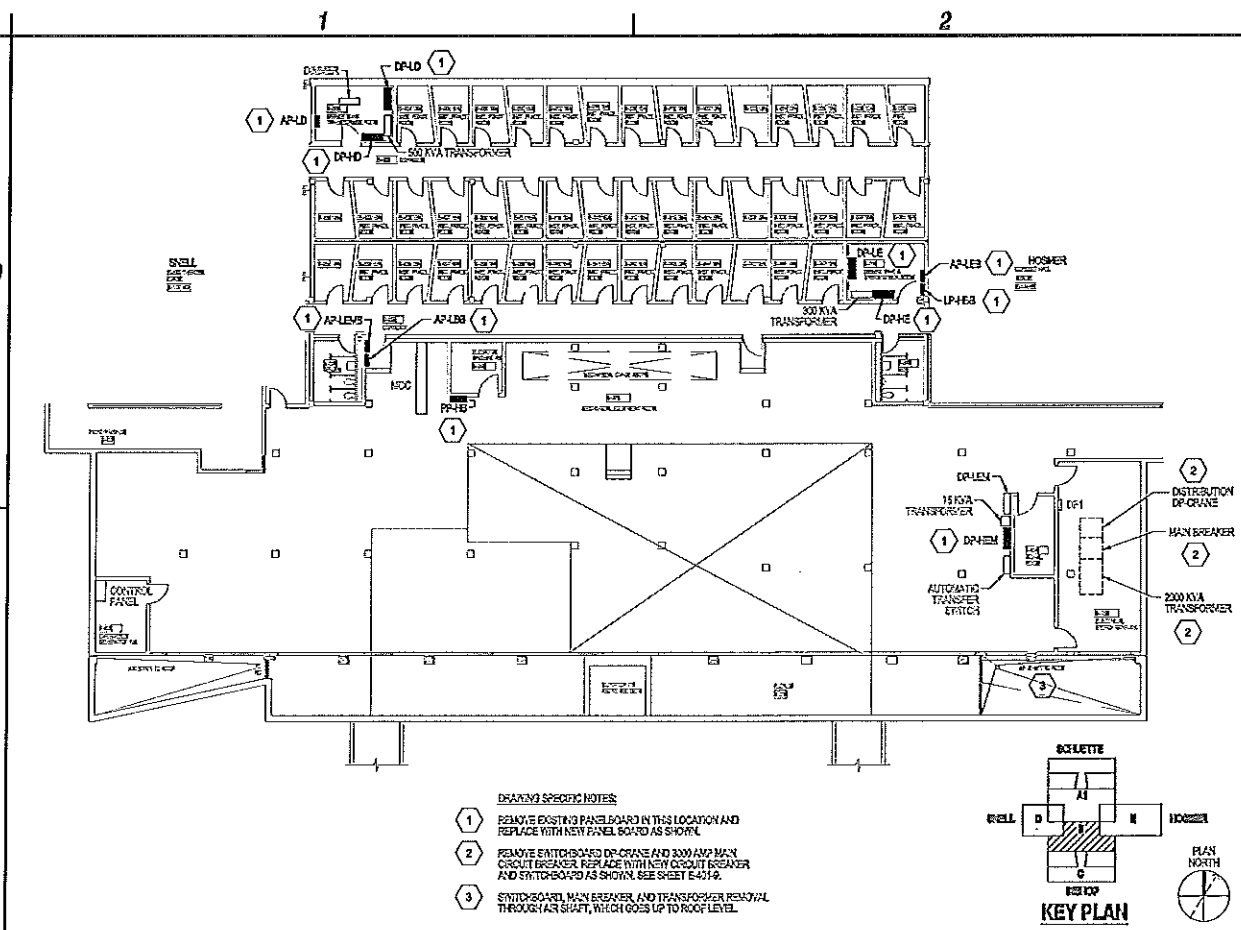

**C1 CRANE MUSIC COMPLEX - BUILDING "B" BASEMENT PLAN**  
 SCALE: 1/16" = 1'-0"

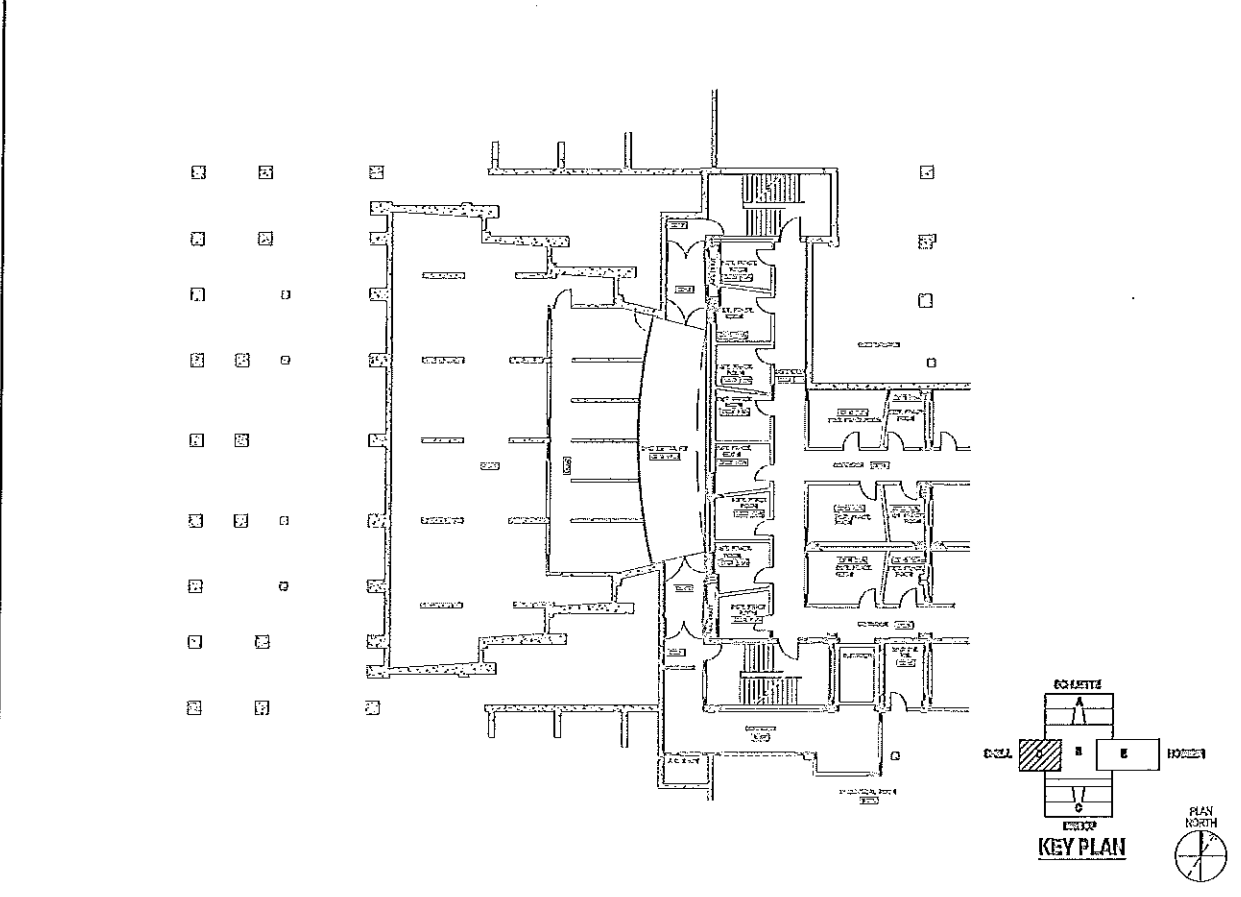

**A1 CRANE MUSIC COMPLEX - SNELL BASEMENT PLAN**  
 SCALE: 1/16" = 1'-0"

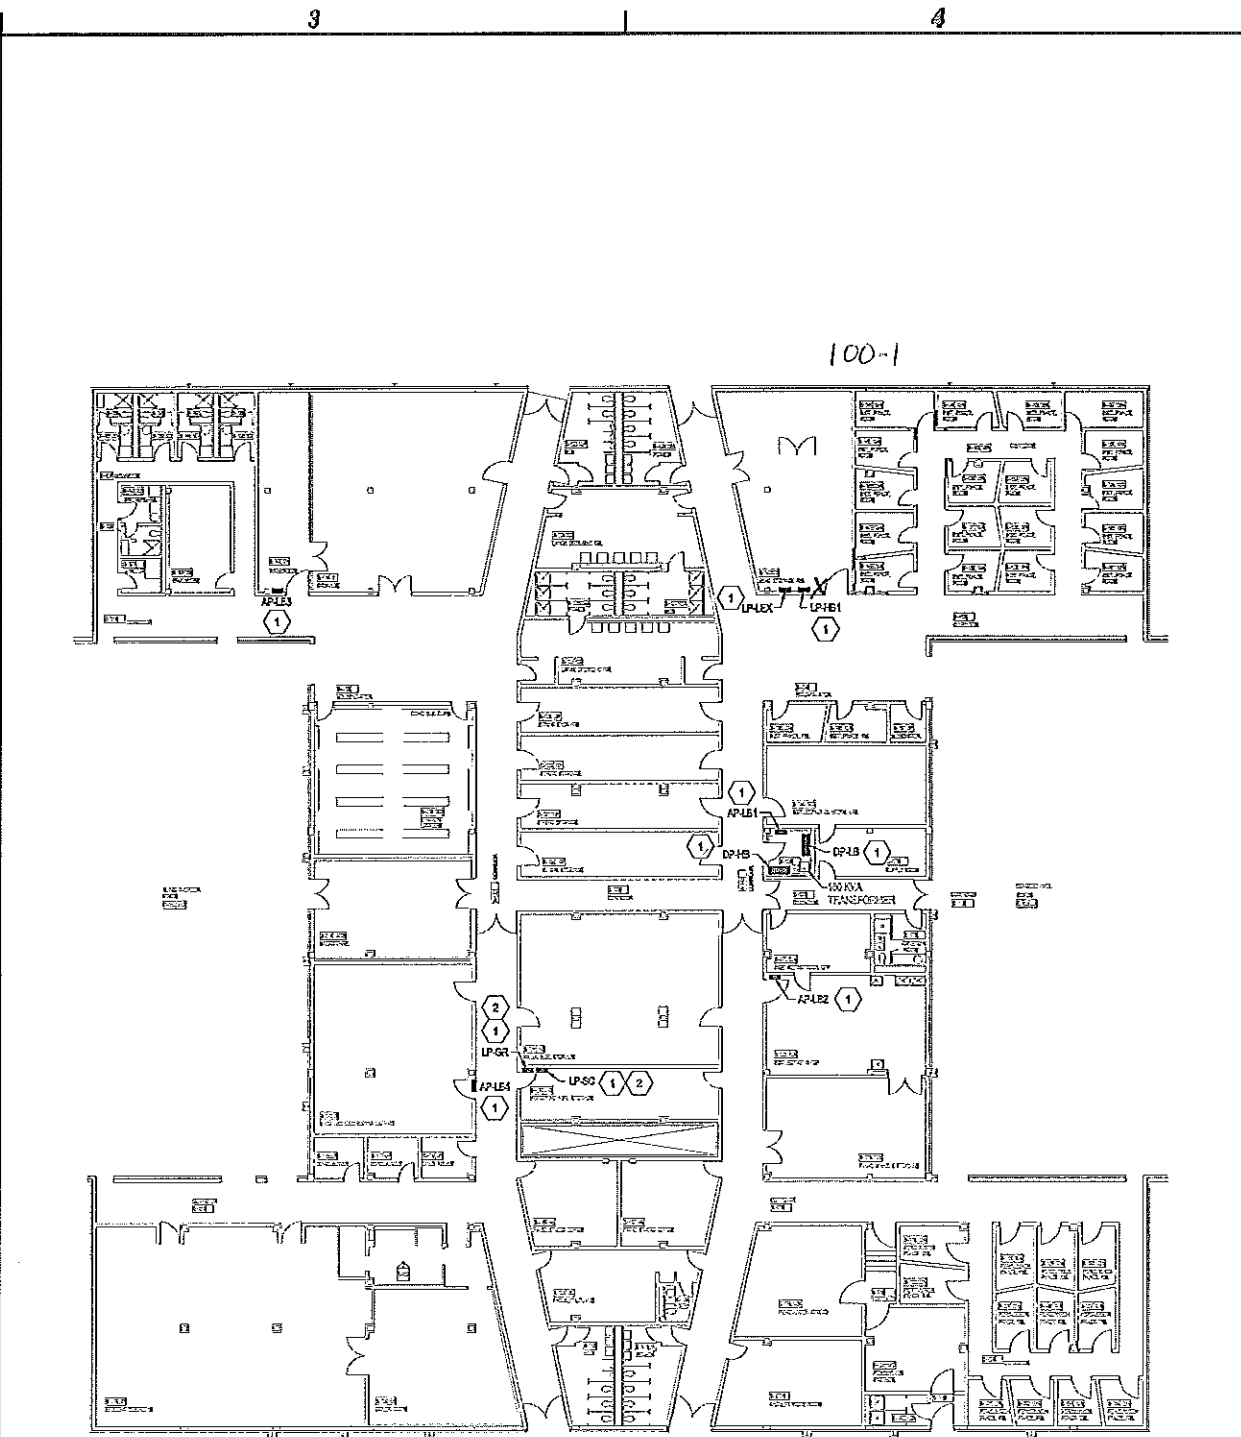


**A3 CRANE MUSIC COMPLEX - BUILDING "B" LOWER LEVEL PLAN**  
 SCALE: 1/16" = 1'-0"



**C&S Engineers, Inc.**  
 499 Col. Eileen Collins Blvd.  
 Syracuse, New York 13212  
 Phone: 315-455-2000  
 Fax: 315-455-9597  
 www.cscs.com

INSUL-C&S  
 FC 720-KEFE

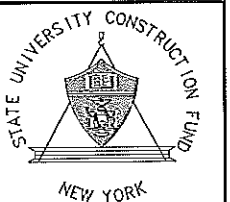


STATE UNIVERSITY CONSTRUCTION FUND  
 SUCF PROJECT NO. 12290  
 STATE UNIVERSITY OF NEW YORK AT POTSDAM  
**PRE-BID SUBMISSION - NOT FOR CONSTRUCTION**  
**UPGRADE ELECTRICAL DISTRIBUTION SYSTEMS**  
 VARIOUS BUILDINGS

MARK	DATE	DESCRIPTION
REVISIONS		
PROJECT NO: 193433.001		
DATE: DECEMBER 5, 2008		
SCALE: AS SHOWN		
DRAWN BY: P.H. LUU		
DESIGNED BY: T.C. KIKKOROS, MAHYESPE		
CHECKED BY: J.L. ROBERTS, P.E.		
NO ALTERATION PERMITTED HEREON EXCEPT AS PROVIDED UNDER SECTION 7209 SUBDIVISION 2 OF THE NEW YORK EDUCATION LAW		


**ELECTRICAL**  
**CRANE MUSIC COMPLEX**  
**FIRST FLOOR PLANS**

**E-100-9b**


JUN 16, 2009 - 4:03 PM  
 P:\Projects\100-9b\100-9b.dwg

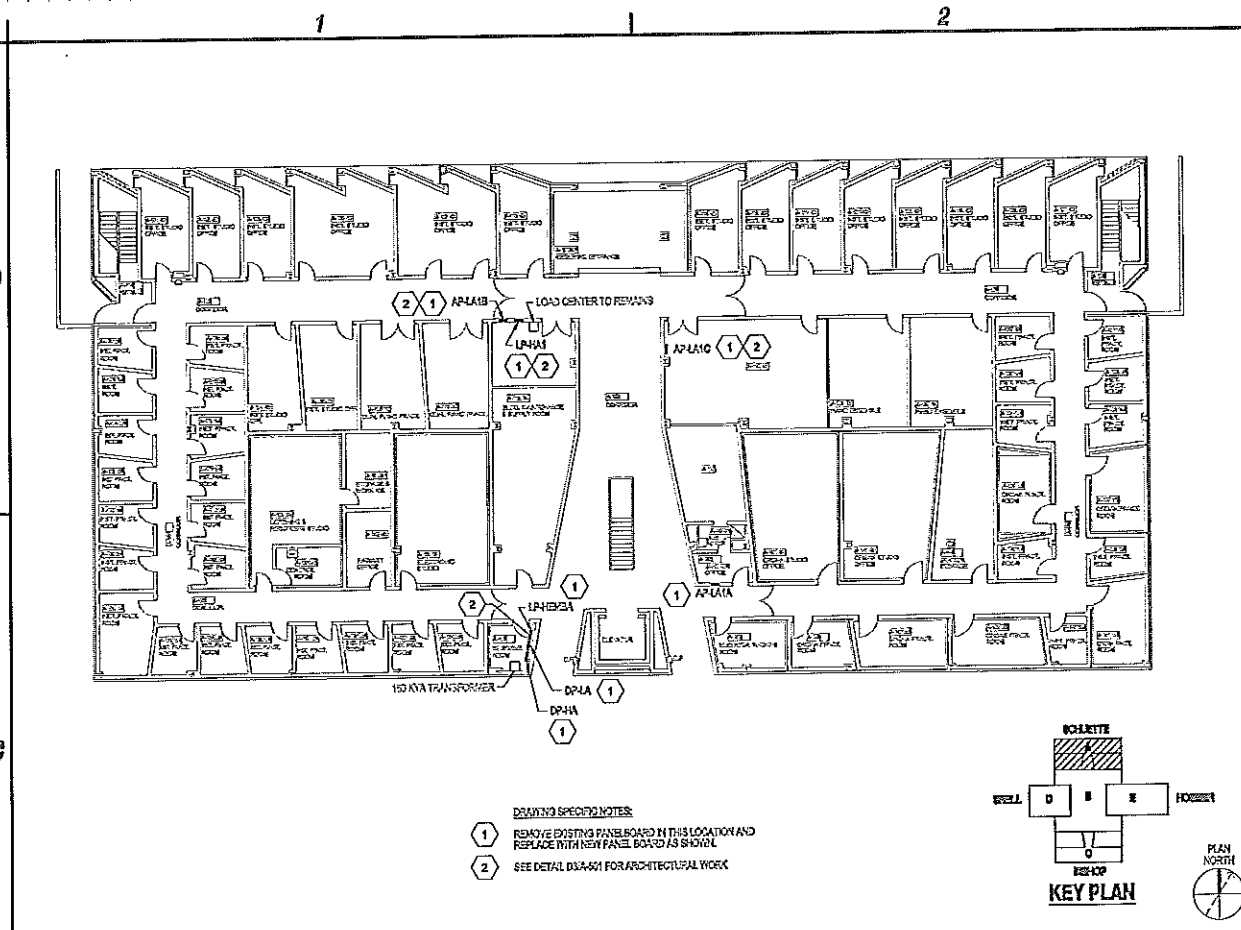


**C1 CRANE MUSIC COMPLEX - SCHUETTE LOWER LEVEL PLAN**  
 SCALE: 1/4" = 1'-0"

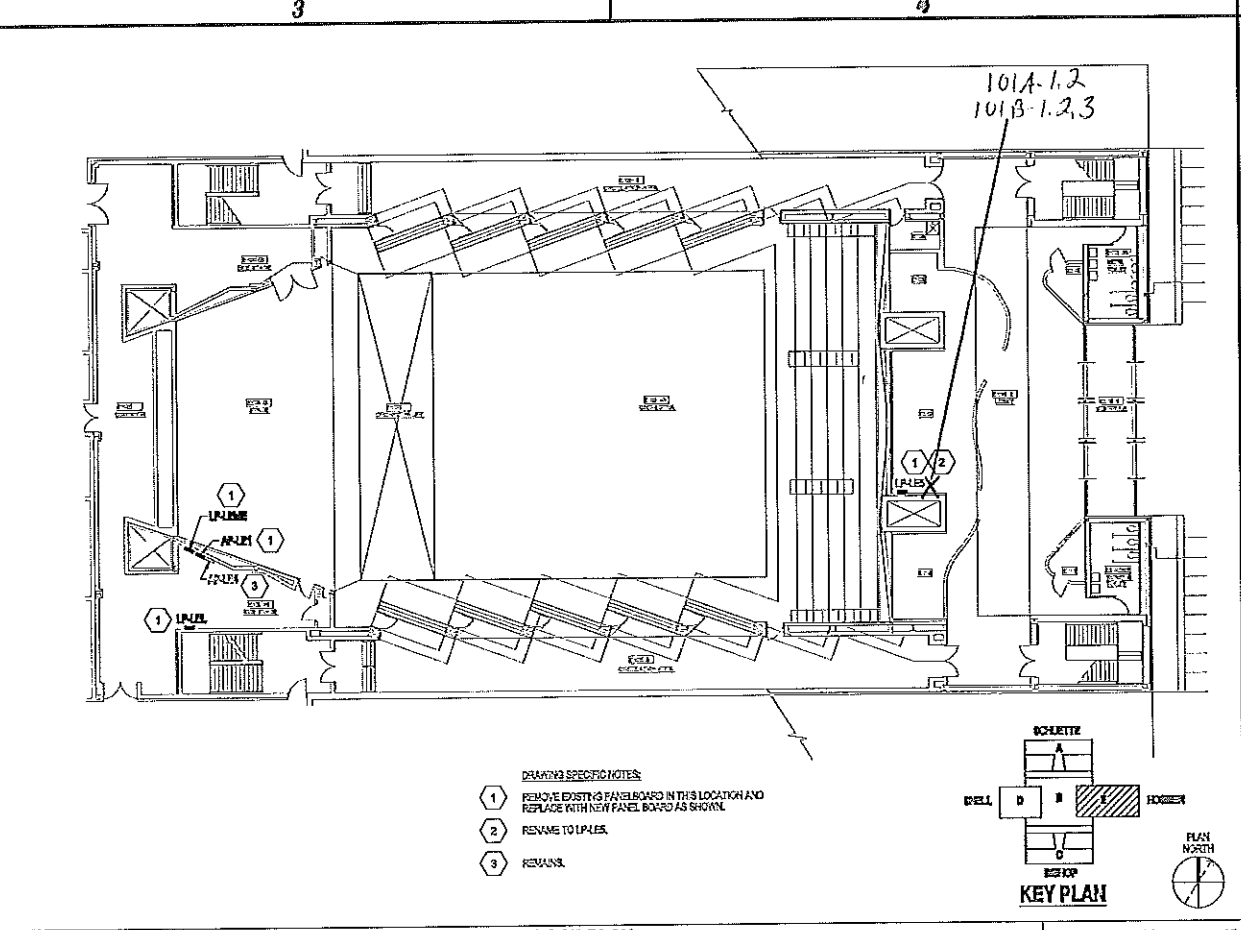


**C3 CRANE MUSIC COMPLEX - HOSMER ORCHESTRA LEVEL FLOOR PLAN**  
 SCALE: 1/4" = 1'-0"

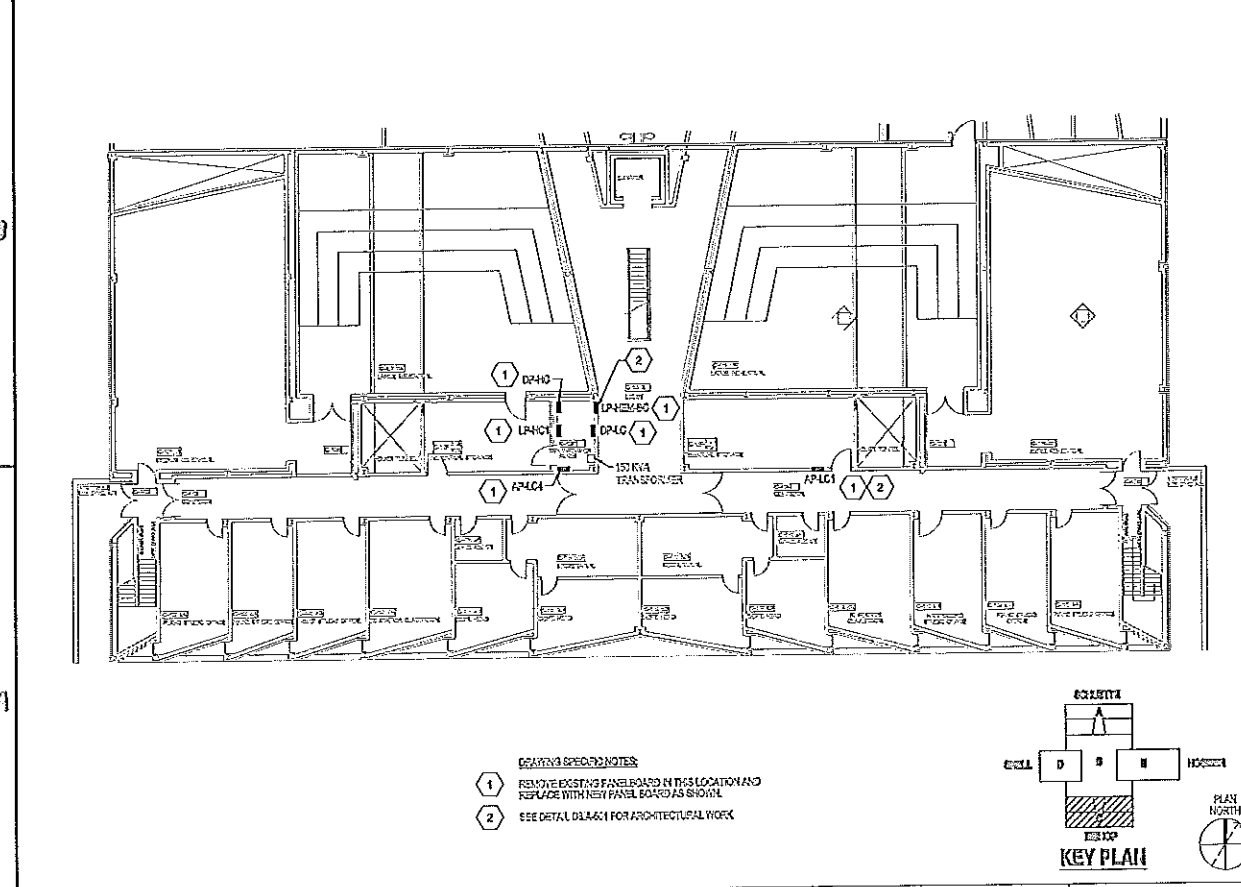


**A1 CRANE MUSIC COMPLEX - BISHOP LOWER LEVEL FLOOR PLAN**  
 SCALE: 1/4" = 1'-0"

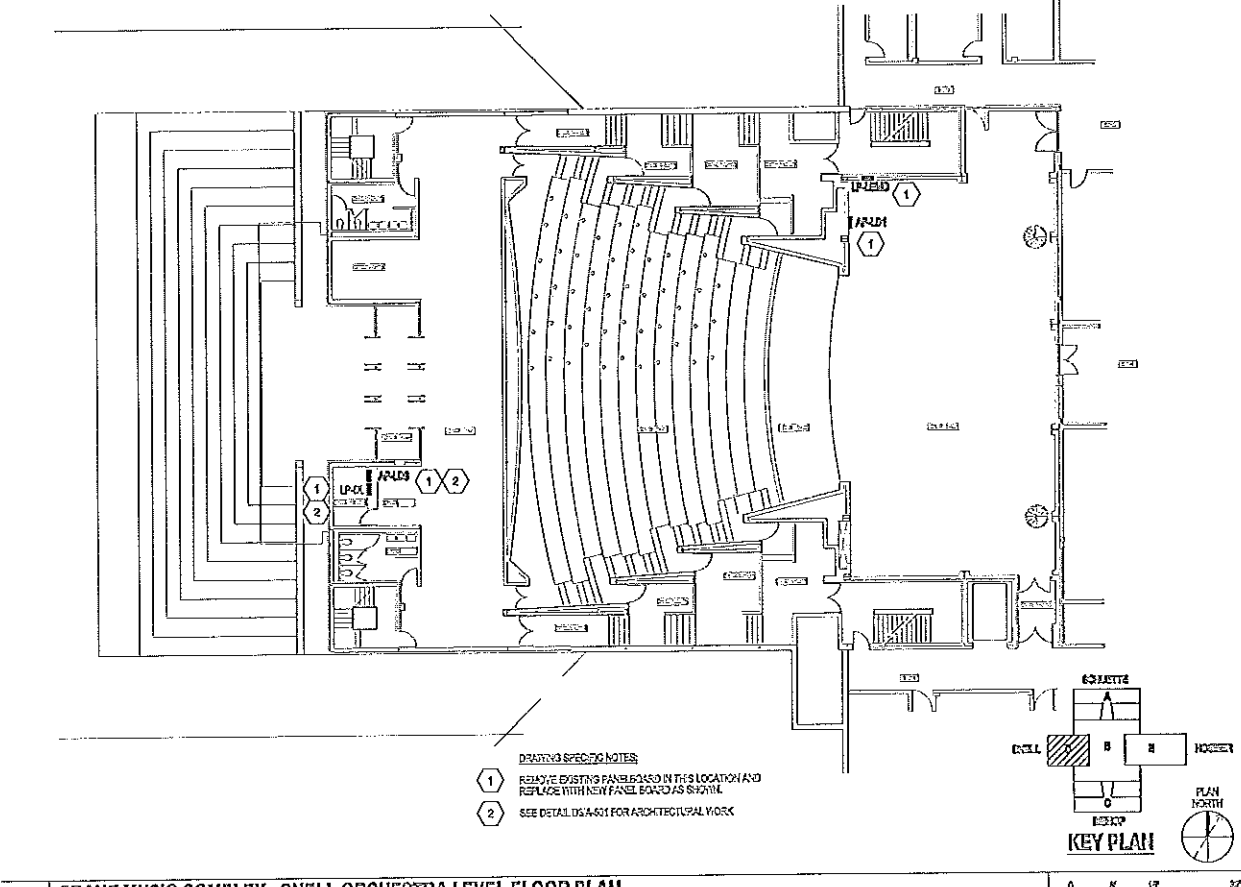


**A3 CRANE MUSIC COMPLEX - SNELL ORCHESTRA LEVEL FLOOR PLAN**  
 SCALE: 1/4" = 1'-0"

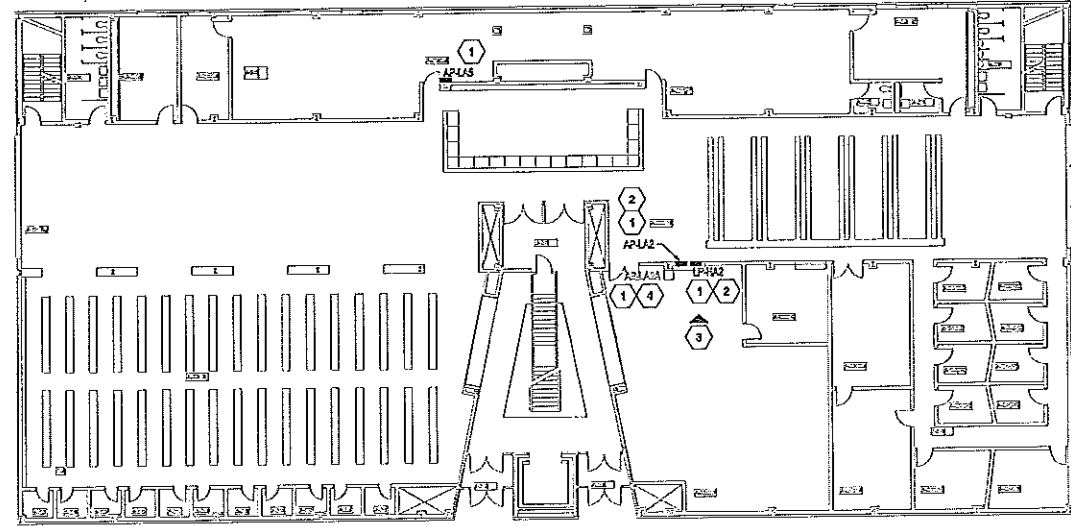


- DRAWING SPECIFIC NOTES:
- ① REMOVE EXISTING PANEL BOARD IN THIS LOCATION AND REPLACE WITH NEW PANEL BOARD AS SHOWN.
  - ② SEE DETAIL D03-651 FOR ARCHITECTURAL WORK.
  - ③ SEE PHOTO A1-34-S1.
  - ④ REMOVE TO AP-LAS, EXISTING PANEL REMAINS.

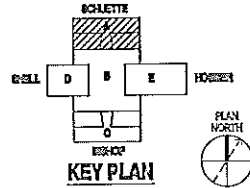


C1 CRANE MUSIC COMPLEX - SCHUETTE PLAZA LEVEL FLOOR PLAN  
SCALE: 1/8" = 1'-0"

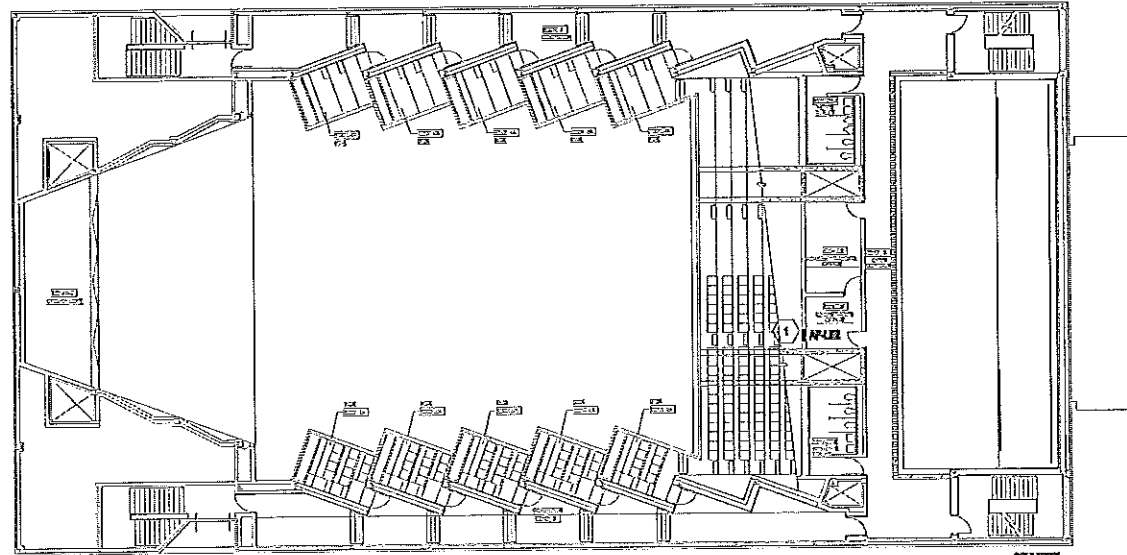


- DRAWING SPECIFIC NOTES:
- ① REMOVE EXISTING PANEL BOARD IN THIS LOCATION AND REPLACE WITH NEW PANEL BOARD AS SHOWN.

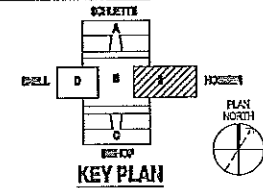


C3 CRANE MUSIC COMPLEX - HOSMER SECOND FLOOR PLAN  
SCALE: 1/8" = 1'-0"

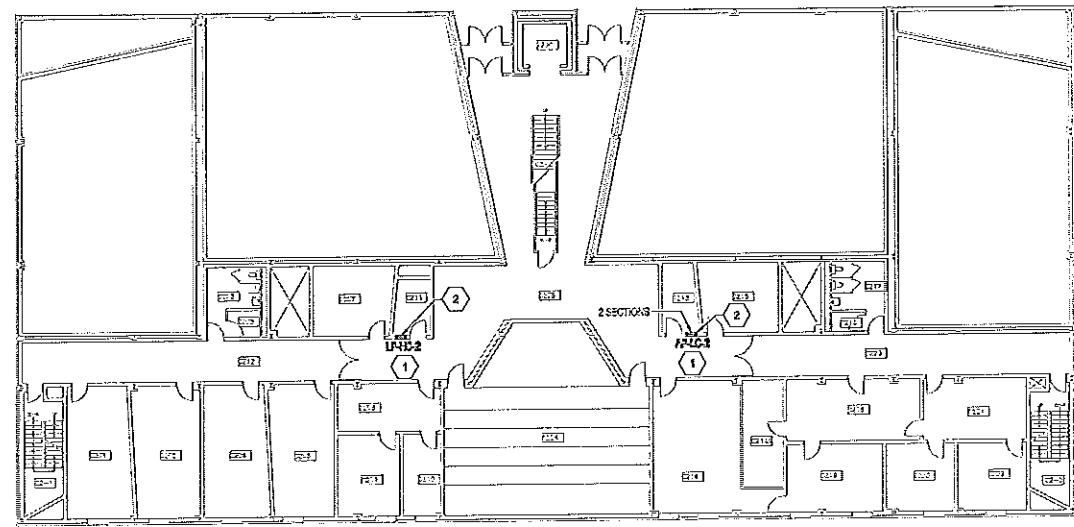


- DRAWING SPECIFIC NOTES:
- ① REMOVE EXISTING PANEL BOARD IN THIS LOCATION AND REPLACE WITH NEW PANEL BOARD AS SHOWN.
  - ② SEE DETAIL D03-651 FOR ARCHITECTURAL WORK.

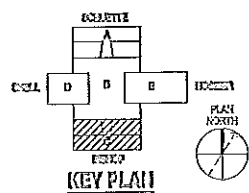

A1 CRANE MUSIC COMPLEX - BISHOP PLAZA LEVEL FLOOR PLAN  
SCALE: 1/8" = 1'-0"

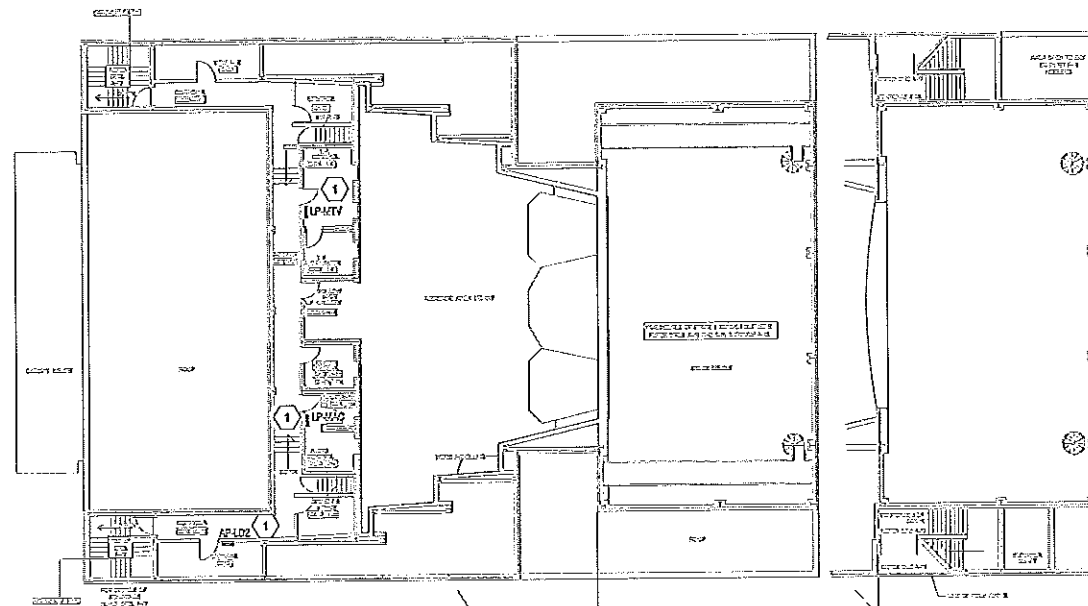


- DRAWING SPECIFIC NOTES:
- ① REMOVE EXISTING PANEL BOARD IN THIS LOCATION AND REPLACE WITH NEW PANEL BOARD AS SHOWN.

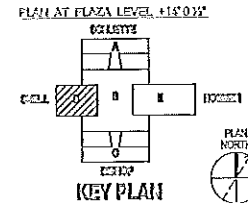

A3 CRANE MUSIC COMPLEX - SNELL UPPER LEVEL FLOOR PLAN  
SCALE: 1/8" = 1'-0"



C&S Engineers, Inc.  
499 Col. Eileen Collins Blvd.  
Syracuse, New York 13212  
Phone: 315-455-2000  
Fax: 315-455-9887  
www.ccsos.com

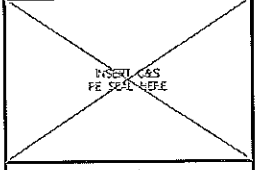

STATE UNIVERSITY CONSTRUCTION FUND  
SUCF PROJECT NO. 12290  
STATE UNIVERSITY OF NEW YORK AT POTSDAM  
**PRE-BID SUBMISSION - NOT FOR CONSTRUCTION**  
**UPGRADE ELECTRICAL DISTRIBUTION SYSTEMS**  
VARIOUS BUILDINGS

MARK	DATE	DESCRIPTION

REVISIONS


PROJECT NO: 190.458.001  
DATE: DECEMBER 5, 2003  
SCALE: AS SHOWN  
DRAWN BY: P.N.L.WJ  
DESIGNED BY: TCHAIKORAKOZ/ALPHABETS, P.E.  
CHECKED BY: J.L. ROBERTS, P.E.  
NO ALTERATION PERMITTED HEREON EXCEPT AS PROVIDED UNDER SECTION 2209 SUBDIVISION 2 OF THE NEW YORK EDUCATION LAW

ELECTRICAL  
**CRANE MUSIC COMPLEX SECOND FLOOR PLANS**


E-100-9c

APR 15, 2003 - 7:58PM  
 C:\COURT\ASSETS\BIBY\PROJ100\100-9C\PROJECT\100-9C\UPGRADE.ELECTRICAL DISTRIBUTION SYSTEMS\A1.dwg  
 PROJECT: CRANE MUSIC COMPLEX CONSTRUCTION





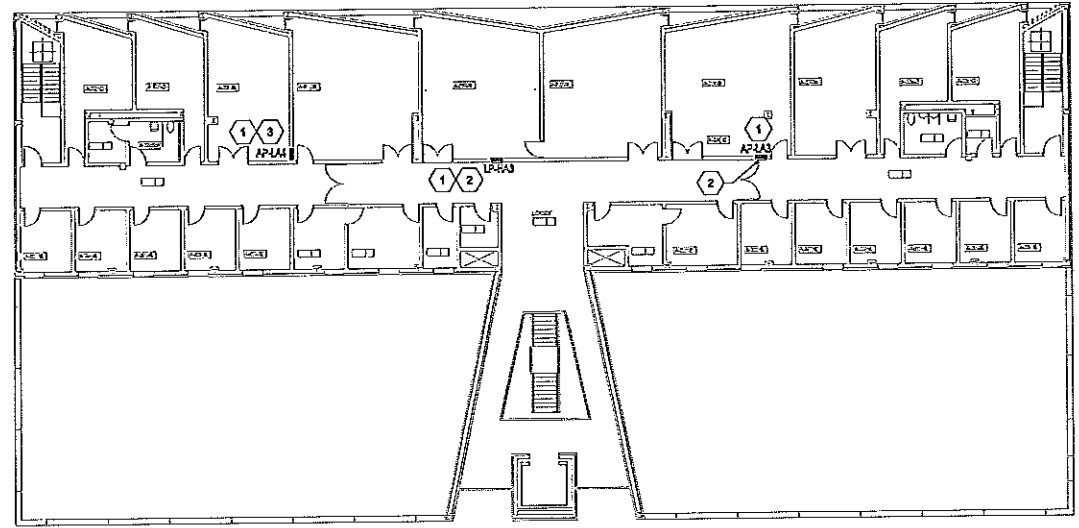


- DRAWING SPECIFIC NOTES:**
- ① REMOVE EXISTING PANELBOARD IN THIS LOCATION AND REPLACE WITH NEW PANEL BOARD AS SHOWN.
  - ② SEE DETAIL D24-511 FOR ARCHITECTURAL WORK.
  - ③ SEE DETAIL A24-511 FOR ARCHITECTURAL DRY WALL WORK.

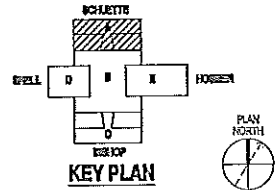


**C1 CRANE MUSIC COMPLEX - SCHUETTE UPPER LEVEL FLOOR PLAN**  
SCALE: 1/16" = 1'-0"

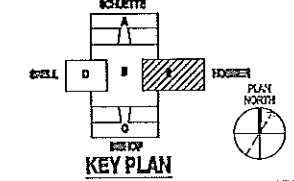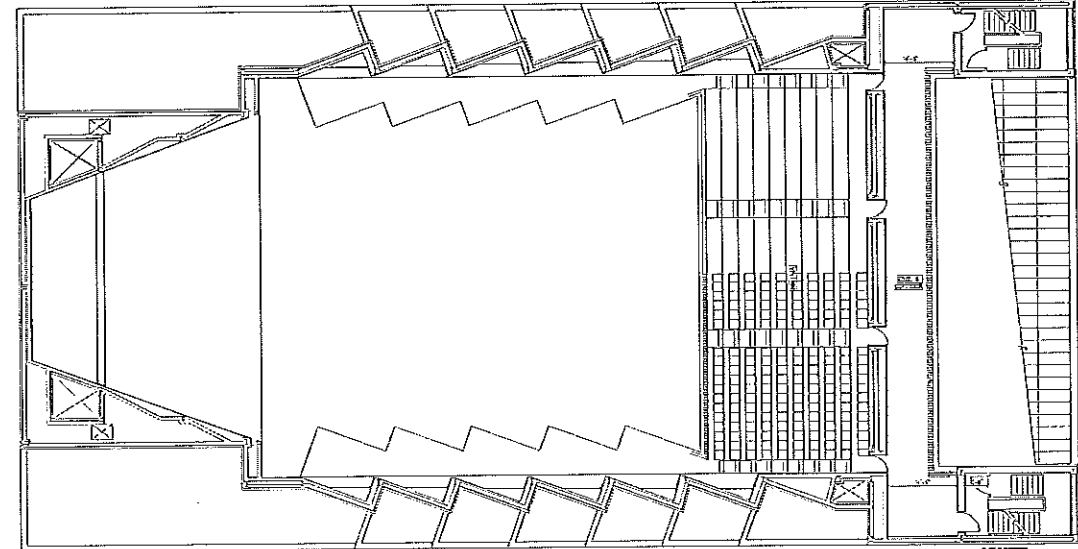


**C3 CRANE MUSIC COMPLEX - HOSMER BALCONY LEVEL FLOOR PLAN**  
SCALE: 1/16" = 1'-0"

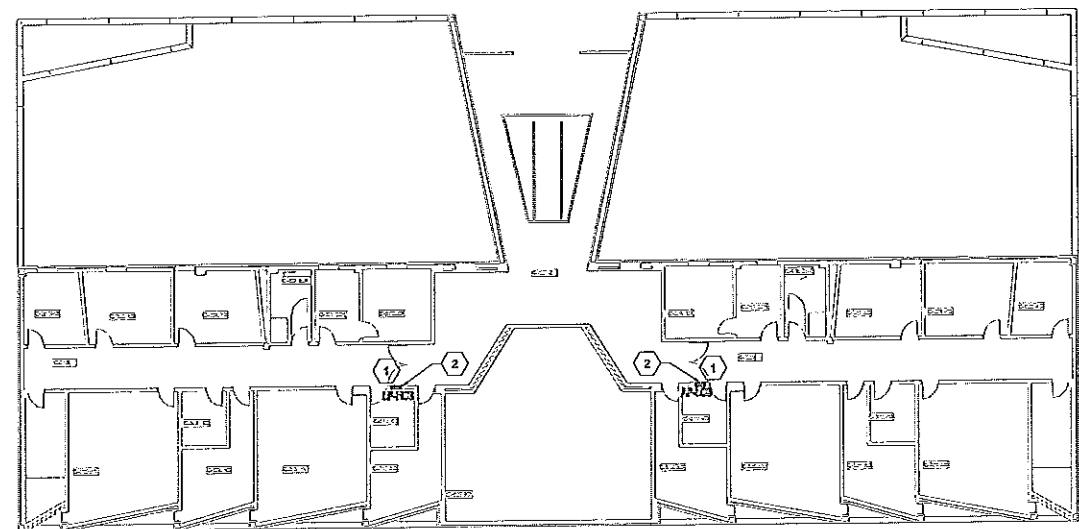


- DRAWING SPECIFIC NOTES:**
- ① REMOVE EXISTING PANELBOARD IN THIS LOCATION AND REPLACE WITH NEW PANEL BOARD AS SHOWN.
  - ② SEE DETAIL D24-511 FOR ARCHITECTURAL WORK.

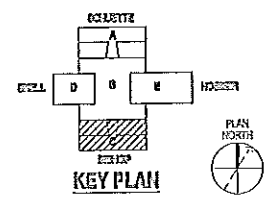

**A1 CRANE MUSIC COMPLEX - BISHOP UPPER LEVEL FLOOR PLAN**  
SCALE: 1/16" = 1'-0"

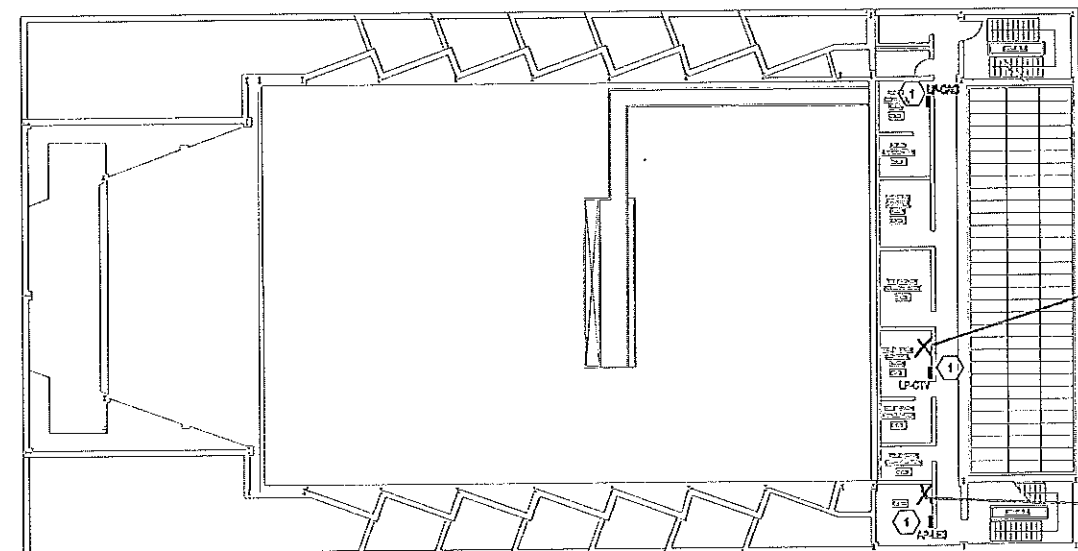


- DRAWING SPECIFIC NOTES:**
- ① REMOVE EXISTING PANELBOARD IN THIS LOCATION AND REPLACE WITH NEW PANEL BOARD AS SHOWN.

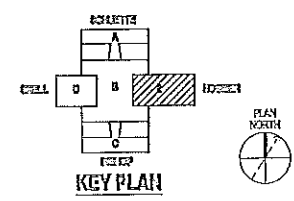

**A1 CRANE MUSIC COMPLEX - HOSMER CONTROL LEVEL FLOOR PLAN**  
SCALE: 1/16" = 1'-0"



**C&S Engineers, Inc.**  
499 Col. Eileen Collins Blvd.  
Syracuse, New York 13212  
Phone: 315-455-2000  
Fax: 315-455-9687  
www.cscs.com

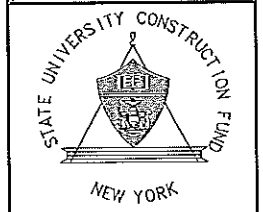

**STATE UNIVERSITY CONSTRUCTION FUND**  
SUCF PROJECT NO. 12290  
STATE UNIVERSITY OF NEW YORK AT POTSDAM  
**PRE-BID SUBMISSION - NOT FOR CONSTRUCTION**  
**UPGRADE ELECTRICAL DISTRIBUTION SYSTEMS**  
VARIOUS BUILDINGS

MARK	DATE	DESCRIPTION
		REVISIONS
		PROJECT NO: 193,433.001
		DATE: DECEMBER 5, 2003
		SCALE: AS SHOWN
		DRAWN BY: P.H. LIU
		DESIGNED BY: T.C. LIU, K.E.Y.O.Z., M.R.HAYES, P.E.
		CHECKED BY: J.L. ROSS, P.E.
		NO ALTERATION PERMITTED HEREON EXCEPT AS PROVIDED UNDER SECTION 7209 SUBDIVISION 2 OF THE NEW YORK EDUCATION LAW


**ELECTRICAL**

**CRANE MUSIC COMPLEX**  
**THIRD & FOURTH FLOOR PLANS**

**E-100-9d**



**C&S Engineers, Inc.**  
 499 Col. Eileen Collins Blvd.  
 Syracuse, New York 13212  
 Phone: 315-455-2000  
 Fax: 315-455-8687  
 www.cscos.com

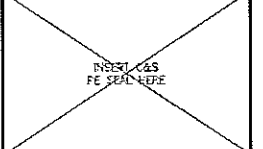

STATE UNIVERSITY CONSTRUCTION FUND  
 SUCF PROJECT NO. 12290  
 STATE UNIVERSITY OF NEW YORK AT POTSDAM  
 PRE-BID SUBMISSION - NOT FOR CONSTRUCTION  
 UPGRADE ELECTRICAL DISTRIBUTION SYSTEMS  
 VARIOUS BUILDINGS

MARK	DATE	DESCRIPTION
REVISIONS		
		PROJECT NO: 160453001
		DATE: DECEMBER 6, 2009
		SCALE: AS SHOWN
		DRAWN BY: P.H.WU
		DESIGNED BY: T.C.KULIKOWSKI
		CHECKED BY: J.L.ROBBINS, P.E.


NO ALTERATION PERMITTED HEREON EXCEPT AS PROVIDED UNDER SECTION 7203 SUBSECTION 2 OF THE NEW YORK EDUCATION LAW

**ELECTRICAL**


**SATTERLEE BASEMENT PLAN**

**E-100-10a**

10/19/2009 10:44:00 AM P:\Projects\100453001\_SUCF\_POTSDAM\_ELEC\_SATTERLEE\_PARTIAL\_BASEMENT\_PLAN.dwg P:\Projects\100453001\_SUCF\_POTSDAM\_ELEC\_SATTERLEE\_PARTIAL\_BASEMENT\_PLAN.dwg P=100-10a.dwg



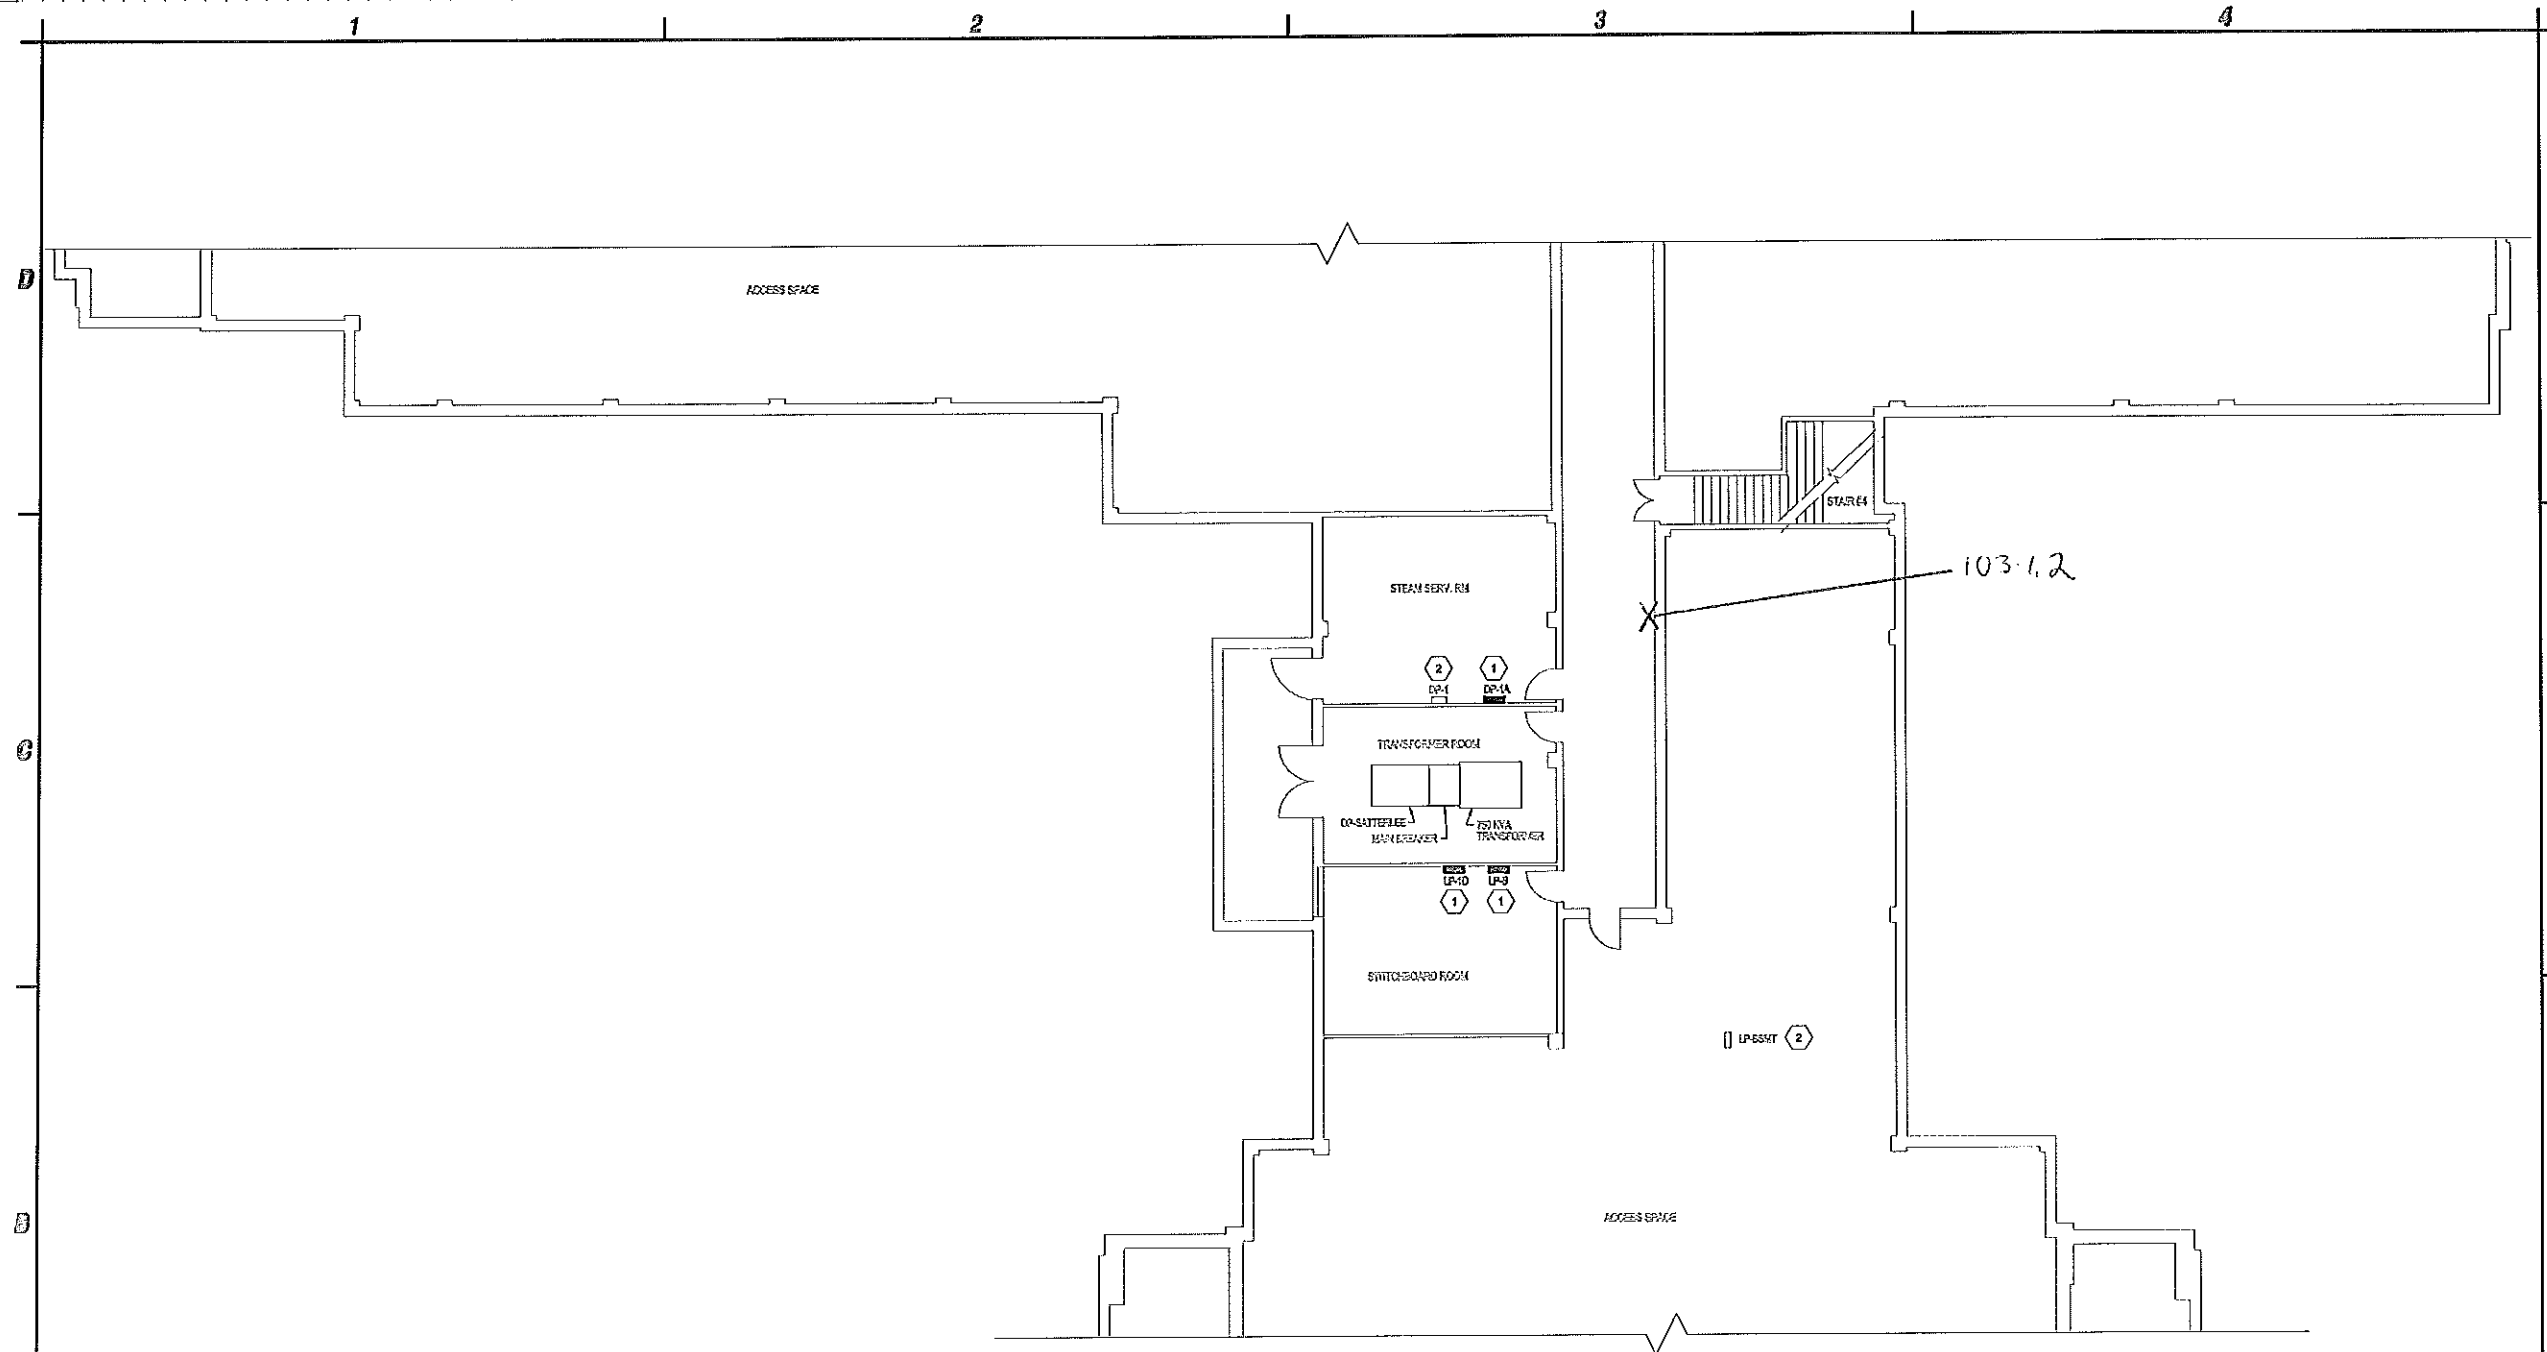


- DRAWING SPECIFIC NOTES**
- 1 REMOVE EXISTING PANELBOARDS IN THIS LOCATION AND REPLACE WITH NEW PANEL BOARDS AS SHOWN.
  - 2 REMAINS.

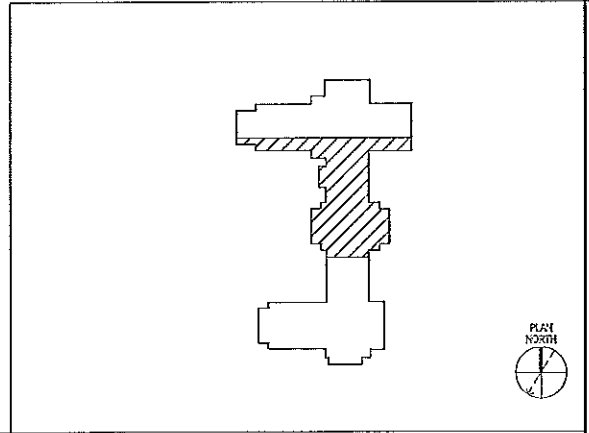

**A1 SATTERLEE - PARTIAL BASEMENT PLAN**  
 SCALE: 1/4" = 1'-0"

**A4 KEY PLAN**  
 SCALE: NOT TO SCALE

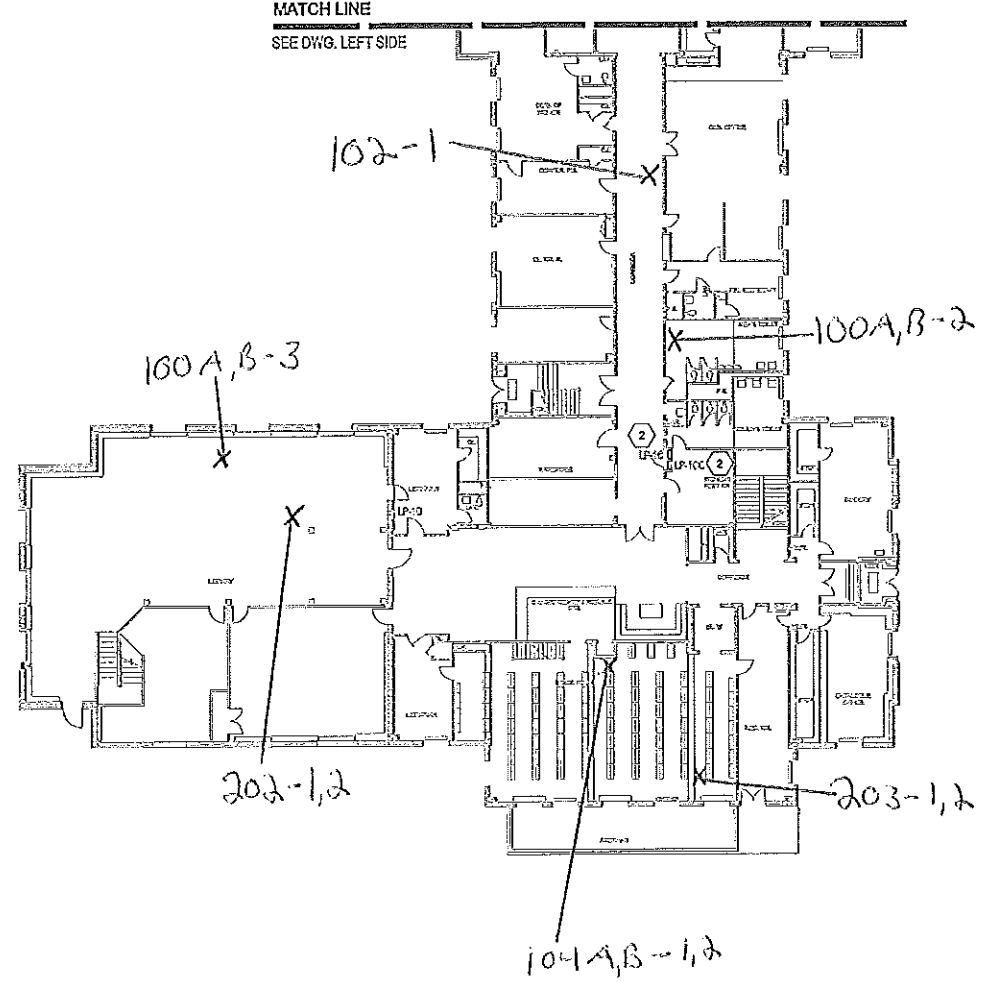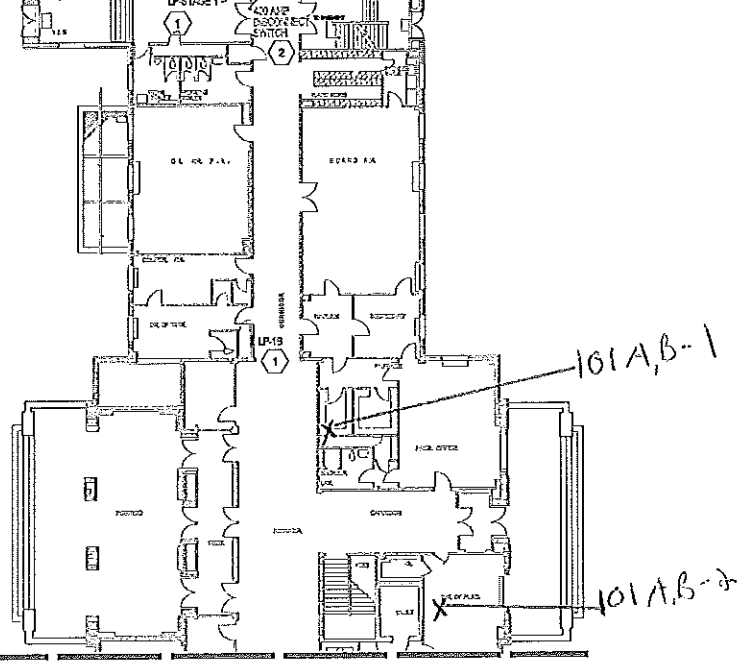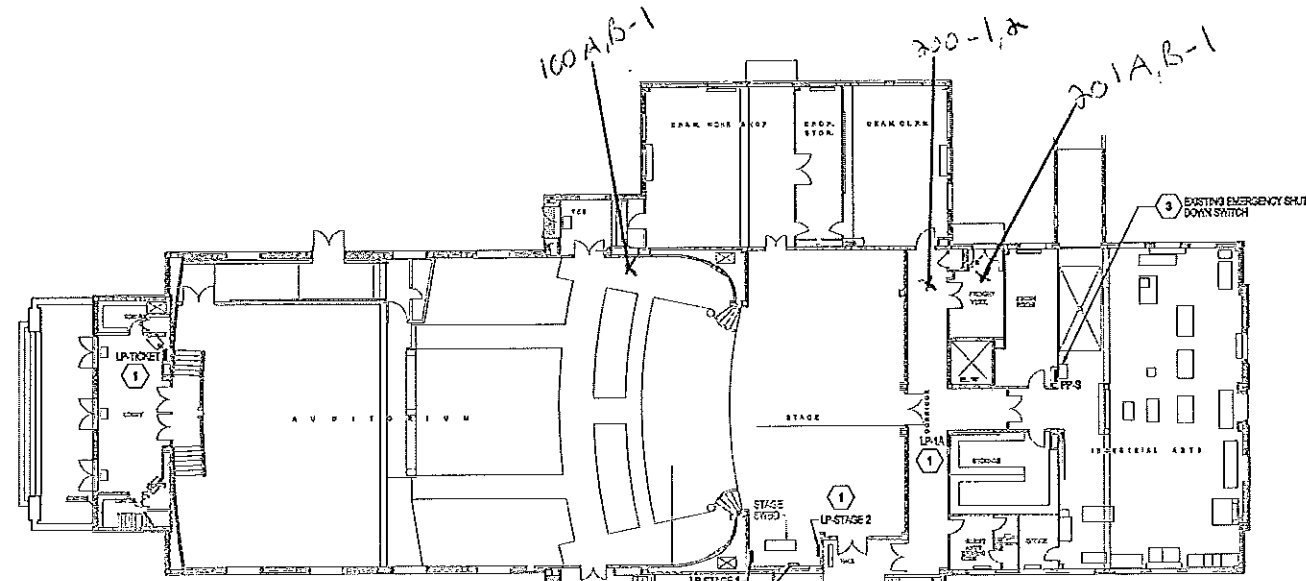

MATCH LINE  
SEE DWG. RIGHT SIDE


MATCH LINE  
SEE DWG. LEFT SIDE

- DRAWING SPECIFIC NOTES**
- 1 REMOVE EXISTING PANELBOARD IN THIS LOCATION AND REPLACE WITH NEW PANELBOARD AS SHOWN.
  - 2 REPAIRS.
  - 3 RECONNECT EXISTING EMERGENCY SHUT DOWN SWITCH TO SHUNT TRIP MAIN BREAKER IN PAB.

A1 SATTERLEE - FIRST FLOOR PLAN  
SCALE: 1/8" = 1'-0"



**C&S Engineers, Inc.**  
499 Col. Eileen Collins Blvd.  
Syracuse, New York 13212  
Phone: 315-455-2000  
Fax: 315-455-9637  
www.cscos.com

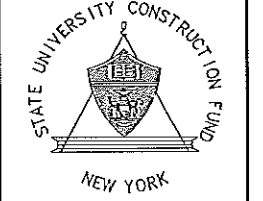

STATE UNIVERSITY CONSTRUCTION FUND  
 SUCF PROJECT NO. 12290  
 STATE UNIVERSITY OF NEW YORK AT POTSDAM  
 PRE-BID SUBMISSION - NOT FOR CONSTRUCTION  
 UPGRADE ELECTRICAL DISTRIBUTION SYSTEMS  
 VARIOUS BUILDINGS


MARK	DATE	DESCRIPTION
REVISIONS		
PROJECT NO:	192453001	
DATE:	DECEMBER 5, 2008	
SCALE:	AS SHOWN	
DRAWN BY:	P.N.D.U.	
DESIGNED BY:	T.D.KLINEWICZ	
CHECKED BY:	J.L. ROSSINI, P.E.	

NO ALTERATION PERMITTED HEREON EXCEPT AS PROVIDED UNDER SECTION 7209 SUBSECTION 2 OF THE NEW YORK EDUCATION LAW

**ELECTRICAL**

**SATTERLEE  
FIRST FLOOR  
PLANS**

E-100-10b

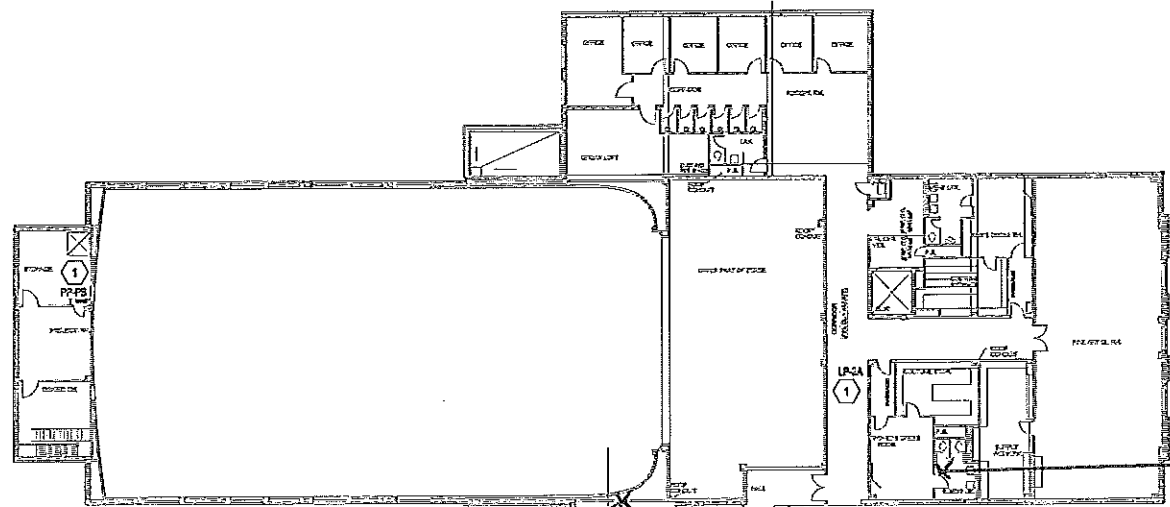


100A, B-3

100A, B-4

MATCH LINE  
SEE DWG. RIGHT SIDE

- BRAND'S SPECIFIC NOTES:
- ① REMOVE EXISTING PANELED IN THIS LOCATION AND REPLACE WITH NEW PANEL BOARD AS SHOWN (NOT USED).
  - ② REMAINS.

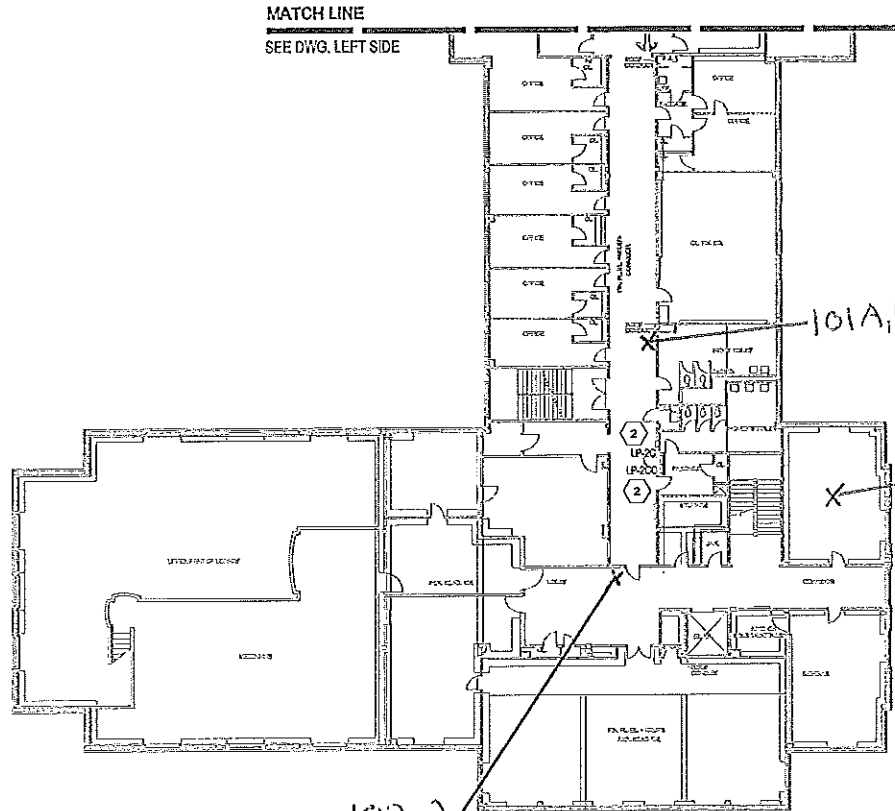

MATCH LINE  
SEE DWG. LEFT SIDE

101A, B-4

102-2  
101A, B-3



**C&S Engineers, Inc.**  
499 Col. Eileen Collins Blvd.  
Syracuse, New York 13212  
Phone: 315-455-2000  
Fax: 315-455-6667  
www.csc008.com





STATE UNIVERSITY CONSTRUCTION FUND  
SUCF PROJECT NO. 12290  
STATE UNIVERSITY OF NEW YORK AT POTSDAM  
PRE-BID SUBMISSION - NOT FOR CONSTRUCTION  
UPGRADE ELECTRICAL DISTRIBUTION SYSTEMS  
VARIOUS BUILDINGS

MARK	DATE	DESCRIPTION
REVISIONS		
PROJECT NO: 100433.001		
DATE: DECEMBER 5, 2003		
SCALE: AS SHOWN		
DRAWN BY: P.N.LUU		
DESIGNED BY: T.G. KILKIEWICZ		
CHECKED BY: J.L. ROSS, P.E.		
NO ALTERATION PERMITTED HEREON EXCEPT AS PROVIDED UNDER SECTION 203 SUBSECTION 2 OF THE NEW YORK EDUCATION LAW		

ELECTRICAL  
**SATTERLEE  
SECOND FLOOR  
PLANS**

**E-100-10c**

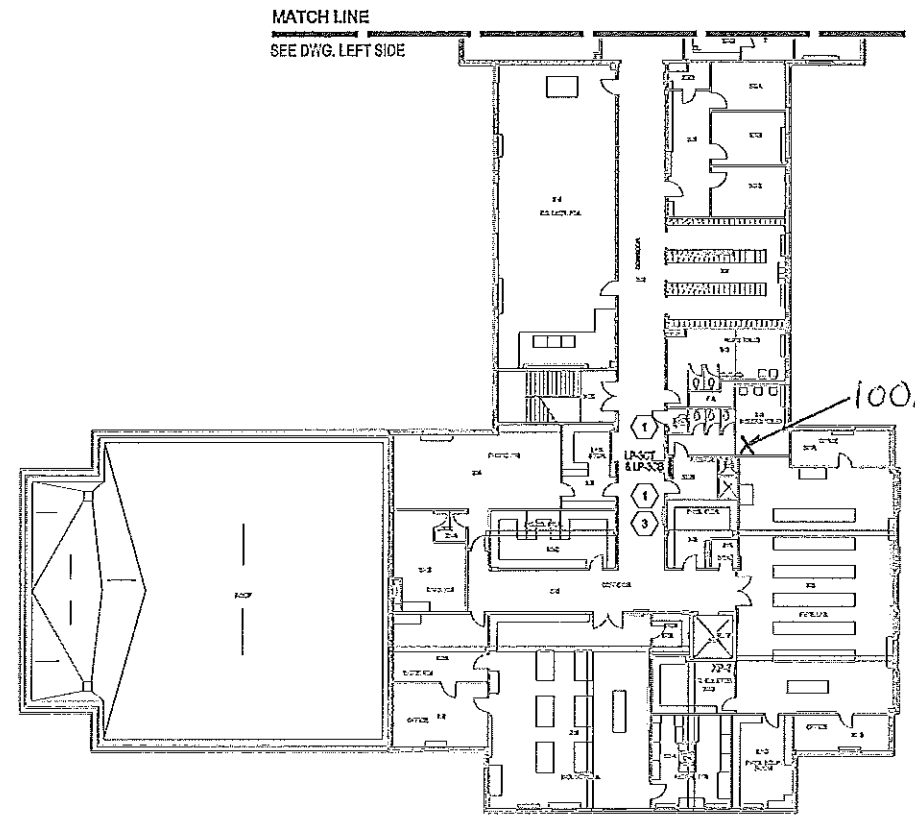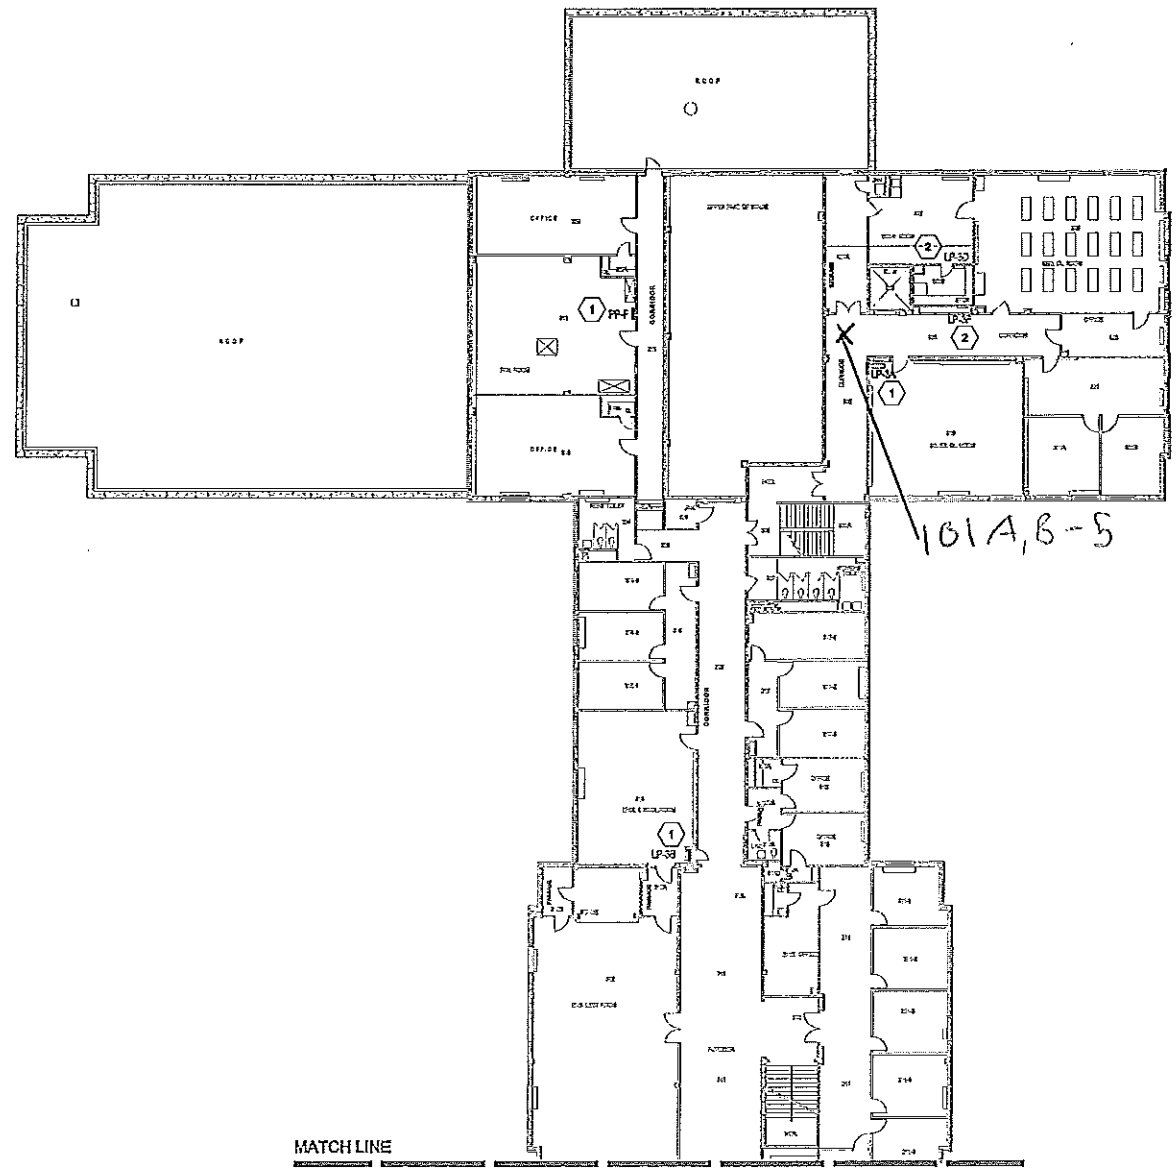

MATCH LINE  
SEE DWG. RIGHT SIDE

MATCH LINE  
SEE DWG. LEFT SIDE

- DRAWING SPECIFIC NOTES:**
- 1 REMOVE EXISTING PANELBOARD IN THIS LOCATION AND REPLACE WITH NEW PANEL BOARD AS SHOWN (NOT USED).
  - 2 REMAINS.
  - 3 LP 900 IS NOT BEING REPLACED, REMOVED ONLY.

**A1 SATTERLEE - THIRD FLOOR PLAN**  
SCALE: 1/8" = 1'-0"



0 5 10 20



**C&S Engineers, Inc.**  
499 Col. Eileen Collins Blvd.  
Syracuse, New York 13212  
Phone: 315-455-2000  
Fax: 315-455-9867  
www.cscos.com



STATE UNIVERSITY CONSTRUCTION FUND  
NEW YORK

STATE UNIVERSITY CONSTRUCTION FUND  
SUCF PROJECT NO. 12290  
STATE UNIVERSITY OF NEW YORK AT POTSDAM  
PRE-BID SUBMISSION - NOT FOR CONSTRUCTION  
UPGRADE ELECTRICAL DISTRIBUTION SYSTEMS  
VARIOUS BUILDINGS

MARK	DATE	DESCRIPTION
REVISIONS		
		PROJECT NO: 192433.001
		DATE: DECEMBER 5, 2009
		SCALE: AS SHOWN
		DRAWN BY: P.H.UUJ
		DESIGNED BY: T.G.MIKIEWICZ
		CHECKED BY: J.L.ROBBINS, P.E.

NO ALTERATION PERMITTED HEREON EXCEPT AS PROVIDED UNDER SECTION 7209 SUBSECTION 2 OF THE NEW YORK EDUCATION LAW


**ELECTRICAL**  
**SATTERLEE**  
**THIRD FLOOR**  
**PLANS**

**E-100-10d**

Jan 19, 2010 - 09:20am  
 P:\Projects\100-10d - Satterlee Third Floor - Electrical\100-10d.dwg  
 Plot: Satterlee Third Floor - Electrical - 100-10d.dwg  
 PLOT DATE: 1/19/10 9:20 AM  
 PLOT BY: J.L.ROBBINS, P.E.



**C&S Engineers, Inc.**  
 499 Col. Eileen Collins Blvd.  
 Syracuse, New York 13212  
 Phone: 315-455-2000  
 Fax: 315-455-9687  
 www.csoos.com

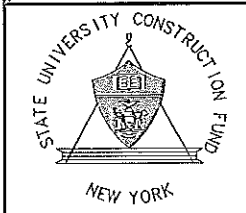


STATE UNIVERSITY CONSTRUCTION FUND  
 SUCF PROJECT NO. 12290  
 STATE UNIVERSITY OF NEW YORK AT POTSDAM  
 PRE-BID SUBMISSION - NOT FOR CONSTRUCTION  
 UPGRADE ELECTRICAL DISTRIBUTION SYSTEMS  
 VARIOUS BUILDINGS

MARK	DATE	DESCRIPTION
		REVISIONS
		PROJECT NO: 100433001
		DATE: DECEMBER 5, 2008
		SCALE: AS SHOWN
		DRAWN BY: P. H. LUU
		DESIGNED BY: T.G. MILKREWICZ
		CHECKED BY: J.L. ROBBINS, P.E.

**ELECTRICAL**  
**DUNN**  
**BASEMENT & 1ST**  
**FLOOR PLANS**

**E-100-11a**

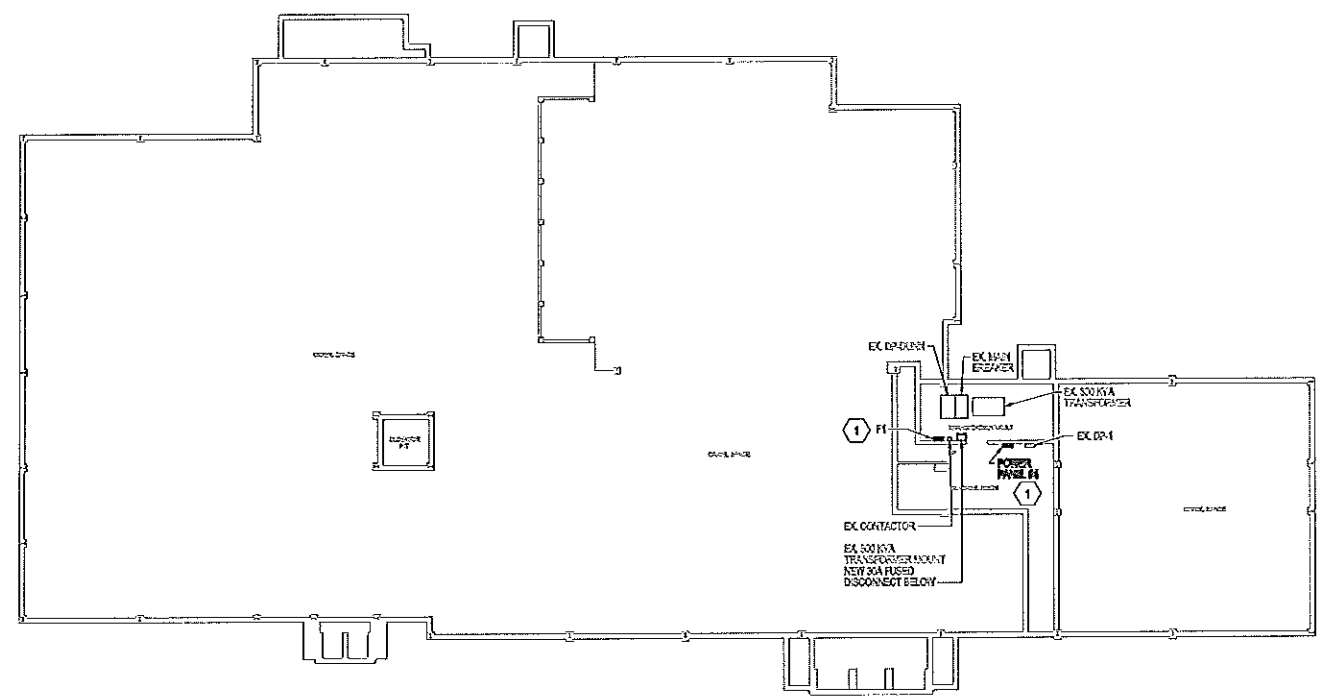


1 DRAWING SPECIFIC NOTES:  
 REMOVE EXISTING PANELBOARD IN THIS LOCATION AND REPLACE WITH NEW PANEL BOARD AS SHOWN.



0 5 10 20

**C1 DUNN - BASEMENT PLAN**  
 SCALE: 1/8" = 1'-0"

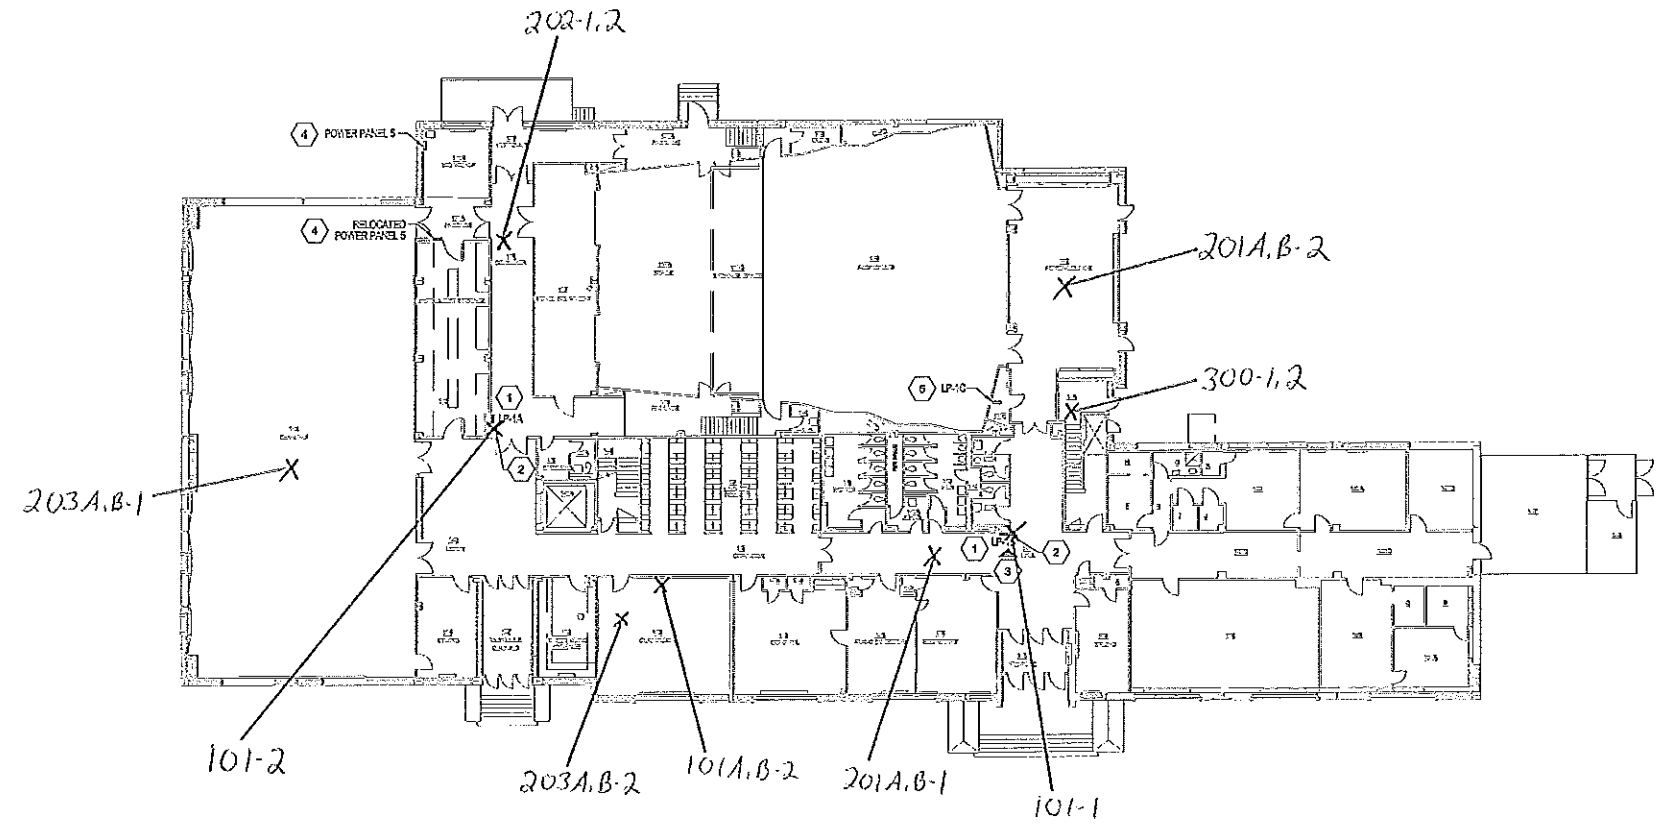

- DRAWING SPECIFIC NOTES:
- 1 REMOVE EXISTING PANELBOARD IN THIS LOCATION AND REPLACE WITH NEW PANEL BOARD AS SHOWN.
  - 2 SEE DETAIL A-301 FOR ARCHITECTURAL WORK.
  - 3 SEE PHOTO DUNN-1.
  - 4 REMOVE EXISTING POWER PANEL & RELOCATE NEW PANEL AS SHOWN. REMOVE POWER BUS AND BREAKERS AND RELOCATE EXISTING PANEL BOX AS A/B ENTER MAIN POWER FEED AND CIRCUIT AS SHOWN AND REQUIRED.
  - 5 REVISIONS.




0 5 10 20

**A1 DUNN - FIRST FLOOR PLAN**  
 SCALE: 1/8" = 1'-0"



**C&S Engineers, Inc.**  
 499 Col. Elsen Collins Blvd.  
 Syracuse, New York 13212  
 Phone: 315-455-2000  
 Fax: 315-455-9887  
 www.cscos.com

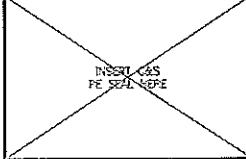


**STATE UNIVERSITY CONSTRUCTION FUND**  
 SUFCF PROJECT NO. 12290  
 STATE UNIVERSITY OF NEW YORK AT POTSDAM  
**PRE-BID SUBMISSION - NOT FOR CONSTRUCTION**  
**UPGRADE ELECTRICAL DISTRIBUTION SYSTEMS**  
**VARIOUS BUILDINGS**


MARK	DATE	DESCRIPTION
REVISIONS		
PROJECT NO: 191453001		
DATE: DECEMBER 5, 2003		
SCALE: AS SHOWN		
DRAWN BY: R.N. LUU		
DESIGNED BY: T.O. KLUNKOWCZ		
CHECKED BY: J.L. ROBBINS, P.E.		
NO ALTERATION PERMITTED HEREON EXCEPT AS PROVIDED UNDER SECTION 7209 SUBDIVISION 2 OF THE NEW YORK EDUCATION LAW		

**ELECTRICAL**  
**DUNN**  
**2ND & 3RD**  
**FLOOR PLANS**


**E-100-11b**

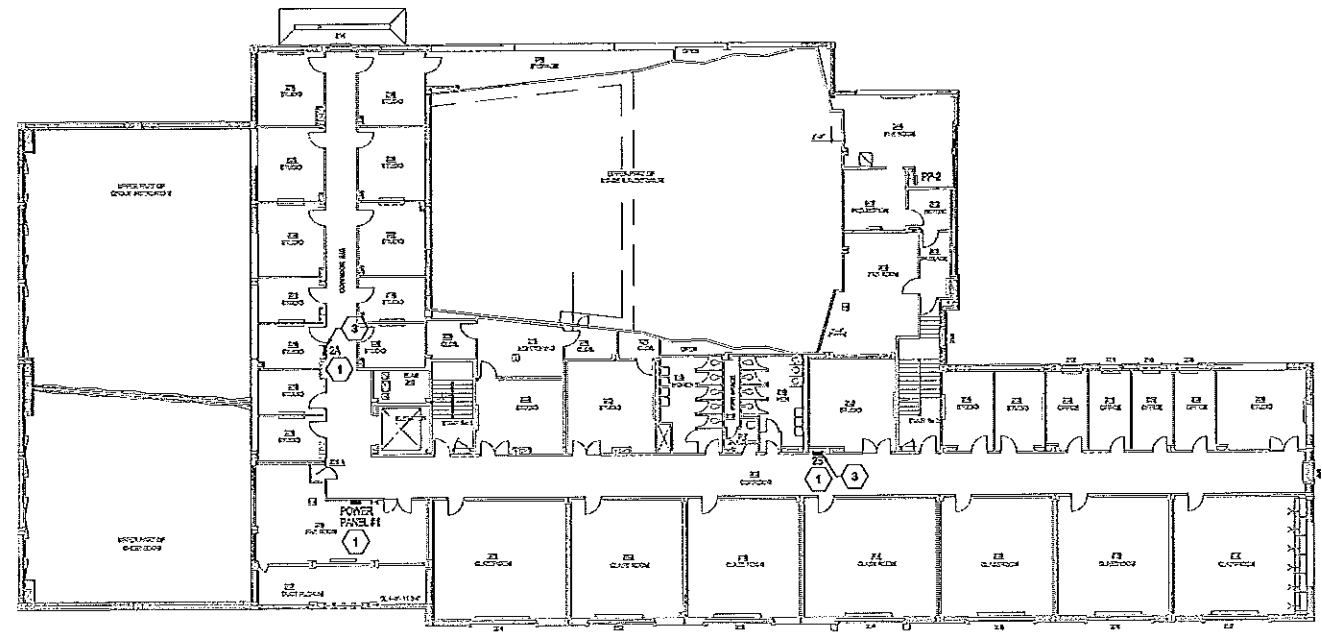


- DRAWING SPECIFIC NOTES:**
- 1 REMOVE EXISTING PANELBOARD IN THIS LOCATION AND REPLACE WITH NEW PANEL BOARD AS SHOWN
  - 2 SEE DETAIL 63A-51 FOR ARCHITECTURAL WORK
  - 3 SEE DETAIL 63A-51 FOR ARCHITECTURAL WORK

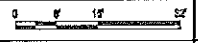

**C1 DUNN - SECOND FLOOR PLAN**  
 SCALE: 1/8" = 1'-0"

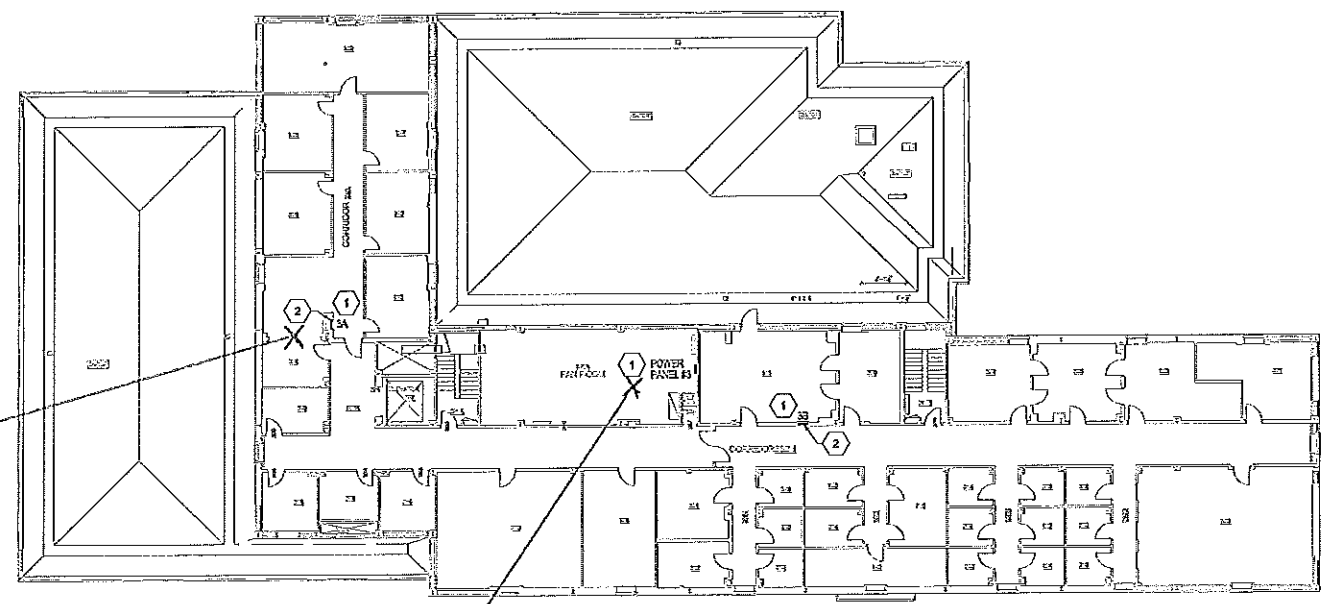


- DRAWING SPECIFIC NOTES:**
- 1 REMOVE EXISTING PANELBOARD IN THIS LOCATION AND REPLACE WITH NEW PANEL BOARD AS SHOWN
  - 2 SEE DETAIL 63A-51 FOR ARCHITECTURAL WORK
  - 3 SEE DETAIL 63A-51 FOR ARCHITECTURAL WORK

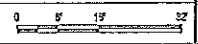

**A1 DUNN - THIRD FLOOR PLAN**  
 SCALE: 1/8" = 1'-0"

204-1,2,3



203A.B-3

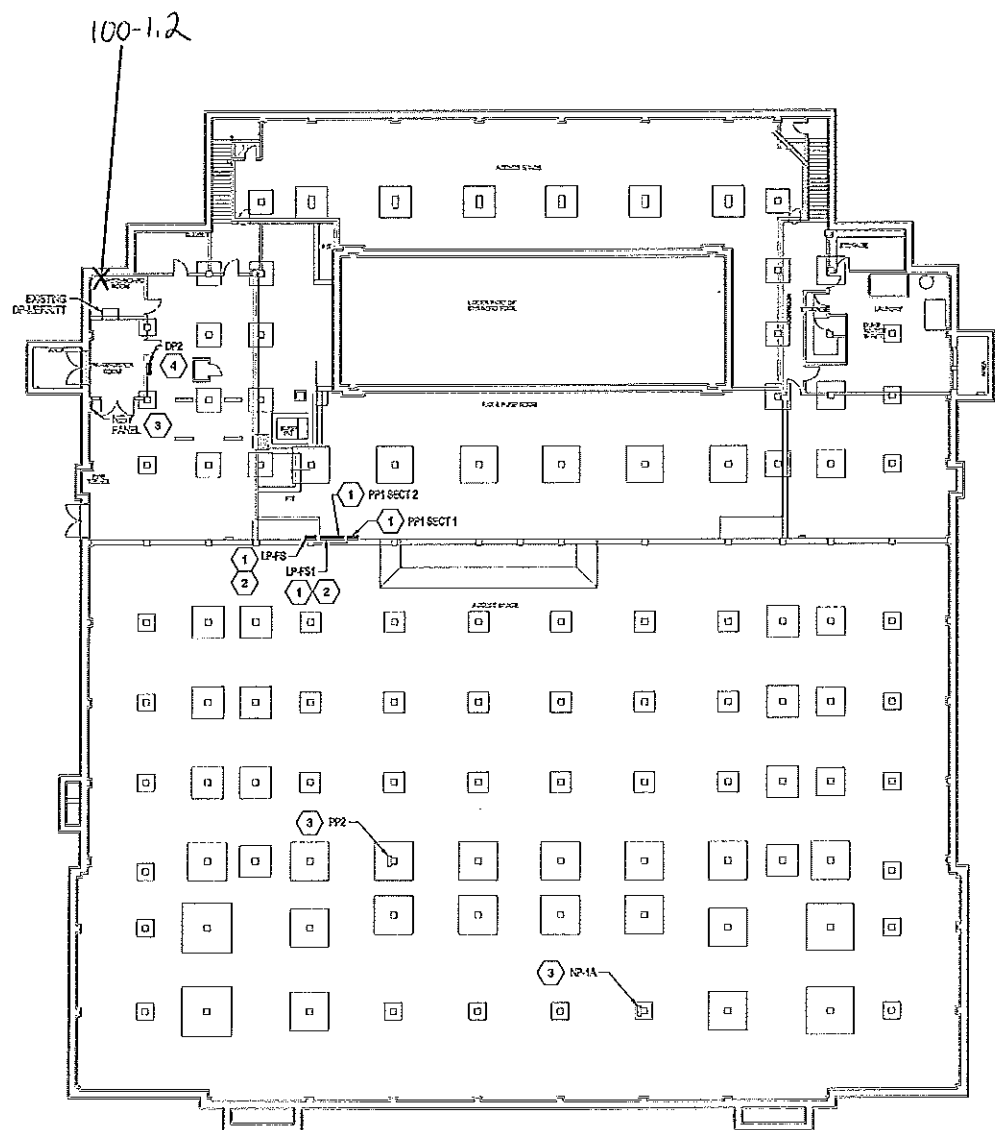

- DRAWING SPECIFIC NOTES:**
- 1 REMOVE EXISTING PANELBOARD IN THIS LOCATION AND REPLACE WITH NEW PANEL BOARD AS SHOWN.
  - 2 REMOVE ALL DISBURSED FEEDER CONDUIT SITS UPS BENEATH PANEL LP-FS1 AND LP-FS2.
  - 3 REMAINS.
  - 4 NEW DISTRIBUTION PANEL DP-2.



**A1 MERRITT - BASEMENT PLAN**  
SCALE: 1/8" = 1'-0"

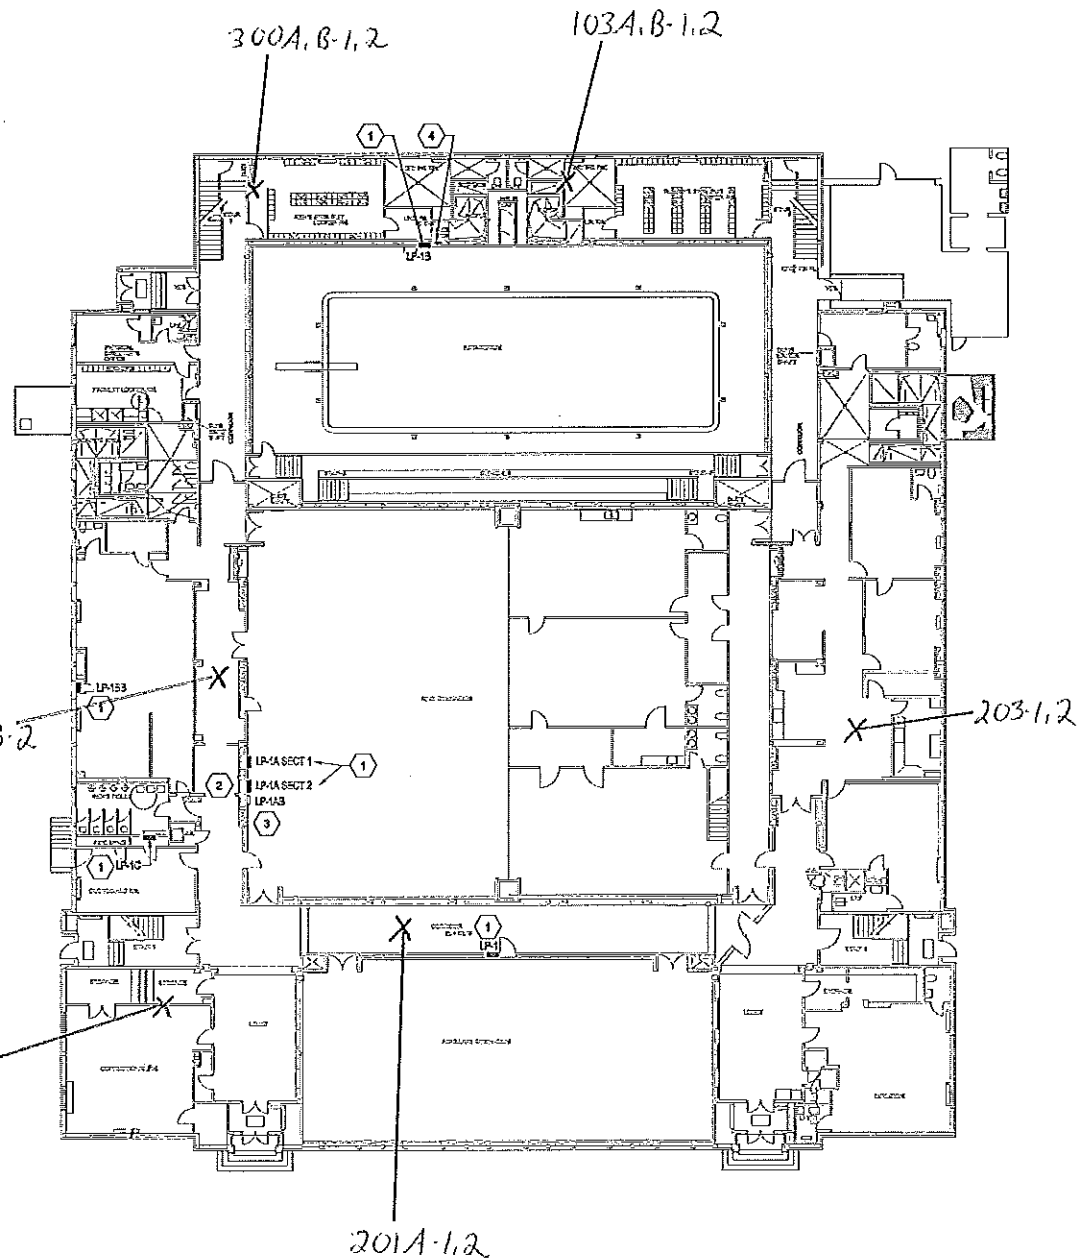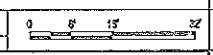



- DRAWING SPECIFIC NOTES:**
- 1 REMOVE EXISTING PANELBOARD IN THIS LOCATION AND REPLACE WITH NEW PANEL BOARD AS SHOWN.
  - 2 REMOVE EXISTING PANELBOARDS AND RELOCATE CIRCUITS TO NEW LP-1A SECTION 1 AND SECTION 2 PANELS AS SCHEDULED.
  - 3 REMOVE EXISTING PANELBOARD IN THIS LOCATION AND REPLACE CIRCUITS TO LP-1A SECTION 2 PANEL AS SHOWN.
  - 4 EXISTING LIGHTING CONTROL SWITCH TO BE REPIECED TO NEW CONTACTOR AS NOTED ON LP-1A SCHEDULE ON DRAWINGS E-101-12.



**A3 MERRITT - FIRST FLOOR PLAN**  
SCALE: 1/8" = 1'-0"



**C&S Engineers, Inc.**  
499 Col. Elmer Collins Blvd.  
Syracuse, New York 13212  
Phone: 315-455-2000  
Fax: 315-455-9667  
www.ccsos.com

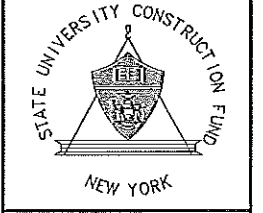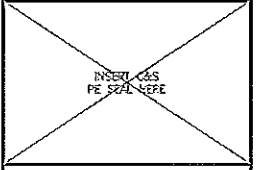

**STATE UNIVERSITY CONSTRUCTION FUND**  
SUCF PROJECT NO. 12290  
STATE UNIVERSITY OF NEW YORK AT POTSDAM  
**PRE-BID SUBMISSION - NOT FOR CONSTRUCTION**  
**UPGRADE ELECTRICAL DISTRIBUTION SYSTEMS**  
**VARIOUS BUILDINGS**

MARK	DATE	DESCRIPTION

REVISIONS

PROJECT NO: 100453.001  
DATE: DECEMBER 5, 2003  
SCALE: AS SHOWN  
DRAWN BY: P.N.UJ  
DESIGNED BY: T.G. KILBREW  
CHECKED BY: J.L. ROSSINI, P.E.

NO ALTERATION PERMITTED HEREON EXCEPT AS PROVIDED UNDER SECTION 7209 SUBDIVISION 2 OF THE NEW YORK EDUCATION LAW

**ELECTRICAL**

**MERRITT**  
**BASEMENT & 1ST**  
**FLOOR PLANS**


**E-100-12a**





C&S Engineers, Inc.  
 499 Col. Eileen Collins Blvd.  
 Syracuse, New York 13212  
 Phone: 315-465-2000  
 Fax: 315-465-9937  
 www.cscs.com

INSERT GAS  
 PE SEAL HERE

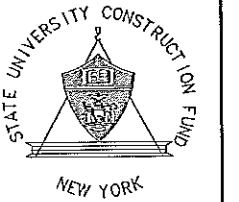


STATE UNIVERSITY CONSTRUCTION FUND  
 SUCF PROJECT NO. 12290  
 STATE UNIVERSITY OF NEW YORK AT POTSDAM  
 PRE-BID SUBMISSION - NOT FOR CONSTRUCTION  
 UPGRADE ELECTRICAL DISTRIBUTION SYSTEMS  
 VARIOUS BUILDINGS

MARK	DATE	DESCRIPTION
REVISIONS		
PROJECT NO:	193433.001	
DATE:	DECEMBER 5, 2008	
SCALE:	AS SHOWN	
DRAWN BY:	P. H. LUJ	
DESIGNED BY:	T.G. RUKERKZ	
CHECKED BY:	J.L. ROBBINS, P.E.	
NO ALTERATION PERMITTED HEREON EXCEPT AS PROVIDED UNDER SECTION 7209 SUBDIVISION 2 OF THE NEW YORK EDUCATION LAW		

ELECTRICAL  
 MERRITT  
 SECOND, THIRD &  
 ATTIC FLOOR PLANS

E-100-12b


Apr. 15, 2009 - Revision  
 and Approval by - SUCF Construction Fund

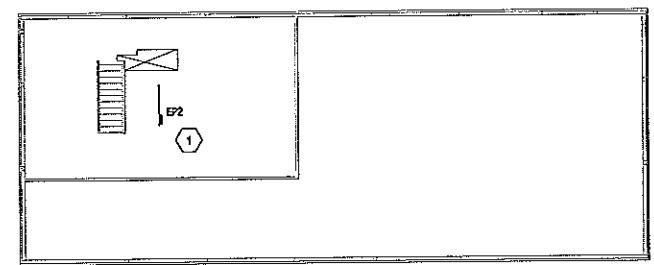

**DRAWING SPECIFIC NOTES**  
 ① REMOVE EXISTING PANEL BOARD IN THIS LOCATION AND  
 REPLACE WITH NEW PANEL BOARD AS SHOWN.




**A3 MERRITT - ATTIC FLOOR PLAN**  
 SCALE 1/8" = 1'-0"

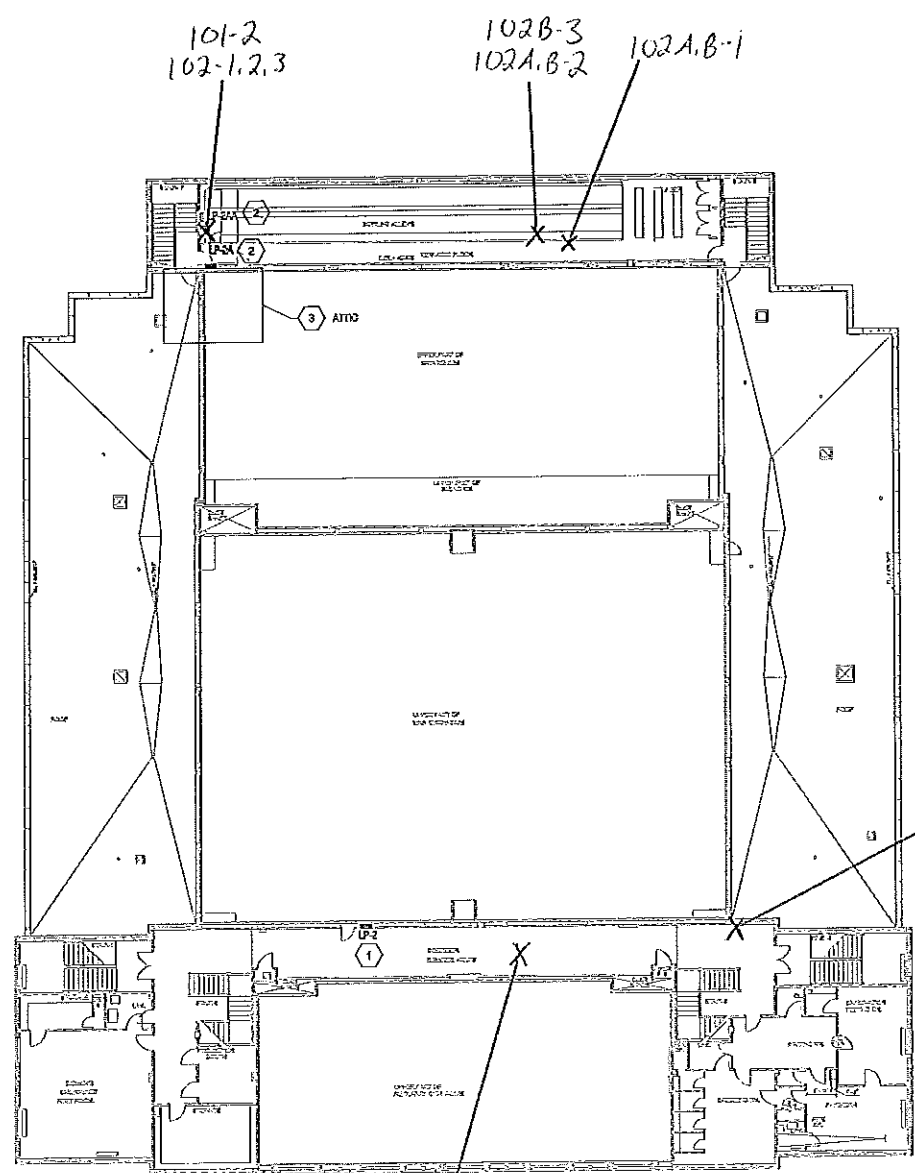

**DRAWING SPECIFIC NOTES**  
 ① REMOVE EXISTING PANEL BOARD IN THIS LOCATION AND  
 REPLACE WITH NEW PANEL BOARD AS SHOWN.  
 ② EXISTING UP-24A PANEL TO BE REMOVED AND THE 4-15 AMP, 1 POLE CIRCUITS TO EE  
 FIELD VERIFIED AND RELOCATED TO PANEL UP-2A.  
 ③ PANEL EP-2 LOCATED IN ATTIC.



**A1 MERRITT - SECOND FLOOR PLAN**  
 SCALE 1/8" = 1'-0"

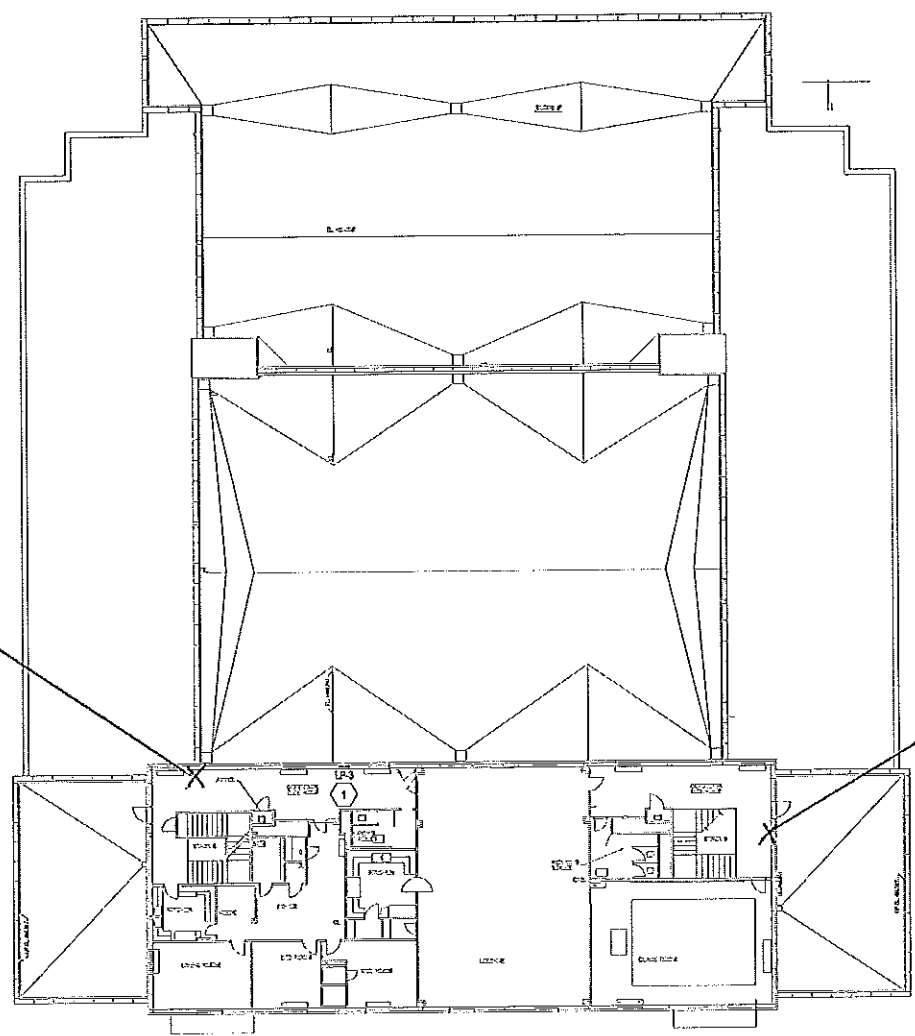

**DRAWING SPECIFIC NOTES**  
 ① REMOVE EXISTING PANEL BOARD IN THIS LOCATION AND  
 REPLACE WITH NEW PANEL BOARD AS SHOWN.




**A3 MERRITT - THIRD FLOOR PLAN**  
 SCALE 1/8" = 1'-0"





**C&S Engineers, Inc.**  
 499 Col. Eileen Collins Blvd.  
 Syracuse, New York 13212  
 Phone: 315-455-2000  
 Fax: 315-455-9987  
 www.cscos.com

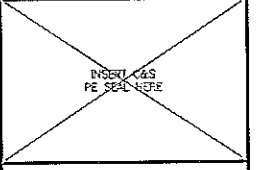


STATE UNIVERSITY CONSTRUCTION FUND  
 SUCF PROJECT NO. 12290  
 STATE UNIVERSITY OF NEW YORK AT POISSDAM  
 PRE-BID SUBMISSION - NOT FOR CONSTRUCTION  
 UPGRADE ELECTRICAL DISTRIBUTION SYSTEMS  
 VARIOUS BUILDINGS

MARK	DATE	DESCRIPTION
REVISIONS		


PROJECT NO: 100.433.001  
 DATE: DECEMBER 8, 2008  
 SCALE: AS SHOWN  
 DRAWN BY: P.H. LUI  
 DESIGNED BY: T.G. KUKIENKOZ  
 CHECKED BY: J.L. ROBBEN, P.E.  
 NO ALTERATION PERMITTED HEREON  
 EXCEPT AS PROVIDED UNDER SECTION  
 7209 SUBDIVISION 2 OF THE NEW YORK  
 EDUCATION LAW

**ELECTRICAL**  
**HEATING PLANT FIRST & SECOND FLOOR PLANS**  
**E-101-13**

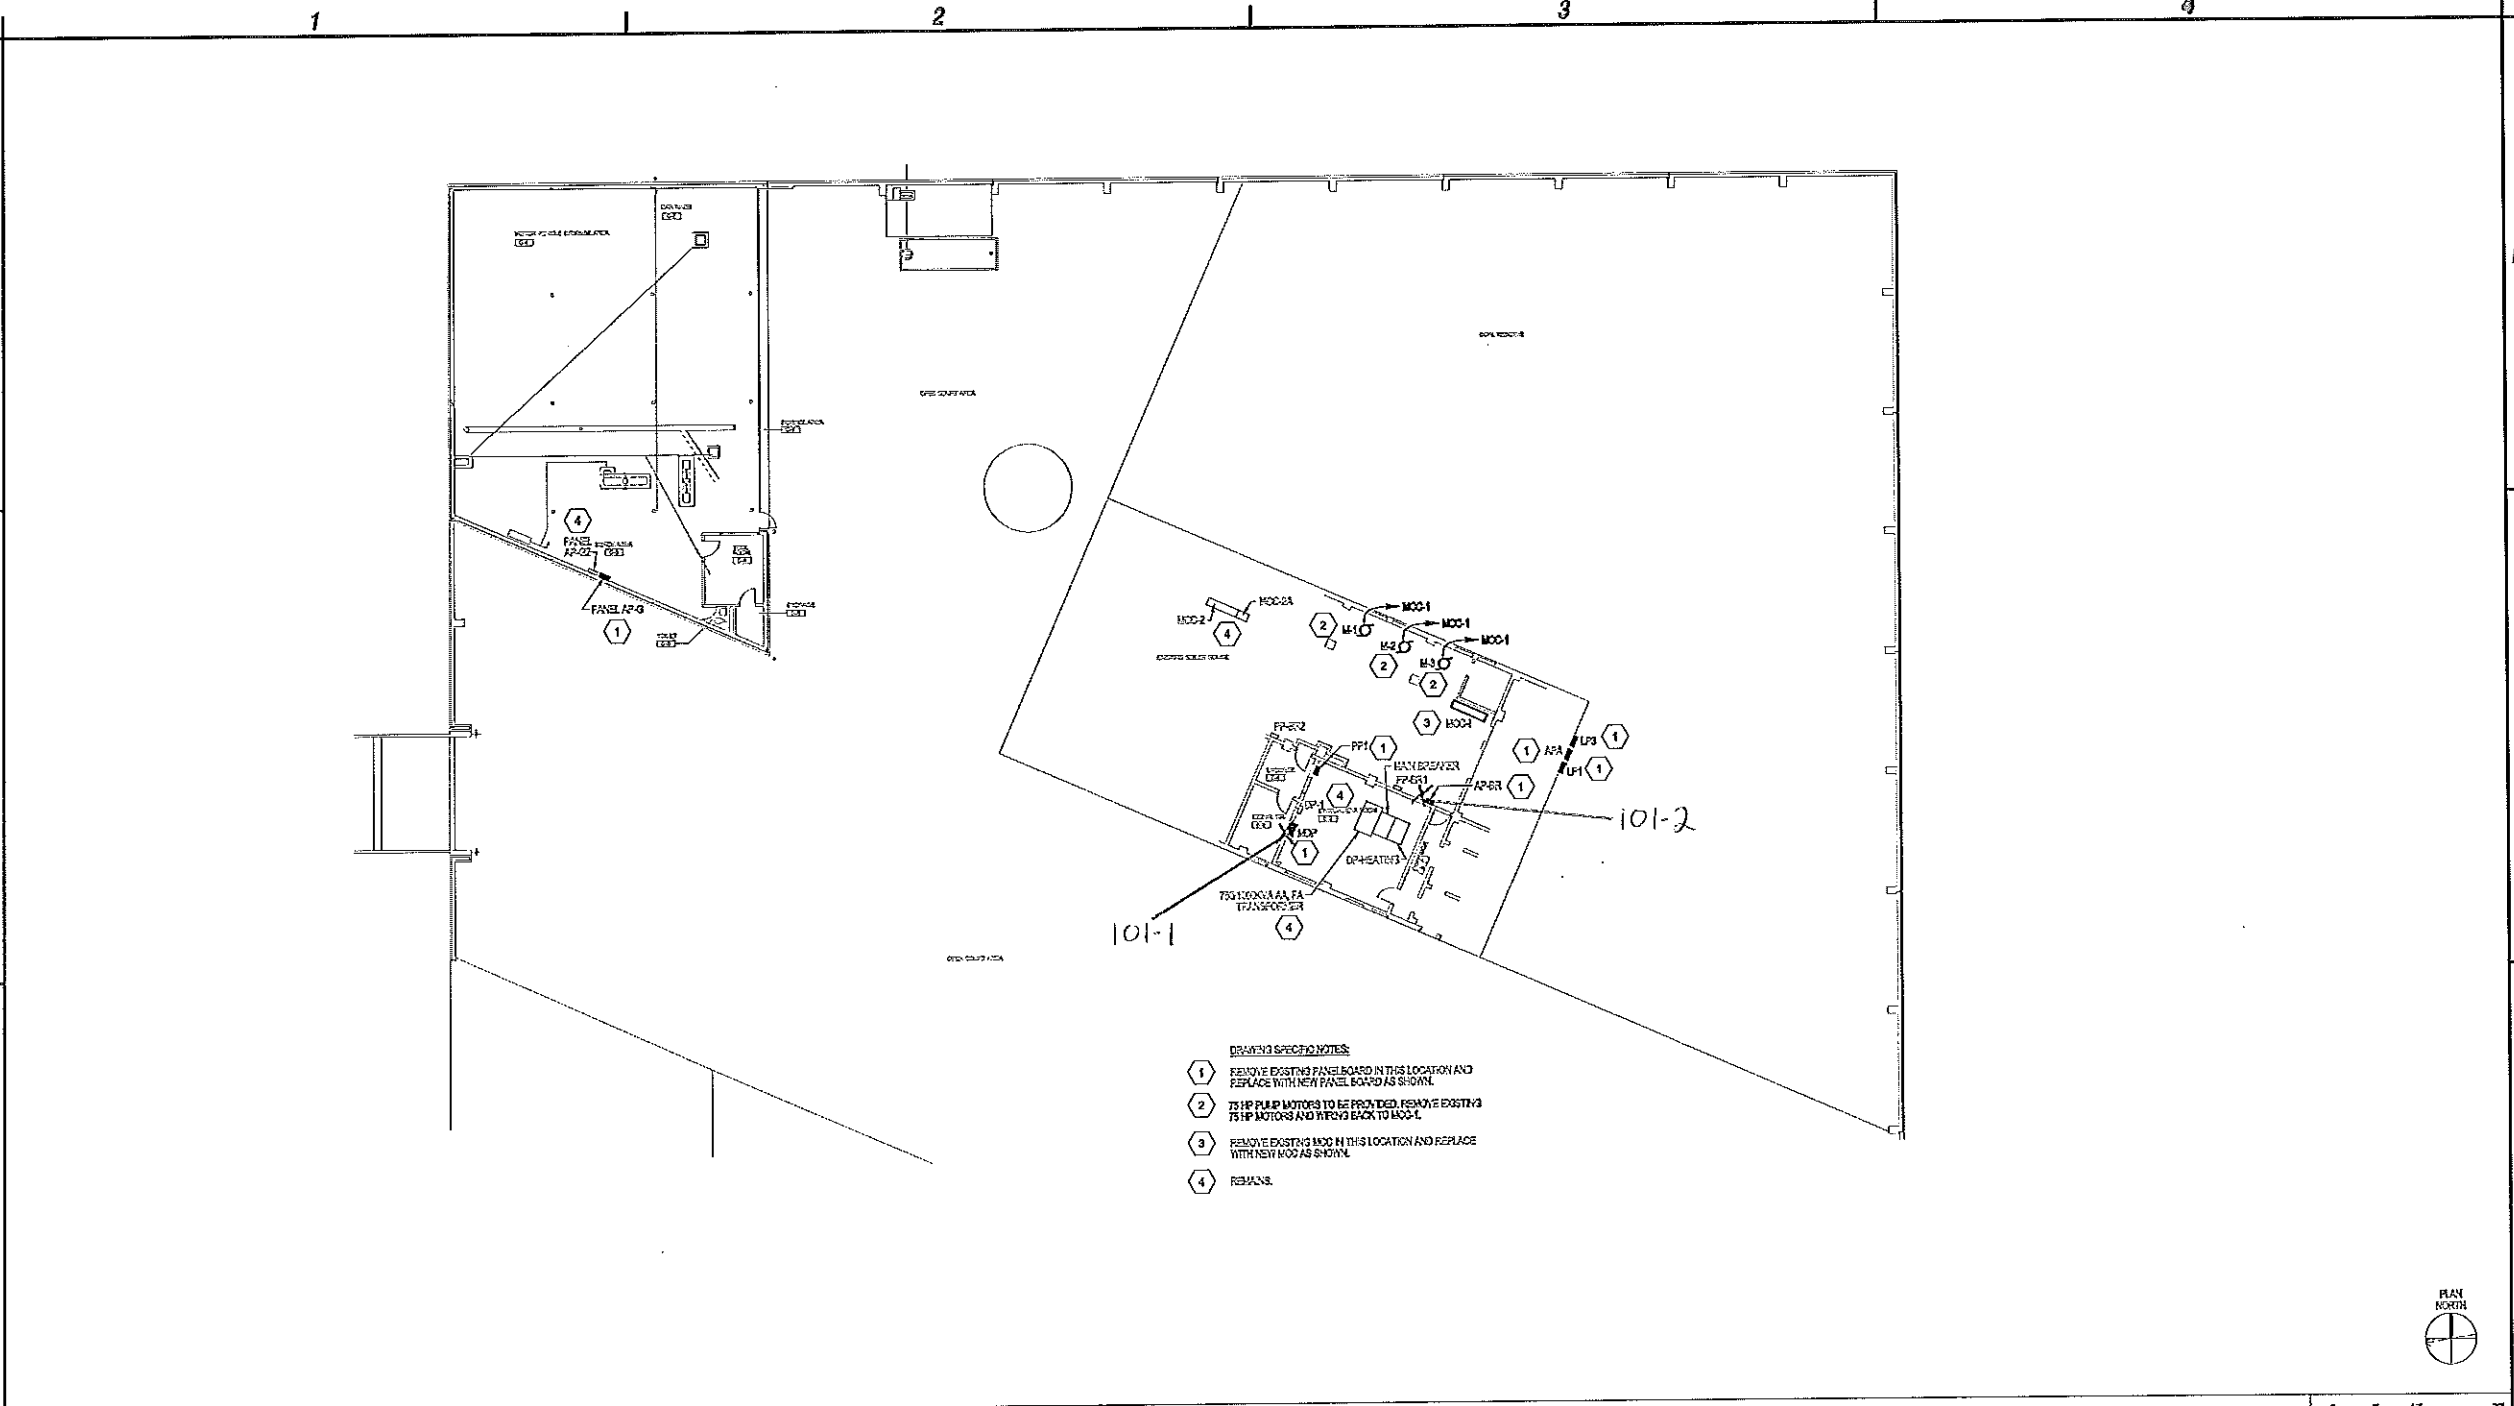

- DRAWING SPECIFIC NOTES:**
- REMOVE EXISTING PANELBOARDS IN THIS LOCATION AND REPLACE WITH NEW PANEL BOARD AS SHOWN.
  - 75 HP PUMP MOTORS TO BE PROVIDED. REMOVE EXISTING 75 HP MOTORS AND RERIG BACK TO EX-1.
  - REMOVE EXISTING MOD IN THIS LOCATION AND REPLACE WITH NEW MOD AS SHOWN.
  - REMAINS.

**B1 HEATING PLANT - FIRST FLOOR PLAN**  
 SCALE: 1/4" = 1'-0"

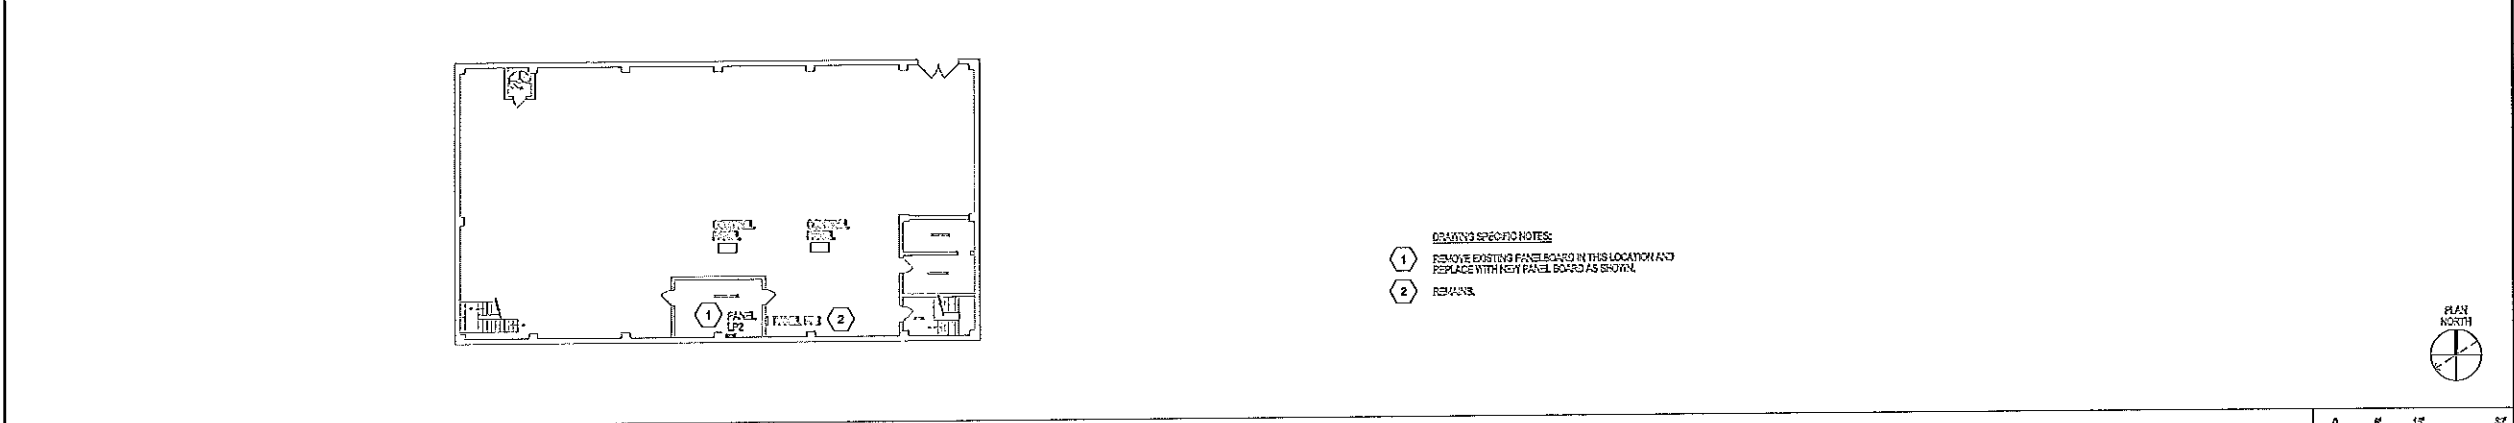

- DRAWING SPECIFIC NOTES:**
- REMOVE EXISTING PANELBOARDS IN THIS LOCATION AND REPLACE WITH NEW PANEL BOARD AS SHOWN.
  - REMAINS.

**A1 HEATING PLANT - SECOND FLOOR PLAN (BOILER HOUSE)**  
 SCALE: 1/4" = 1'-0"



**C&S Engineers, Inc.**  
 499 Col. Eileen Collins Blvd.  
 Syracuse, New York 13212  
 Phone: 315-455-2000  
 Fax: 315-455-9967  
 www.cscs.com

INSERT C&S  
 PE SEAL HERE




STATE UNIVERSITY CONSTRUCTION FUND  
 SUCF PROJECT NO. 12290  
 STATE UNIVERSITY OF NEW YORK AT POTSDAM  
**PRE-BID SUBMISSION - NOT FOR CONSTRUCTION**  
**UPGRADE ELECTRICAL DISTRIBUTION SYSTEMS**  
**VARIOUS BUILDINGS**

MARK	DATE	DESCRIPTION
REVISIONS		
PROJECT NO: 190.453.001		
DATE: DECEMBER 5, 2003		
SCALE: AS SHOWN		
DRAWN BY: P.H.WJ		
DESIGNED BY: T.G.KURKOWCZ		
CHECKED BY: J.L.ROBERTS, P.E.		
NO ALTERATION PERMITTED HEREON EXCEPT AS PROVIDED UNDER SECTION 7209 SUBDIVISION 2 OF THE NEW YORK EDUCATION LAW		

**ELECTRICAL**  
**MOREY**  
**FIRST & SECOND**  
**FLOOR PLANS**

**E-100-15A**

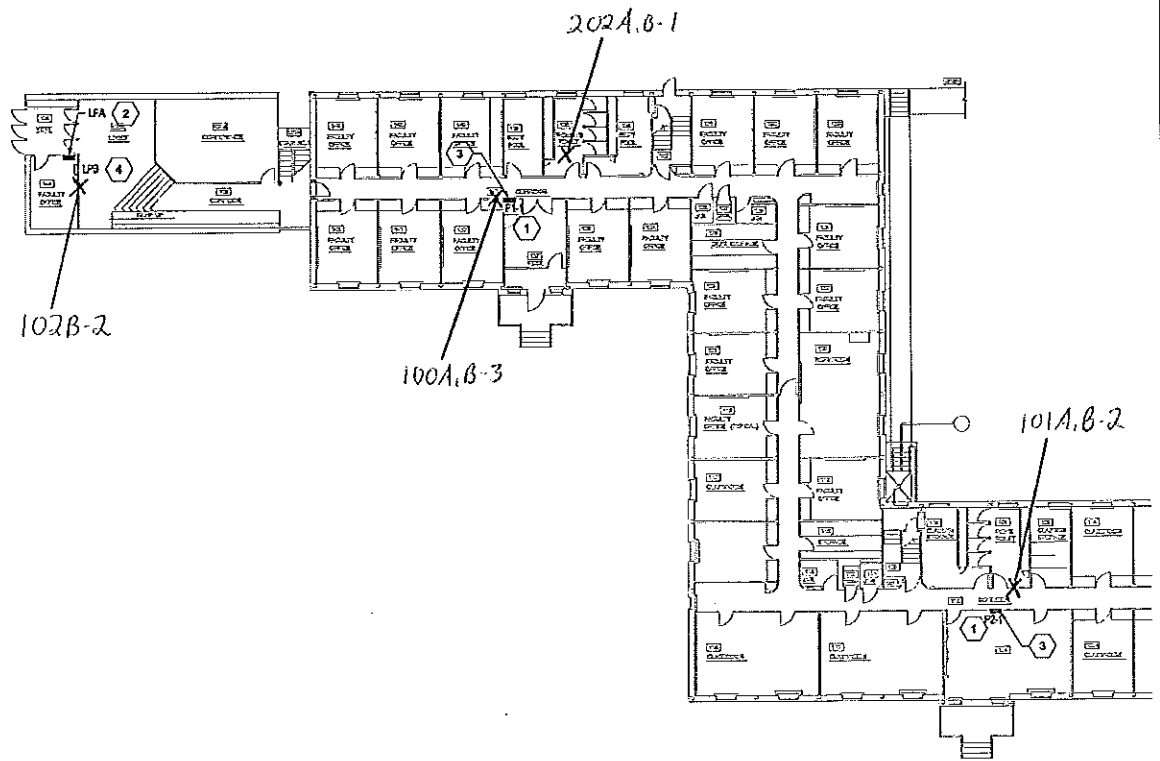


**GENERAL NOTE**  
 1. SEE DRAWING E-601-15B FOR ONE LINE DIAGRAM.

- DRAWING SPECIFIC NOTES**
- 1 REMOVE EXISTING PANELBOARD IN THIS LOCATION AND REPLACE WITH NEW PANEL BOARD AS SHOWN.
  - 2 REMOVE PANELBOARD LPA AND LPA. RELOCATE BRANCH CIRCUITS FROM PANEL LPA INTO NEW PANEL LPA. DO NOT REPLACE LPA. REUSE EXISTING LPA POWER FEED CIRCUITS AS SHOWN.
  - 3 SEE DETAIL A3.4-5.1 FOR ARCHITECTURAL WORK.
  - 4 REMAINS.



**A1 MOREY - FIRST FLOOR PLAN**  
 SCALE: 1/8" = 1'-0"

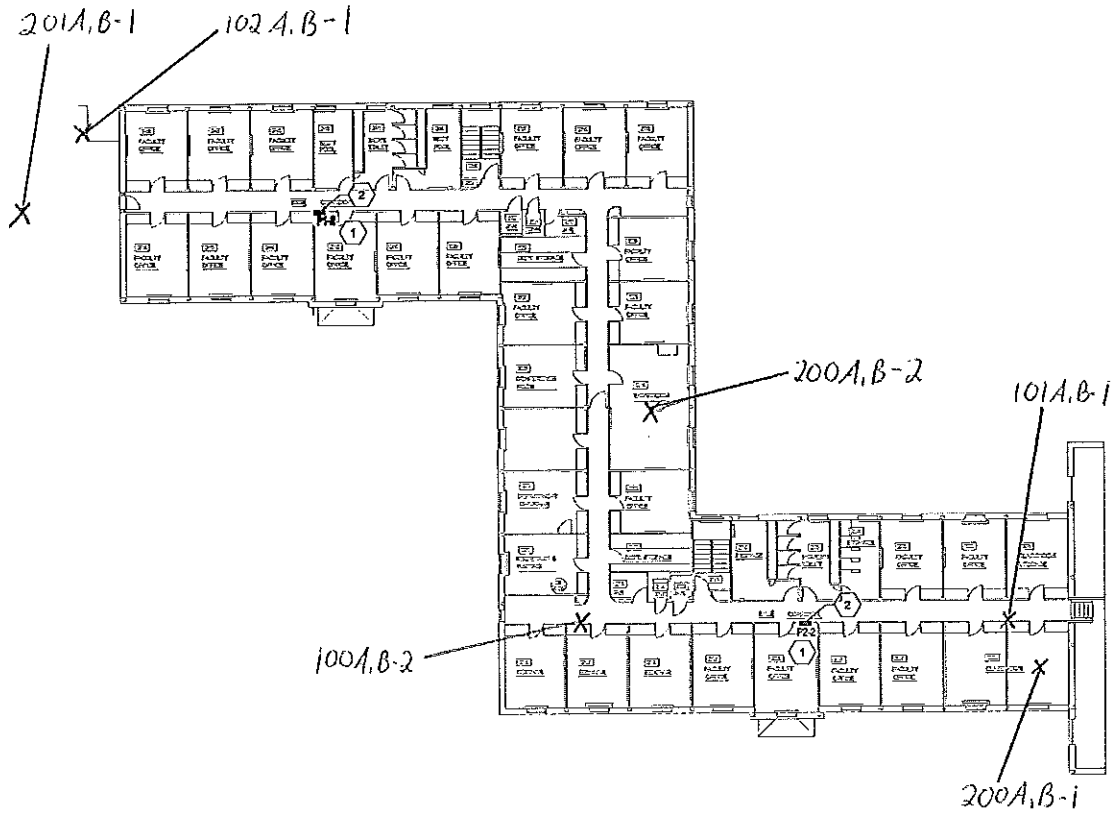


- DRAWING SPECIFIC NOTES**
- 1 REMOVE EXISTING PANELBOARD IN THIS LOCATION AND REPLACE WITH NEW PANEL BOARD AS SHOWN.
  - 2 SEE DETAIL A3.4-5.1 FOR ARCHITECTURAL WORK.
- GENERAL NOTE**  
 1. SEE DRAWING E-601-15B FOR ONE LINE DIAGRAM.



**A3 MOREY - SECOND FLOOR PLAN**  
 SCALE: 1/8" = 1'-0"



**C&S Engineers, Inc.**  
 499 Col. Elson Collins Blvd.  
 Syracuse, New York 13212  
 Phone: 315-455-2000  
 Fax: 315-455-9667  
 www.cscos.com

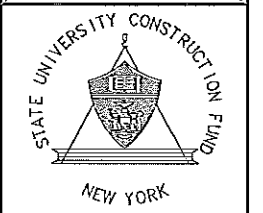



**STATE UNIVERSITY CONSTRUCTION FUND**  
 SUCF PROJECT NO. 12290  
 STATE UNIVERSITY OF NEW YORK AT POTSDAM  
**PRE-BID SUBMISSION - NOT FOR CONSTRUCTION**  
**UPGRADE ELECTRICAL DISTRIBUTION SYSTEMS**  
**VARIOUS BUILDINGS**

MARK	DATE	DESCRIPTION
REVISIONS		
		PROJECT NO. 190433.001
		DATE: DECEMBER 5, 2003
		SCALE: AS SHOWN
		DRAWN BY: P.N. LUJ
		DESIGNED BY: T.G. KILKENNY
		CHECKED BY: J.L. ROBERTS, P.E.

**ELECTRICAL**  
**CARSON**  
**BASEMENT & 1ST FLOOR PLANS**

**E-100-15Ba**

Jan 19, 2004 - Original  
 E:\Drawing\100 - 15Ba - 100-15Ba-15Ba.dwg  
 Plot: CarsonBasement1stFloor.dwg  
 Plot Date: 12/15/03 1:28:58 PM  
 Plot Path: C:\Program Files\Autodesk\AutoCAD 2004\Plot\ CarsonBasement1stFloor.dwg

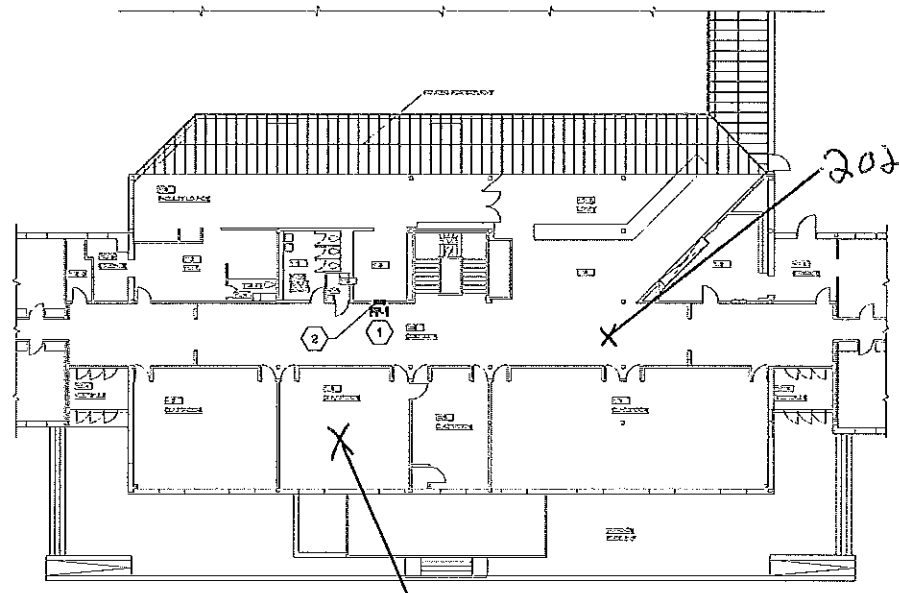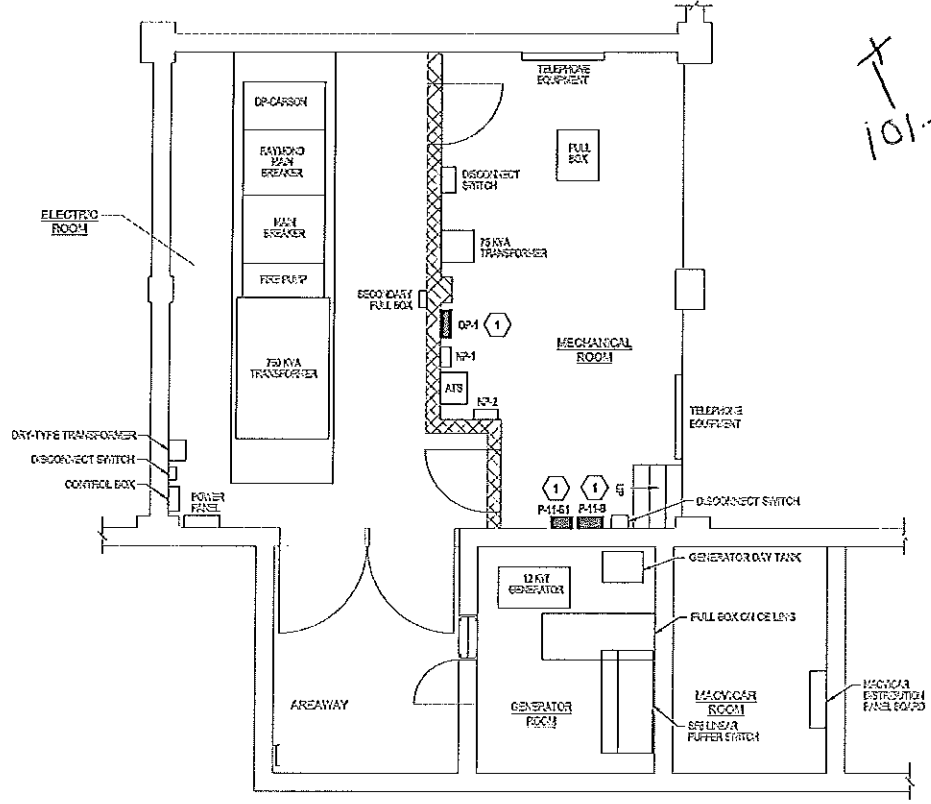

- DRAWING SPECIFIC NOTES:**
- (1) REMOVE EXISTING PANELBOARD IN THIS LOCATION AND REPLACE WITH NEW PANEL BOARD AS SHOWN.
  - (2) SEE DETAIL AREA 201 FOR ARCHITECTURAL WORK.





**A1 CARSON - BASEMENT PLAN**  
 SCALE 1/4" = 1'-0"

**A3 CARSON - FIRST FLOOR PLAN**  
 SCALE 1/4" = 1'-0"



**C&S Engineers, Inc.**  
 499 Col. Eliseo Collins Blvd.  
 Syracuse, New York 13212  
 Phone: 315-455-2000  
 Fax: 315-455-9997  
 www.ccs.com

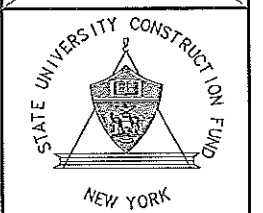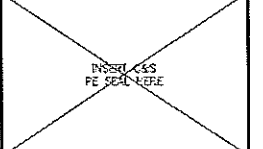

STATE UNIVERSITY CONSTRUCTION FUND  
 SUCF PROJECT NO. 12290  
 STATE UNIVERSITY OF NEW YORK AT POESDAM  
 PRE-BID SUBMISSION - NOT FOR CONSTRUCTION  
 UPGRADE ELECTRICAL DISTRIBUTION SYSTEMS  
 VARIOUS BUILDINGS

MARK	DATE	DESCRIPTION
REVISIONS		



PROJECT NO: 100-433-001  
 DATE: DECEMBER 5, 2003  
 SCALE: AS SHOWN  
 DRAWN BY: R. H. LUJ  
 DESIGNED BY: T. A. KUKSHEVZ  
 CHECKED BY: J. L. ROSSINI, P.E.

NO ALTERATION PERMITTED HEREON  
 EXCEPT AS PROVIDED UNDER SECTION  
 2203 SUBDIVISION 2 OF THE NEW YORK  
 EDUCATION LAW

**ELECTRICAL**

**CARSON  
 SECOND & THIRD  
 FLOOR PLANS**


**E-100-15Bb**

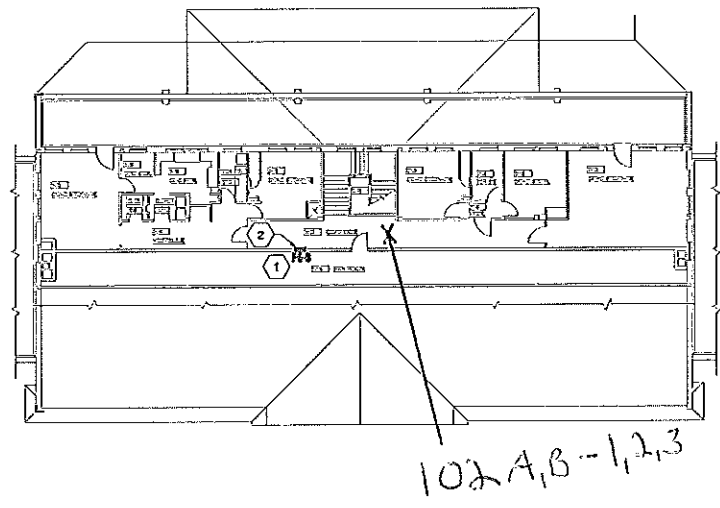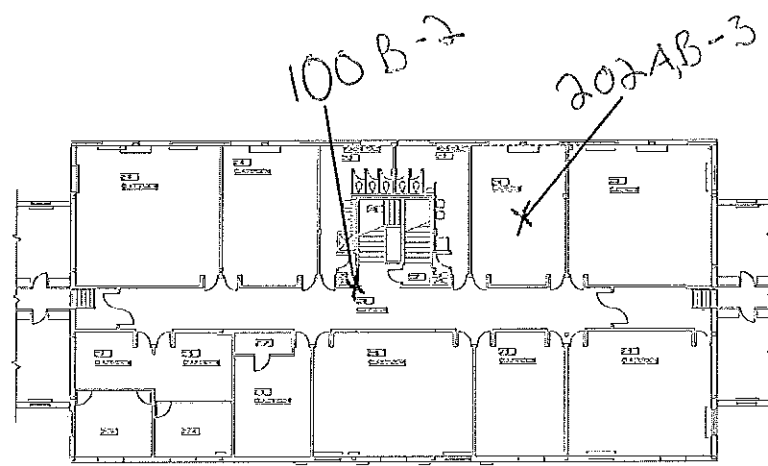


- DRAWING SPECIFICATIONS**
- ① REMOVE EXISTING PANEL BOARD IN THIS LOCATION AND REPLACE WITH NEW PANEL BOARD AS SHOWN.
  - ② SEE DETAIL E2A-51 FOR ARCHITECTURAL WORK




**A1 CARSON - SECOND FLOOR PLAN**  
 SCALE: 1/8" = 1'-0"

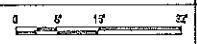

**A3 CARSON - THIRD FLOOR PLAN**  
 SCALE: 1/8" = 1'-0"

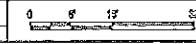

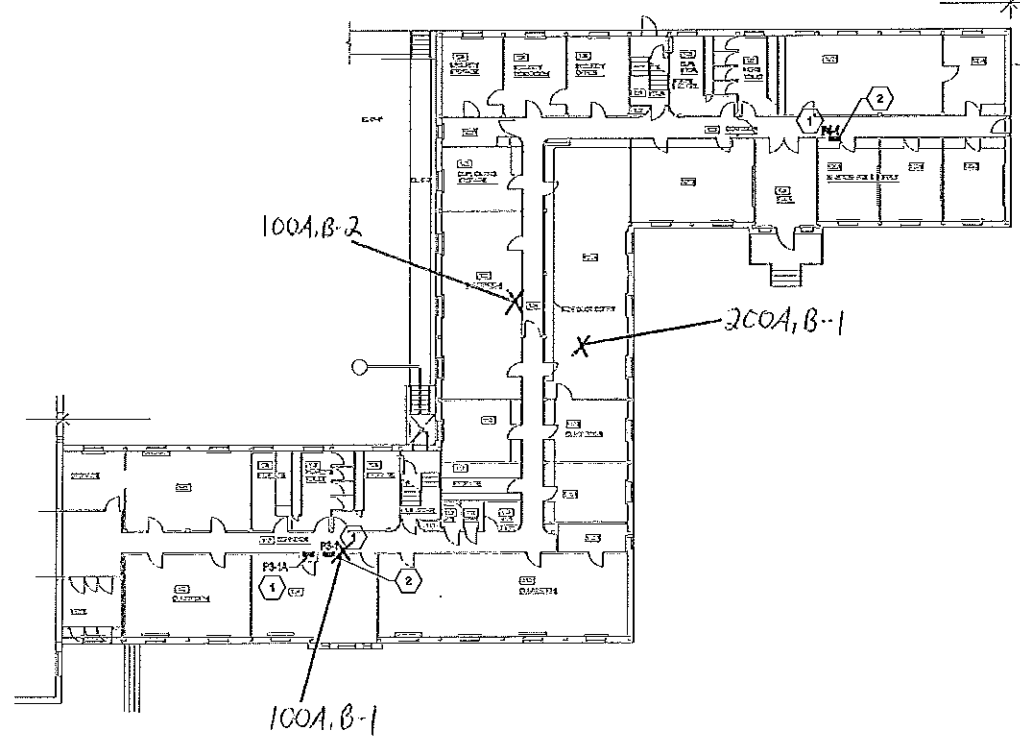


- DRAWING SPECIFIC NOTES:**
- 1 REMOVE EXISTING PANELBOARD IN THIS LOCATION AND REPLACE WITH NEW PANEL BOARD AS SHOWN.
  - 2 SEE DETAIL ASA-511 FOR ARCHITECTURAL WORK.

**GENERAL NOTE:**  
1. SEE DRAWING E-801-153 FOR ONE LINE DIAGRAMS.



**A1 MACVICAR - FIRST FLOOR PLAN**  
SCALE: 1/8" = 1'-0"

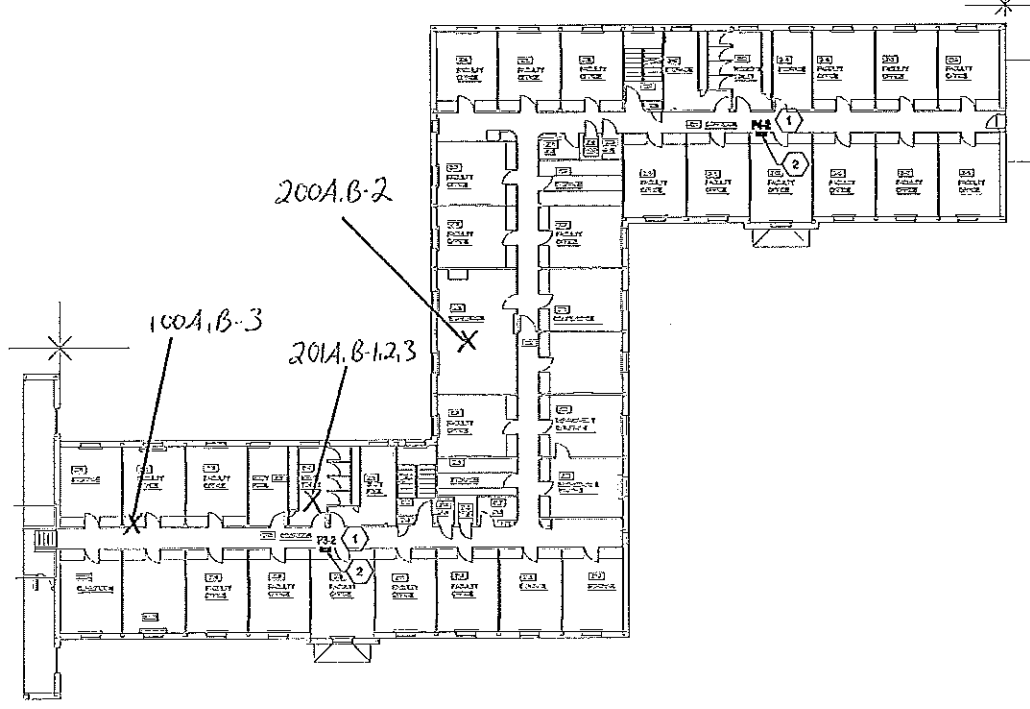

- DRAWING SPECIFIC NOTES:**
- 1 REMOVE EXISTING PANELBOARD IN THIS LOCATION AND REPLACE WITH NEW PANEL BOARD AS SHOWN.
  - 2 SEE DETAIL ASA-511 FOR ARCHITECTURAL WORK.


**GENERAL NOTE:**  
1. SEE DRAWING E-801-153 FOR ONE LINE DIAGRAMS.



**A3 MACVICAR - SECOND FLOOR PLAN**  
SCALE: 1/8" = 1'-0"



**C&S Engineers, Inc.**  
499 Col. Eileen Collins Blvd.  
Syracuse, New York 13212  
Phone: 315-455-2000  
Fax: 315-455-9687  
www.cscos.com

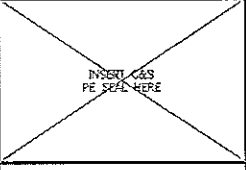

STATE UNIVERSITY CONSTRUCTION FUND  
SUCF PROJECT NO. 12290  
STATE UNIVERSITY OF NEW YORK AT POTSDAM  
**PRE-BID SUBMISSION - NOT FOR CONSTRUCTION**  
**UPGRADE ELECTRICAL DISTRIBUTION SYSTEMS**  
**VARIOUS BUILDINGS**

MARK	DATE	DESCRIPTION
REVISIONS		
PROJECT NO: 190483.001		
DATE: DECEMBER 5, 2009		
SCALE: AS SHOWN		
DRAWN BY: P.H. LUJ		
DESIGNED BY: T.C. NIKIEWICZ		
CHECKED BY: J.L. ROBBINS, P.E.		
NO ALTERATION PERMITTED HEREON EXCEPT AS PROVIDED UNDER SECTION 7209 SUBDIVISION 2 OF THE NEW YORK EDUCATION LAW.		

**ELECTRICAL**


**MACVICAR**  
**FIRST & SECOND**  
**FLOOR PLANS**

**E-100-15C**



**C&S Engineers, Inc.**  
 499 Col. Eileen Collins Blvd.  
 Syracuse, New York 13212  
 Phone: 315-455-2000  
 Fax: 315-455-9687  
 www.cscos.com

INSERT C&S  
 PE SEAL HERE

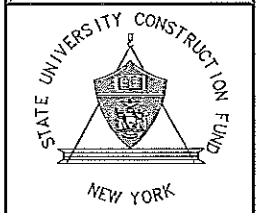

STATE UNIVERSITY CONSTRUCTION FUND  
 SUCF PROJECT NO. 12290  
 STATE UNIVERSITY OF NEW YORK AT POTSDAM  
 PRE-BID SUBMISSION - NOT FOR CONSTRUCTION  
 UPGRADE ELECTRICAL DISTRIBUTION SYSTEMS  
 VARIOUS BUILDINGS


MARK	DATE	DESCRIPTION
REVISIONS		
PROJECT NO: 191453.001		
DATE: DECEMBER 5, 2008		
SCALE: ASSHMAN		
DRAWN BY: P.N.WU		
DESIGNED BY: T.G.KLINKENAUZ		
CHECKED BY: J.L.ROBBINS, P.E.		

NO ALTERATION PERMITTED HEREON  
 EXCEPT AS PROVIDED UNDER SECTION  
 7209 SUBSECTION 2 OF THE NEW YORK  
 EDUCATION LAW

**ELECTRICAL**


**STILLMAN  
 FIRST & SECOND  
 FLOOR PLANS**

**E-100-15D**

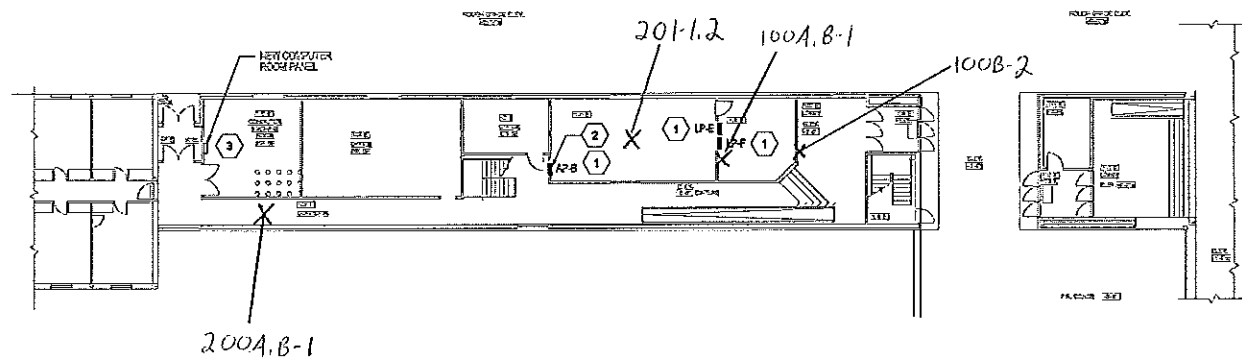

- DRAWING SPECIFIC NOTES:**
- 1 REMOVE EXISTING PANELBOARD IN THIS LOCATION AND REPLACE WITH NEW PANEL BOARD AS SHOWN.
  - 2 SEE DETAIL A2A-01 FOR ARCHITECTURAL WORK.
  - 3 REMAINS.


**C1 STILLMAN - FIRST FLOOR PLAN**  
 SCALE: 1/4" = 1'-0"

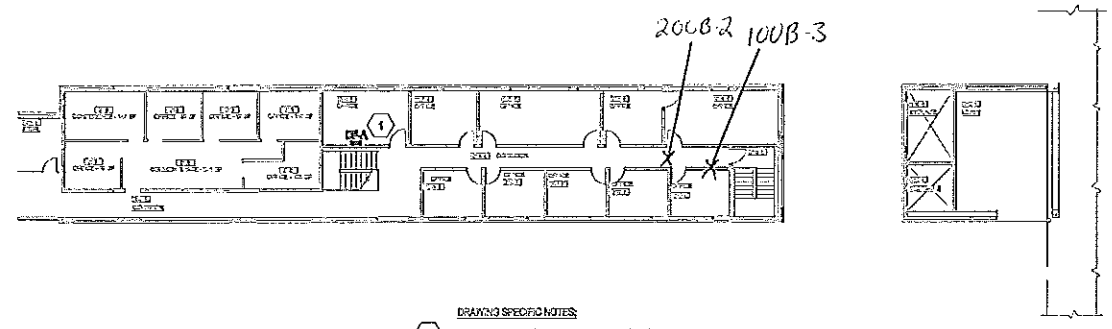



- DRAWING SPECIFIC NOTES:**
- 1 REMOVE EXISTING PANELBOARD IN THIS LOCATION AND REPLACE WITH NEW PANEL BOARD AS SHOWN.

**A1 STILLMAN - SECOND FLOOR PLAN**  
 SCALE: 1/4" = 1'-0"

APR 19, 2009 - 8:22AM  
 P:\Projects\100 - Stillman\100-15D - Stillman\100-15D.dwg

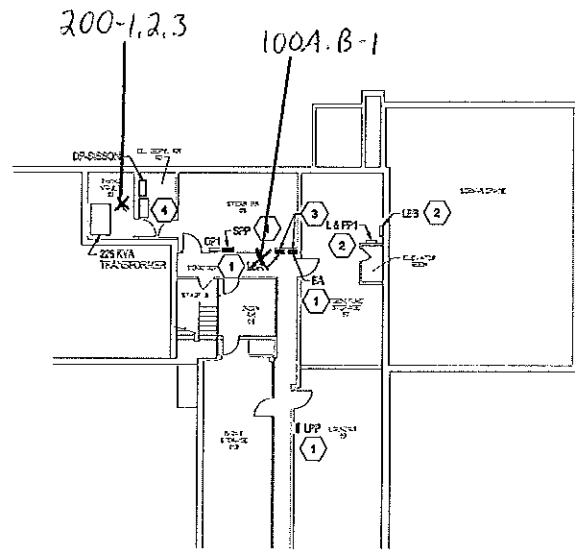

- DRAWING SPECIFIC NOTES**
- 1 REMOVE EXISTING PANELBOARD IN THIS LOCATION AND REPLACE WITH NEW PANEL BOARD AS SHOWN.
  - 2 REMAINS.
  - 3 SEE DETAIL AS-651 FOR ARCHITECTURAL WORK.
  - 4 OLD PANEL ENCLOSURE UTILIZED AS JUNCTION BOX.

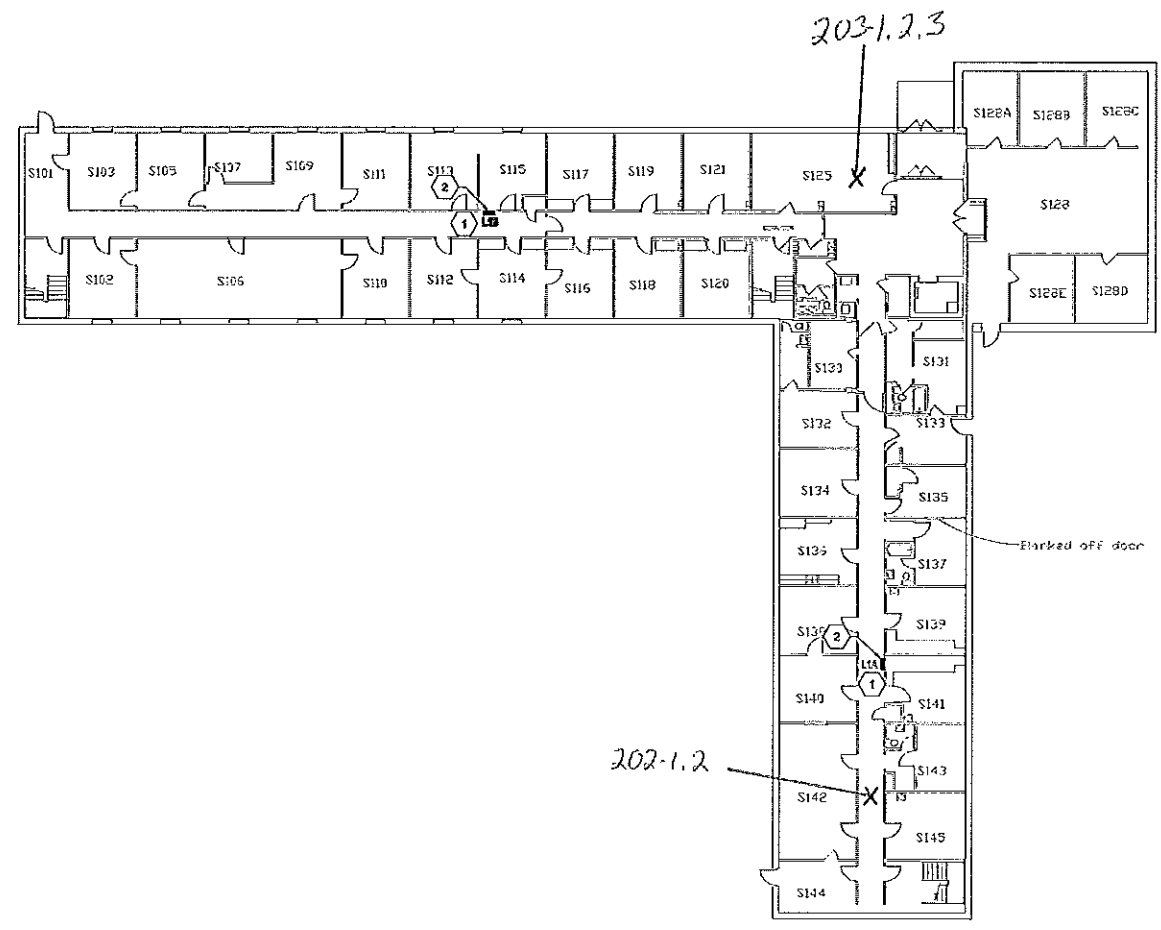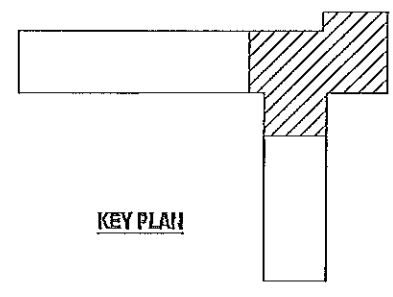

- DRAWING SPECIFIC NOTES**
- 1 REMOVE EXISTING PANELBOARD IN THIS LOCATION AND REPLACE WITH NEW PANEL BOARD AS SHOWN.
  - 2 SEE DETAIL AS-651 FOR ARCHITECTURAL WORK.



**C&S Engineers, Inc.**  
 499 Col. Elston Collins Blvd.  
 Syracuse, New York 13212  
 Phone: 315-455-2000  
 Fax: 315-455-9687  
 www.ccsos.com



**STATE UNIVERSITY CONSTRUCTION FUND**  
 SUCF PROJECT NO. 12290  
 STATE UNIVERSITY OF NEW YORK AT POITSDAM  
**PRE-BID SUBMISSION - NOT FOR CONSTRUCTION**  
**UPGRADE ELECTRICAL DISTRIBUTION SYSTEMS**  
**VARIOUS BUILDINGS**

REVISIONS
PROJECT NO: 190458.001
DATE: DECEMBER 5, 2008
SCALE: AS SHOWN
DRAWN BY: P.N.WJW
DESIGNED BY: T.R.KUMAR
CHECKED BY: J.L.HOBBS, P.E.
NO ALTERATION PERMITTED HEREON EXCEPT AS PROVIDED UNDER SECTION 7209 SUBDIVISION 2 OF THE NEW YORK EDUCATION LAW

**ELECTRICAL**

**SISSON**  
**BASEMENT & FIRST FLOOR PLANS**

**E-100-17a**

**A1 SISSON - PARTIAL BASEMENT PLAN**  
 SCALE: 1/8" = 1'-0"


**A3 SISSON - FIRST FLOOR PLAN**  
 SCALE: 1/8" = 1'-0"

DATE PLOTTED: 12/15/08 10:54 AM  
 PLOTTER: HP DesignJet 5000PS  
 PLOT SCALE: 1/8" = 1'-0"  
 PLOTTER MODEL: HP DesignJet 5000PS  
 PLOTTER SERIAL: F-1117-17a





C&S Engineers, Inc.  
 499 Col. Eileen Collins Blvd.  
 Syracuse, New York 13212  
 Phone: 315-455-2000  
 Fax: 315-455-6887  
 www.cscos.com

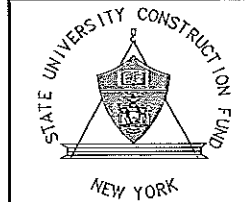

STATE UNIVERSITY CONSTRUCTION FUND  
 SUCF PROJECT NO. 12290  
 STATE UNIVERSITY OF NEW YORK AT POESDAM  
 PRE-BID SUBMISSION - NOT FOR CONSTRUCTION  
 UPGRADE ELECTRICAL DISTRIBUTION SYSTEMS  
 VARIOUS BUILDINGS


MARK	DATE	DESCRIPTION
REVISIONS		
PROJECT NO: 199.453.001		
DATE: DECEMBER 5, 2003		
SCALE: AS SHOWN		
DRAWN BY: P.N.UU		
DESIGNED BY: T.G. KUMAR		
CHECKED BY: J.L. ROBBINS, P.E.		

NO ALTERATION PERMITTED HEREON EXCEPT AS PROVIDED UNDER SECTION 2208 SUBDIVISION 2 OF THE NEW YORK EDUCATION LAW


**ELECTRICAL**

**SISSON SECOND & THIRD FLOOR PLANS**

**E-100-17b**

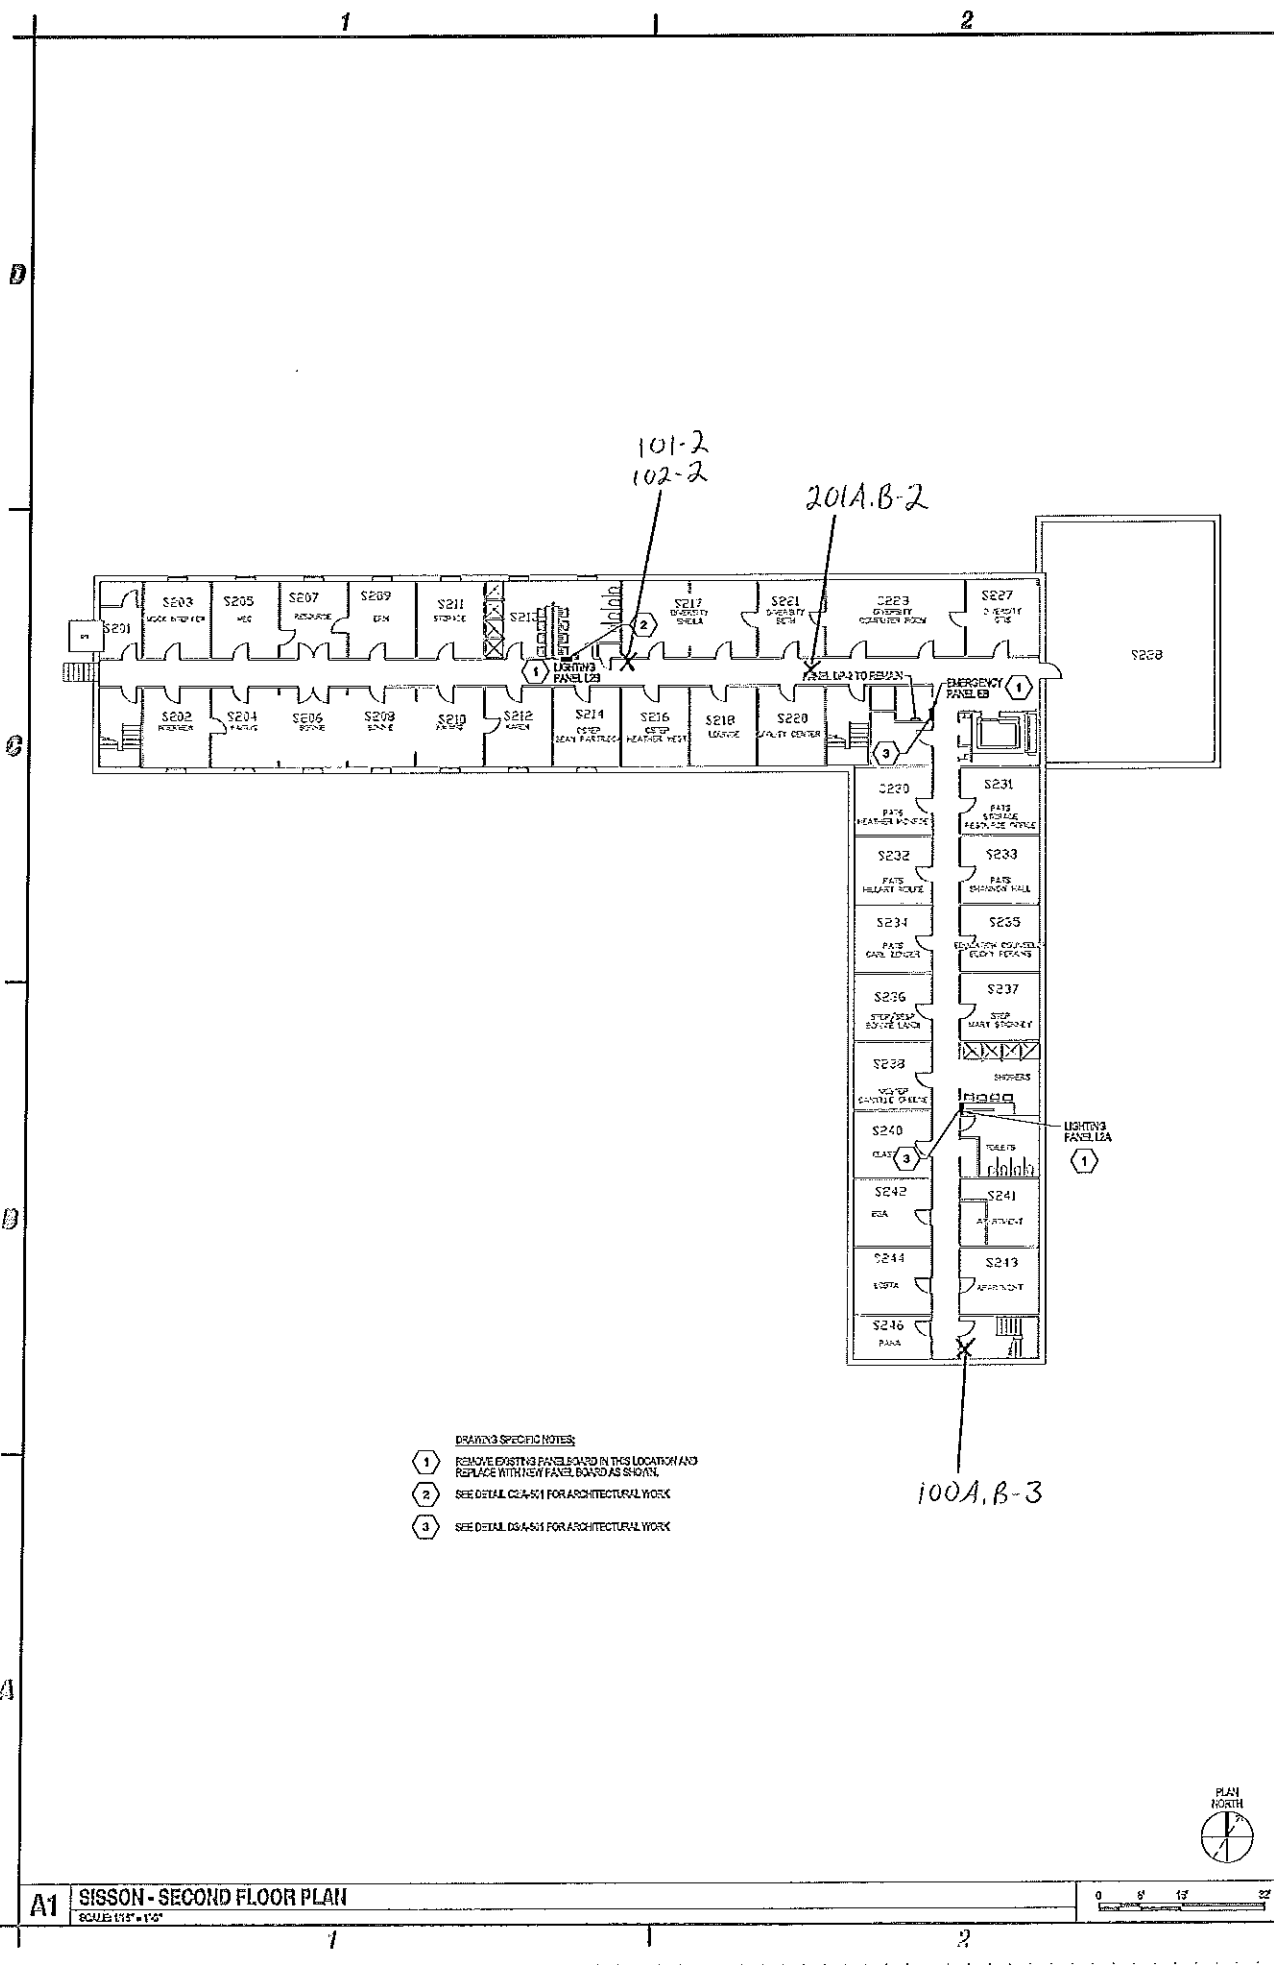


- DRAWING SPECIFIC NOTES**
- ① REMOVE EXISTING PANEL BOARD IN THIS LOCATION AND REPLACE WITH NEW PANEL BOARD AS SHOWN.
  - ② SEE DETAIL 02A-511 FOR ARCHITECTURAL WORK.
  - ③ SEE DETAIL 02A-511 FOR ARCHITECTURAL WORK.

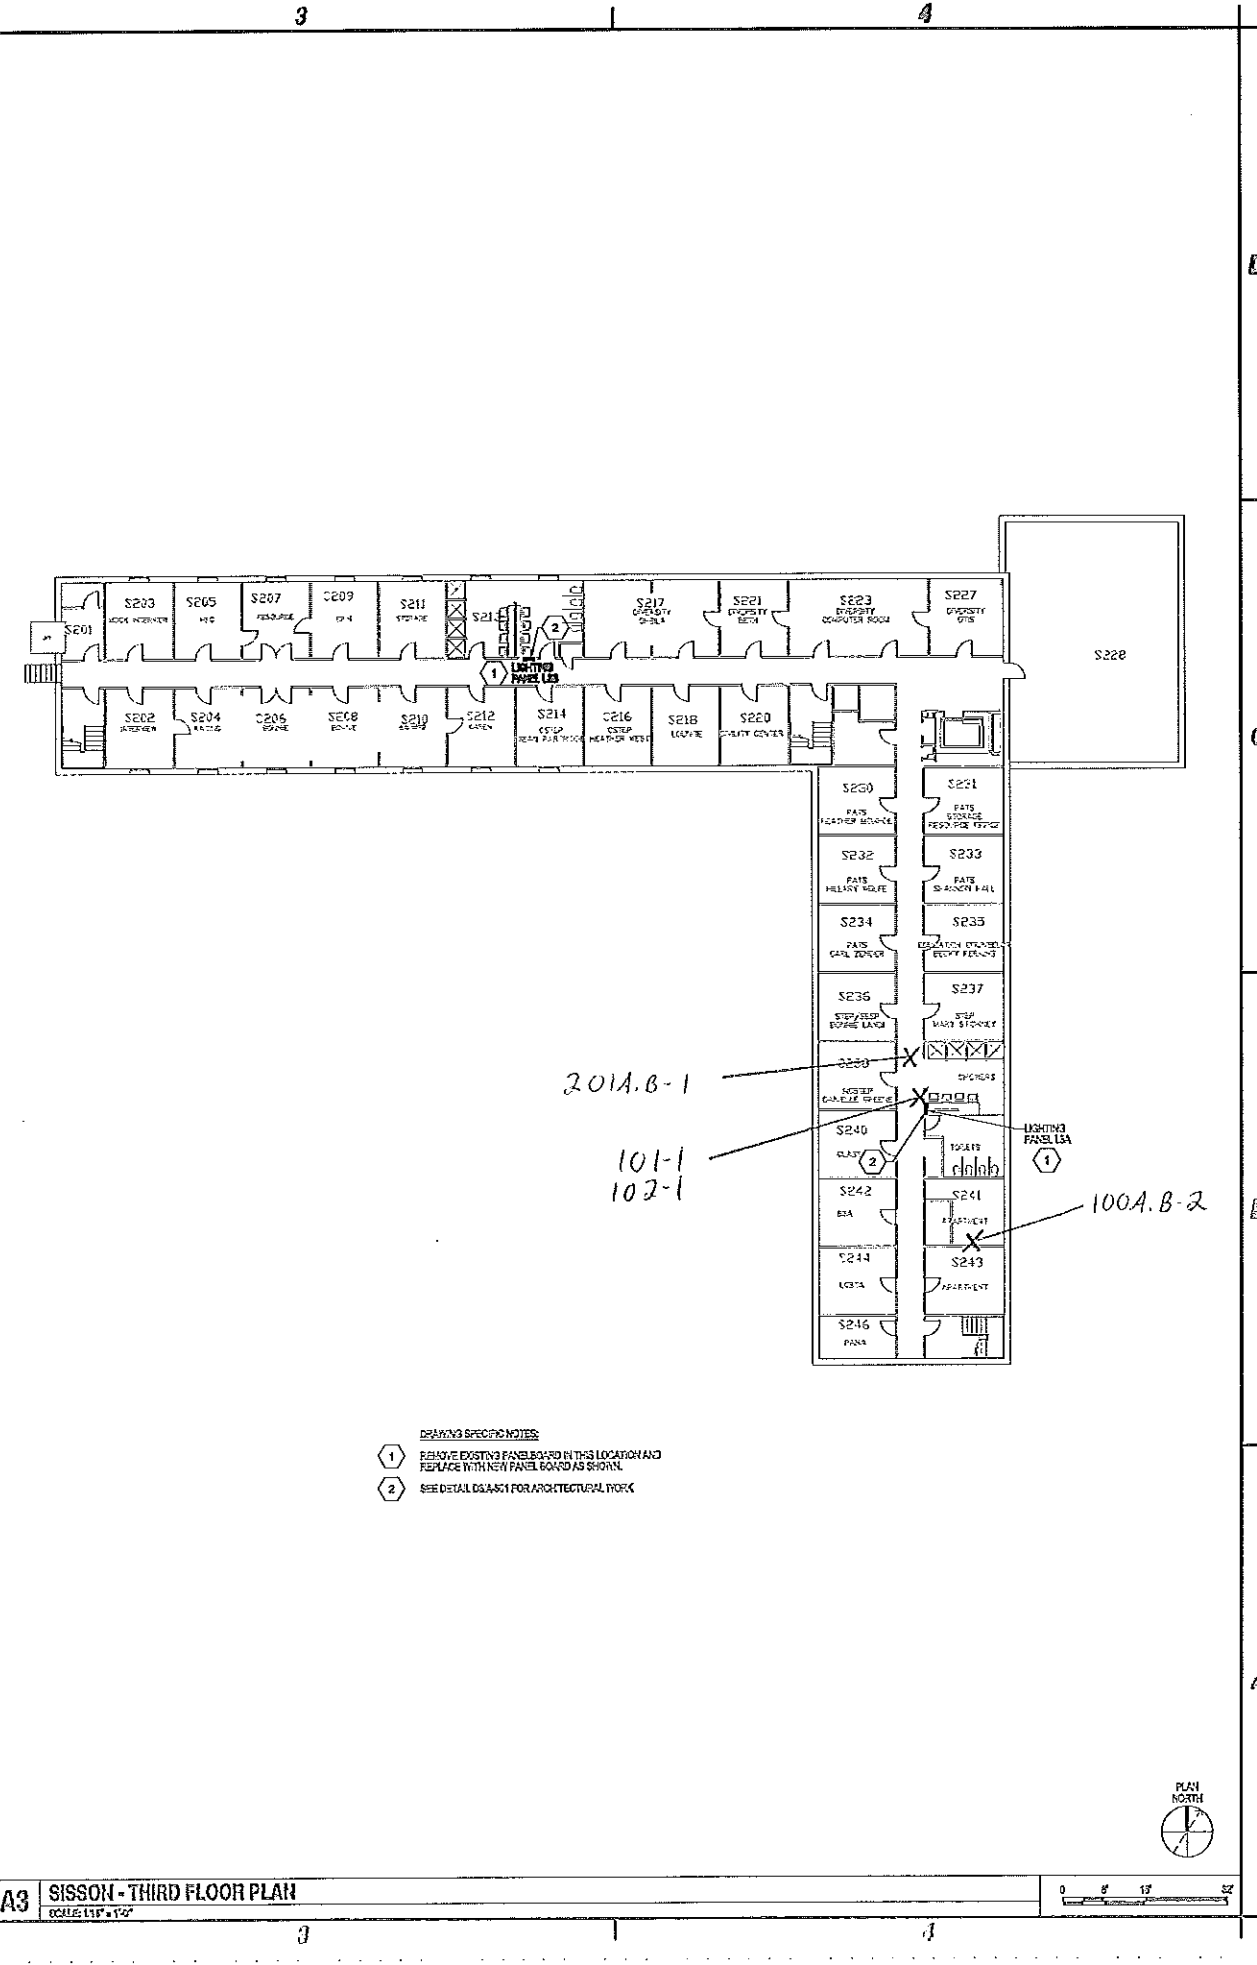

- DRAWING SPECIFIC NOTES**
- ① REMOVE EXISTING PANEL BOARD IN THIS LOCATION AND REPLACE WITH NEW PANEL BOARD AS SHOWN.
  - ② SEE DETAIL 02A-511 FOR ARCHITECTURAL WORK.

**A1 SISSON - SECOND FLOOR PLAN**  
 SCALE: 1/8" = 1'-0"


**A3 SISSON - THIRD FLOOR PLAN**  
 SCALE: 1/8" = 1'-0"

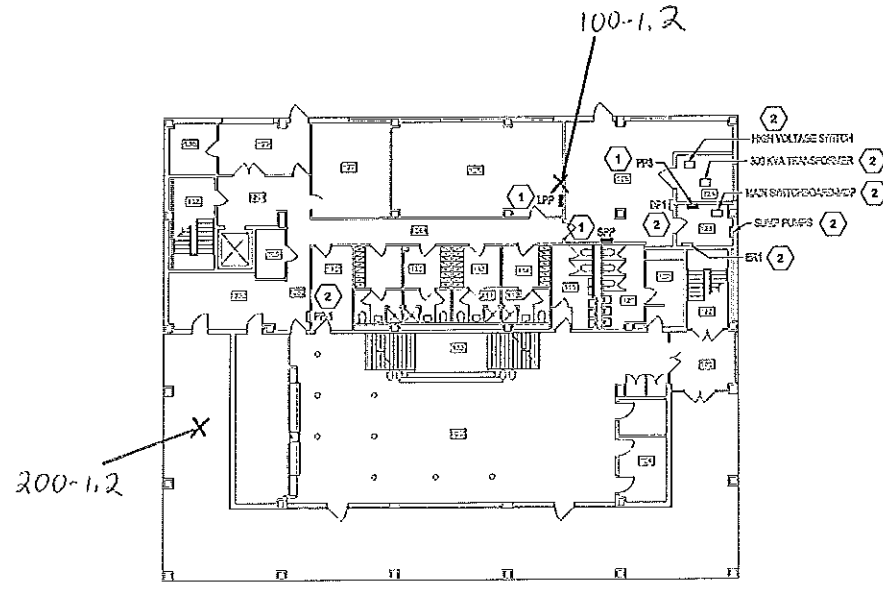

- EXISTING SPECIFIC NOTES:
- 1 REMOVE EXISTING PANEL BOARD IN THIS LOCATION AND REPLACE WITH NEW PANEL BOARD AS SHOWN.
  - 2 REMAINS.



A1 THATCHER - FIRST FLOOR PLAN  
SCALE: 1/8" = 1'-0"

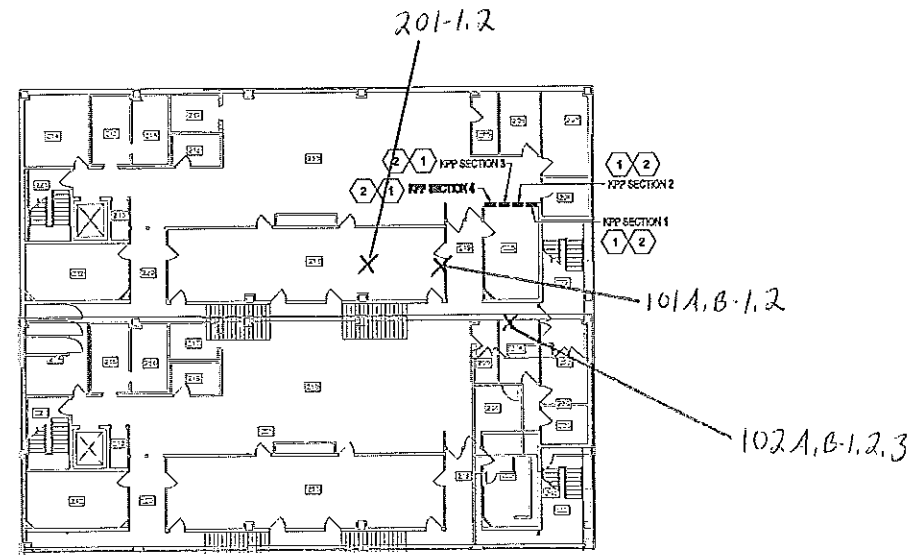

- DESIGN SPECIFIC NOTES:
- 1 REMOVE EXISTING PANEL BOARD IN THIS LOCATION AND REPLACE WITH NEW PANEL BOARD AS SHOWN.
  - 2 SEE DETAIL DCAS/1 FOR ARCHITECTURAL WORK.



A3 THATCHER - SECOND FLOOR PLAN  
SCALE: 1/8" = 1'-0"



C&S Engineers, Inc.  
499 Col. Elson Collins Blvd.  
Syosset, New York 11791  
Phone: 315-455-2000  
Fax: 315-455-9687  
www.cscos.com




STATE UNIVERSITY CONSTRUCTION FUND  
SUCF PROJECT NO. 12290  
STATE UNIVERSITY OF NEW YORK AT POESDAM  
**PRE-BID SUBMISSION - NOT FOR CONSTRUCTION**  
**UPGRADE ELECTRICAL DISTRIBUTION SYSTEMS**  
VARIOUS BUILDINGS


MARK	DATE	DESCRIPTION
REVISIONS		
PROJECT NO: 191453 (01)		
DATE: DECEMBER 8, 2009		
SCALE: AS SHOWN		
DRAWN BY: P. H. LUJ		
DESIGNED BY: T. C. MIKIEWICZ		
CHECKED BY: J. L. ROSS, P.E.		
NO ALTERATION PERMITTED HEREON EXCEPT AS PROVIDED UNDER SECTION 7209 SUBDIVISION 2 OF THE NEW YORK EDUCATION LAW		

**ELECTRICAL**  
**THATCHER**  
**FIRST & SECOND**  
**FLOOR PLANS**

**E-100-19**

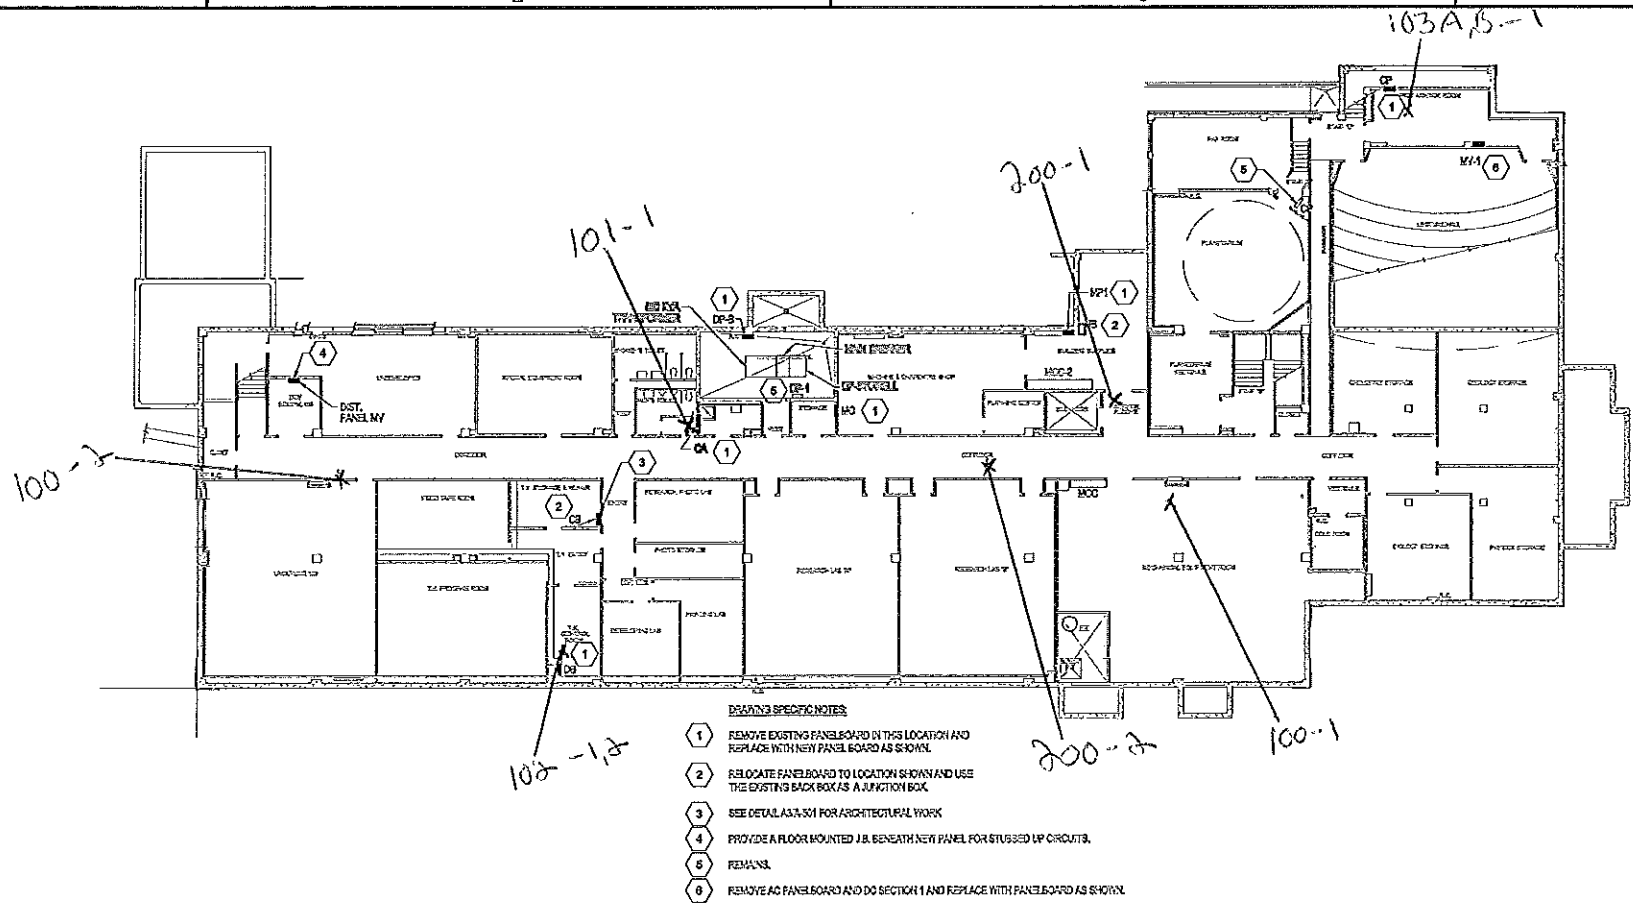


**C1** STOWELL - BASEMENT PLAN  
SCALE: 1/8" = 1'-0"

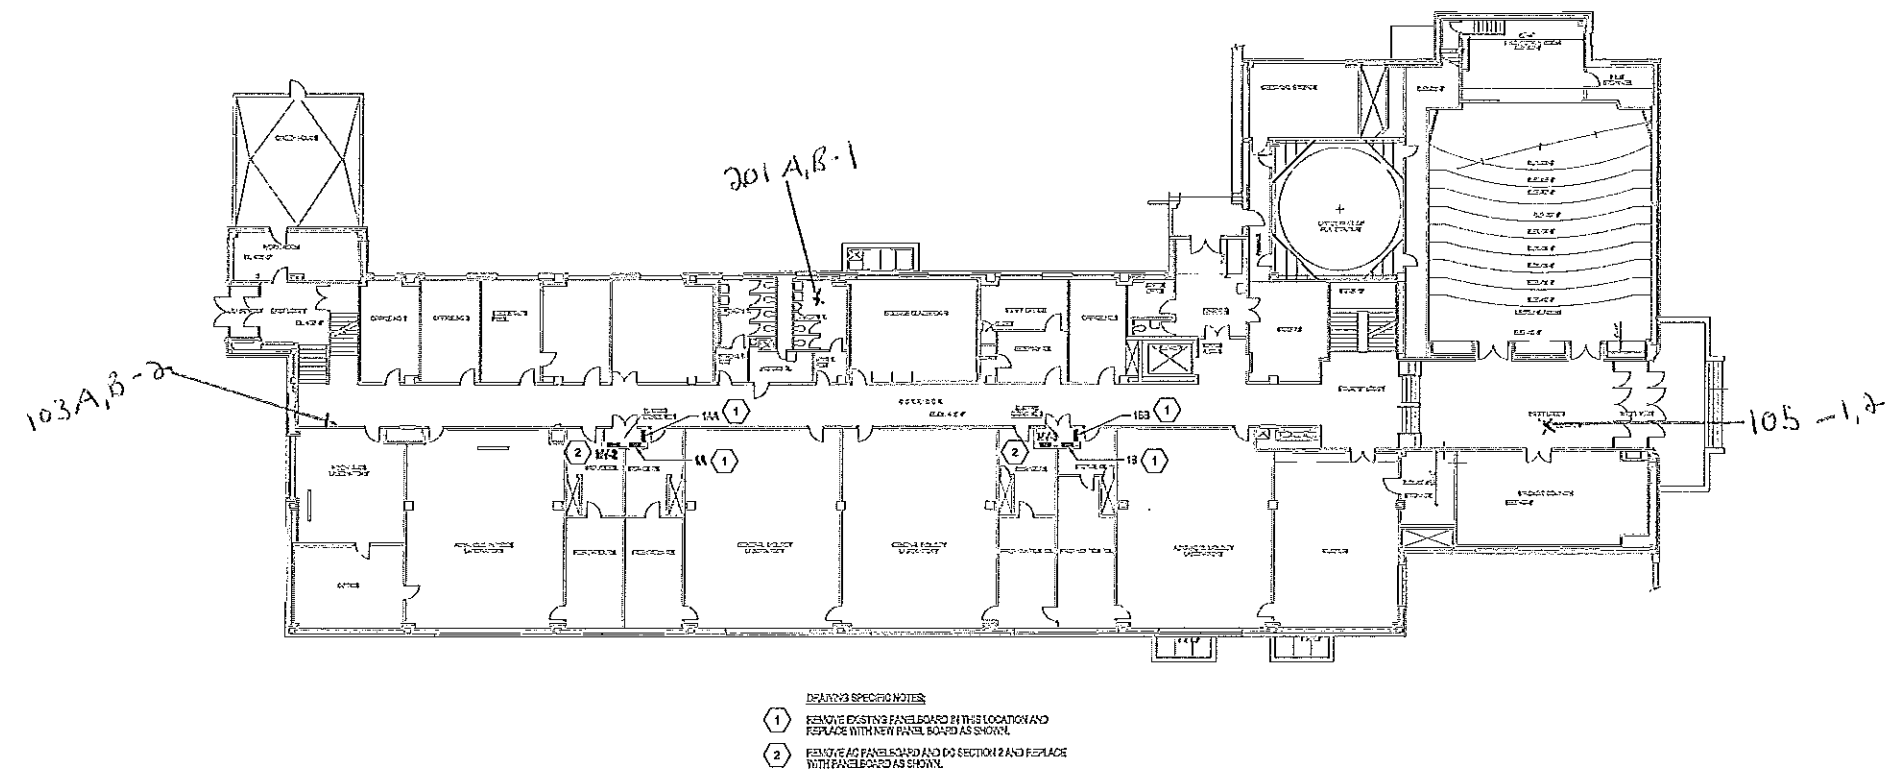

**A1** STOWELL - FIRST FLOOR PLAN  
SCALE: 1/8" = 1'-0"

**C&S COMPANIES**  
C&S Engineers, Inc.  
499 Col. Elson Collins Blvd.  
Syracuse, New York 13212  
Phone: 315-455-2000  
Fax: 315-455-6657  
www.ccsos.com

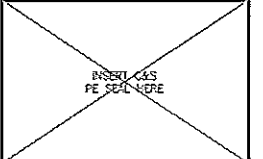

STATE UNIVERSITY CONSTRUCTION FUND  
NEW YORK

STATE UNIVERSITY CONSTRUCTION FUND  
SUCF PROJECT NO. 12290  
STATE UNIVERSITY OF NEW YORK AT POTSDAM  
**PRE-BID SUBMISSION - NOT FOR CONSTRUCTION**  
**UPGRADE ELECTRICAL DISTRIBUTION SYSTEMS**  
**VARIOUS BUILDINGS**

MARK	DATE	DESCRIPTION
REVISIONS		
PROJECT NO:	150.453.001	
DATE:	DECEMBER 5, 2003	
SCALE:	AS SHOWN	
DRAWN BY:	P.H. LUJ	
DESIGNED BY:	T.O. RUIGUEZ	
CHECKED BY:	J.L. ROBBINS, P.E.	



NO ALTERATION PERMITTED HEREON EXCEPT AS PROVIDED UNDER SECTION 7009 SUBSECTION 2 OF THE NEW YORK EDUCATION LAW

**ELECTRICAL**  
**STOWELL**  
**BASEMENT & FIRST FLOOR PLANS**

**E-100-21a**



C&S Engineers, Inc.  
499 Col. Eileen Collins Blvd.  
Syracuse, New York 13212  
Phone: 315-455-2000  
Fax: 315-455-9887  
www.cscos.com

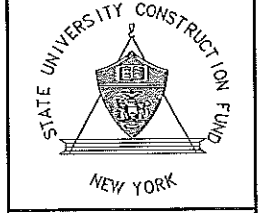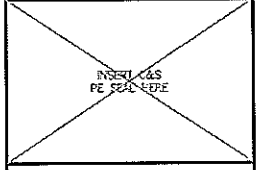


STATE UNIVERSITY CONSTRUCTION FUND  
SUCF PROJECT NO. 12290  
STATE UNIVERSITY OF NEW YORK AT POTSDAM  
PRE-BID SUBMISSION - NOT FOR CONSTRUCTION  
UPGRADE ELECTRICAL DISTRIBUTION SYSTEMS  
VARIOUS BUILDINGS


MARK	DATE	DESCRIPTION
REVISIONS		
PROJECT NO: 199483001		
DATE: DECEMBER 5, 2003		
SCALE: AS SHOWN		
DRAWN BY: P.H.LIU		
DESIGNED BY: T.B. MILKRENOZ		
CHECKED BY: J.L. ROSSINI, P.E.		
NO ALTERATION PERMITTED HEREON EXCEPT AS PROVIDED UNDER SECTION 7209 SUBDIVISION 2 OF THE NEW YORK EDUCATION LAW		

ELECTRICAL  
STOWELL  
SECOND FLOOR  
PLAN

EE-100-21b

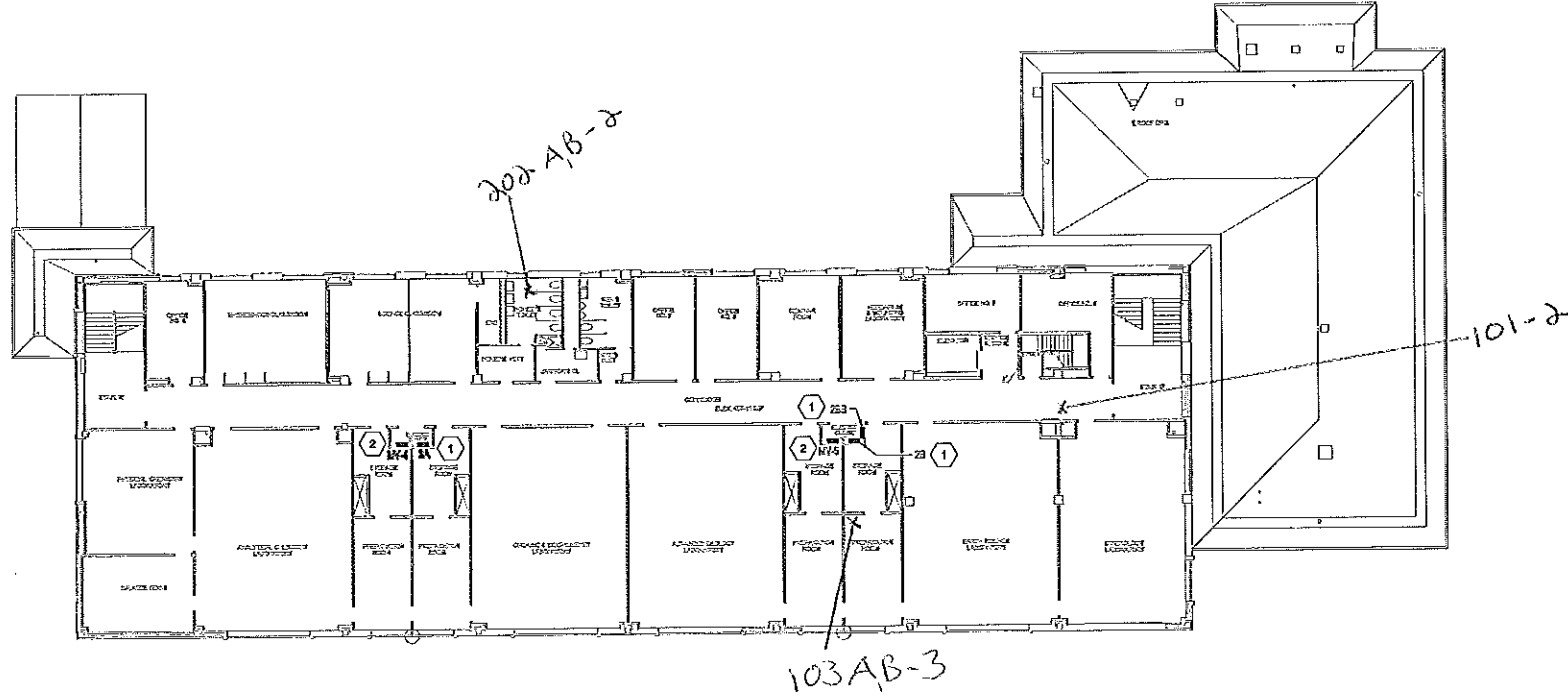

- DRAWING SPECIFIC NOTES:
- ① REMOVE EXISTING PANELBOARD IN THIS LOCATION AND REPLACE WITH NEW PANEL BOARD AS SHOWN.
  - ② REMOVE EXISTING PANELBOARD AND DO SECTION 2 AND REPLACE WITH PANELBOARDS AS SHOWN.

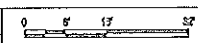


A1 STOWELL - SECOND FLOOR PLAN  
SCALE: 1/8" = 1'-0"

APR 19, 2004 - 02:27PM  
 PROJECT: STOWELL - SECOND FLOOR PLAN  
 DRAWN BY: P.H.LIU  
 CHECKED BY: J.L. ROSSINI, P.E.  
 DESIGNED BY: T.B. MILKRENOZ  
 PROJECT NO: 199483001  
 DATE: DECEMBER 5, 2003  
 SCALE: AS SHOWN  
 NO ALTERATION PERMITTED HEREON EXCEPT AS PROVIDED UNDER SECTION 7209 SUBDIVISION 2 OF THE NEW YORK EDUCATION LAW



**C&S Engineers, Inc.**  
 499 Col. Elson Collins Blvd.  
 Syracuse, New York 13212  
 Phone: 315-455-2000  
 Fax: 315-455-9687  
 www.cscos.com

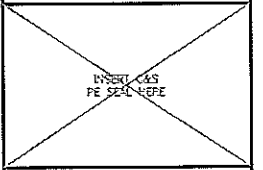



STATE UNIVERSITY CONSTRUCTION FUND  
 NEW YORK

STATE UNIVERSITY CONSTRUCTION FUND  
 SUCF PROJECT NO. 12290  
 STATE UNIVERSITY OF NEW YORK AT POITSDAM  
 PRE-BID SUBMISSION - NOT FOR CONSTRUCTION  
 UPGRADE ELECTRICAL DISTRIBUTION SYSTEMS  
 VARIOUS BUILDINGS



MARK	DATE	DESCRIPTION
REVISIONS		
PROJECT NO: 190453.001		
DATE: DECEMBER 8, 2003		
SCALE: AS SHOWN		
DRAWN BY: P.N. LIU		
DESIGNED BY: T.O. KLUKIEWICZ		
CHECKED BY: J.L. ROSSANO, P.E.		
NO ALTERATION PERMITTED HEREON EXCEPT AS PROVIDED UNDER SECTION 7209 SUBDIVISION 2 OF THE NEW YORK EDUCATION LAW		

ELECTRICAL  
**KNOWLES DINING  
 BASEMENT &  
 SECOND FLOOR  
 PLANS**

E-100-22

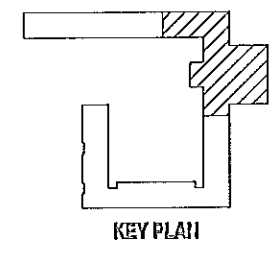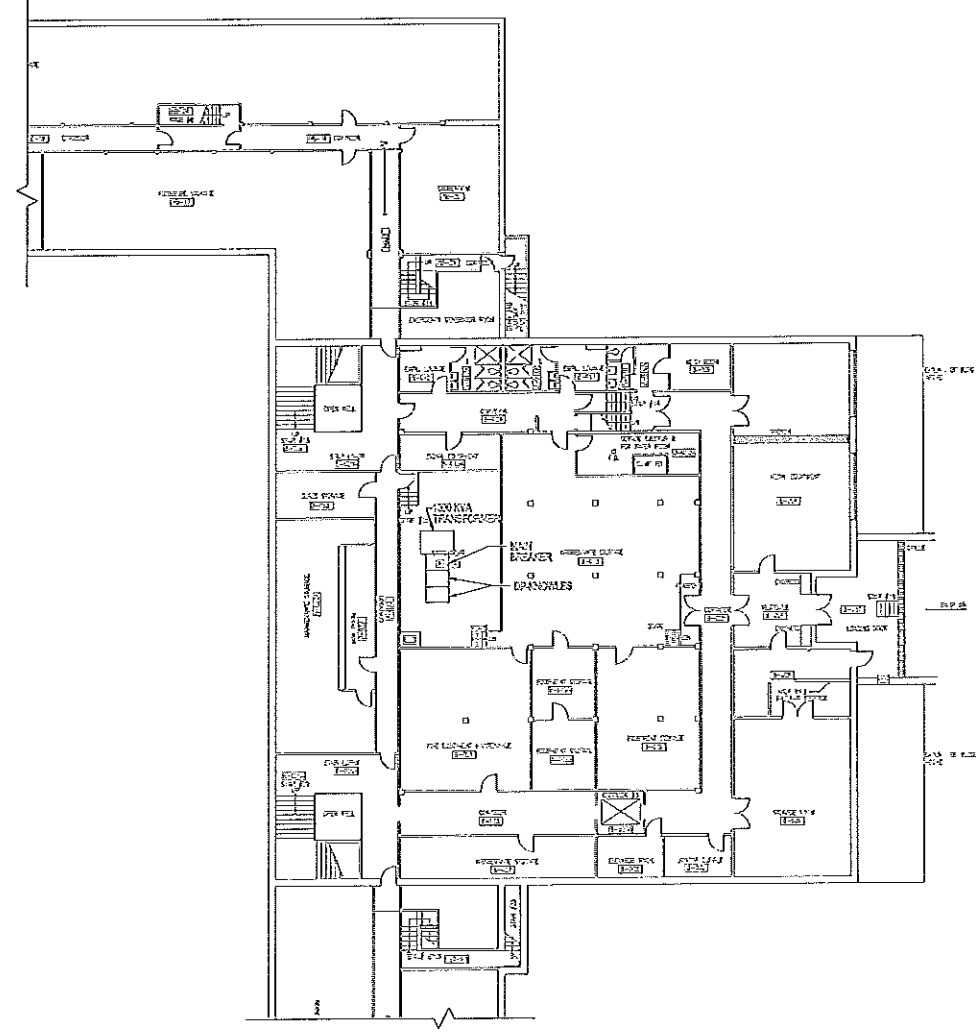

A1 KNOWLES DINING - BASEMENT PLAN  
 SCALE 1/8" = 1'-0"

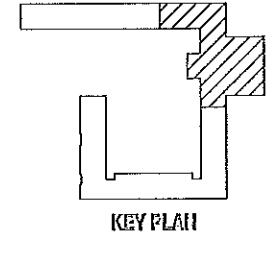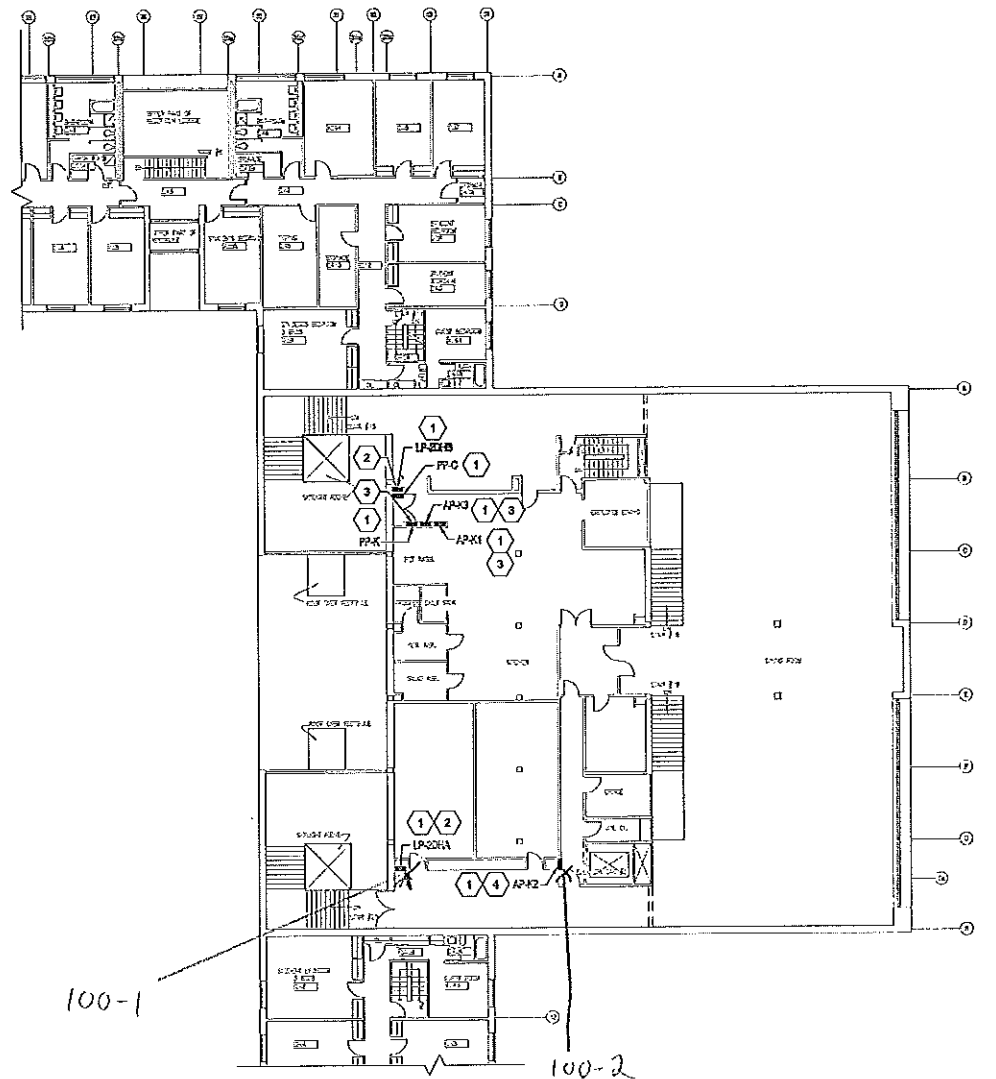


A3 KNOWLES DINING - SECOND FLOOR PLAN  
 SCALE 1/8" = 1'-0"

- DRAWING SPECIFIC NOTES:**
- 1 REMOVE EXISTING PANELBOARD IN THIS LOCATION AND REPLACE WITH NEW PANEL BOARD AS SHOWN.
  - 2 SEE DETAIL CSA-501 FOR ARCHITECTURAL WORK.
  - 3 SEE DETAIL DSA-501 FOR ARCHITECTURAL WORK.
  - 4 SEE DETAIL A2A-501 FOR ARCHITECTURAL WORK.

100-1

100-2

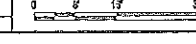



**C&S Engineers, Inc.**  
 499 Col. Eileen Collins Blvd.  
 Syracuse, New York 13212  
 Phone: 315-455-2000  
 Fax: 315-455-9667  
 www.cscos.com



**STATE UNIVERSITY CONSTRUCTION FUND**  
 SUCF PROJECT NO. 12290  
 STATE UNIVERSITY OF NEW YORK AT POTSDAM  
**PRE-BID SUBMISSION - NOT FOR CONSTRUCTION**  
**UPGRADE ELECTRICAL DISTRIBUTION SYSTEMS**  
 VARIOUS BUILDINGS


NO.	DATE	DESCRIPTION

PROJECT NO: 150433.001  
 DATE: DECEMBER 8, 2008  
 SCALE: AS SHOWN  
 DRAWN BY: P.N. LIJ  
 DESIGNED BY: T.D. RUKENHIZ  
 CHECKED BY: J.L. ROSEN, P.E.


NO ALTERATION PERMITTED HEREON  
 EXCEPT AS PROVIDED UNDER SECTION  
 7209 SUBDIVISION 2 OF THE NEW YORK  
 EDUCATION LAW

**ELECTRICAL**  
**MAINTENANCE CENTER**  
**FIRST FLOOR PLAN**

**E-100-24**

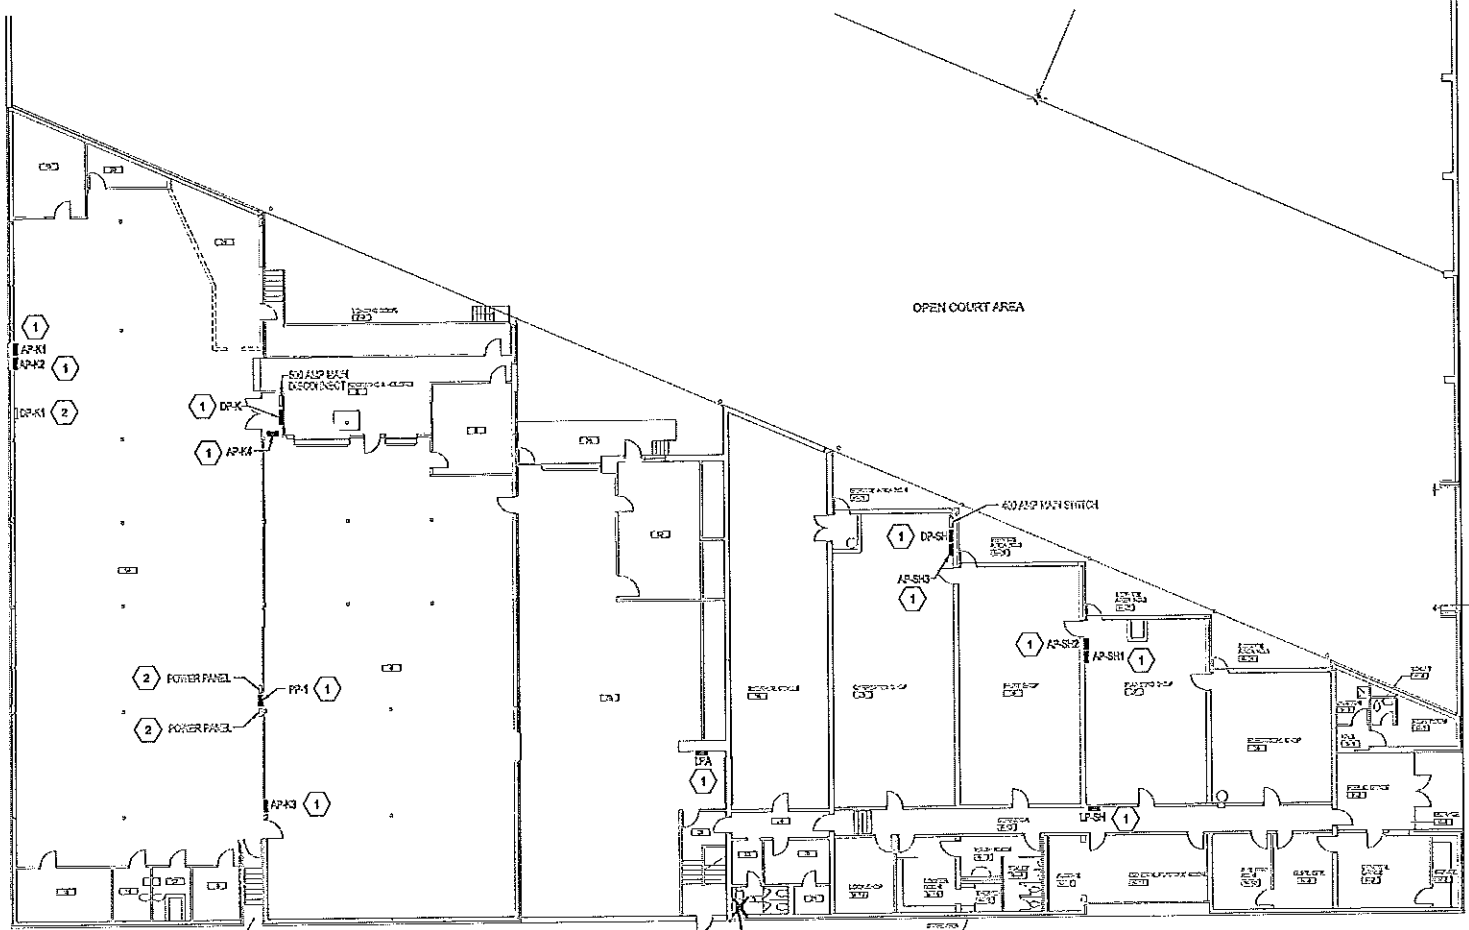

- DRAWING SPECIFIC NOTES:**
- 1 REMOVE EXISTING PANELS IN THIS LOCATION AND REPLACE WITH NEW PANEL BOARD AS SHOWN.
  - 2 REMAINS.

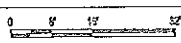

**A1 MAINTENANCE PLANT - FIRST FLOOR PLAN**  
 SCALE: 1/8" = 1'-0"

JUN 19, 2008 4:51:26 PM  
 P:\Projects\100-24\100-24.dwg  
 PLOT: 100-24-24.dwg



www.bergmannpc.com

28 East Main Street  
200 First Federal Plaza  
Rochester, New York 14614  
585.232.5135 / 585.232.4652 fax

Engineers / Architects / Planners / Surveyors

REVISIONS				
NO.	DATE	DESCRIPTION	REV.	CKD.

**PRE-BID  
SUBMISSION**


NOTE:  
Unauthorized alteration or addition to this drawing is a  
violation of the New York State Education Law Article  
145, Section 7209.

**BRAINERD  
FIRST FLOOR PLAN**

Project Manager	D. PORTER
Designer	D. PORTER
Checker	M. SELLERS
Drawn by	AS ETOED
Scale	
Date	JANUARY 18, 2008

Project Number: 7771.00  
File Name: 2008-01-18-Brainerd-First-Floor-Plan.dwg

ATC100-26

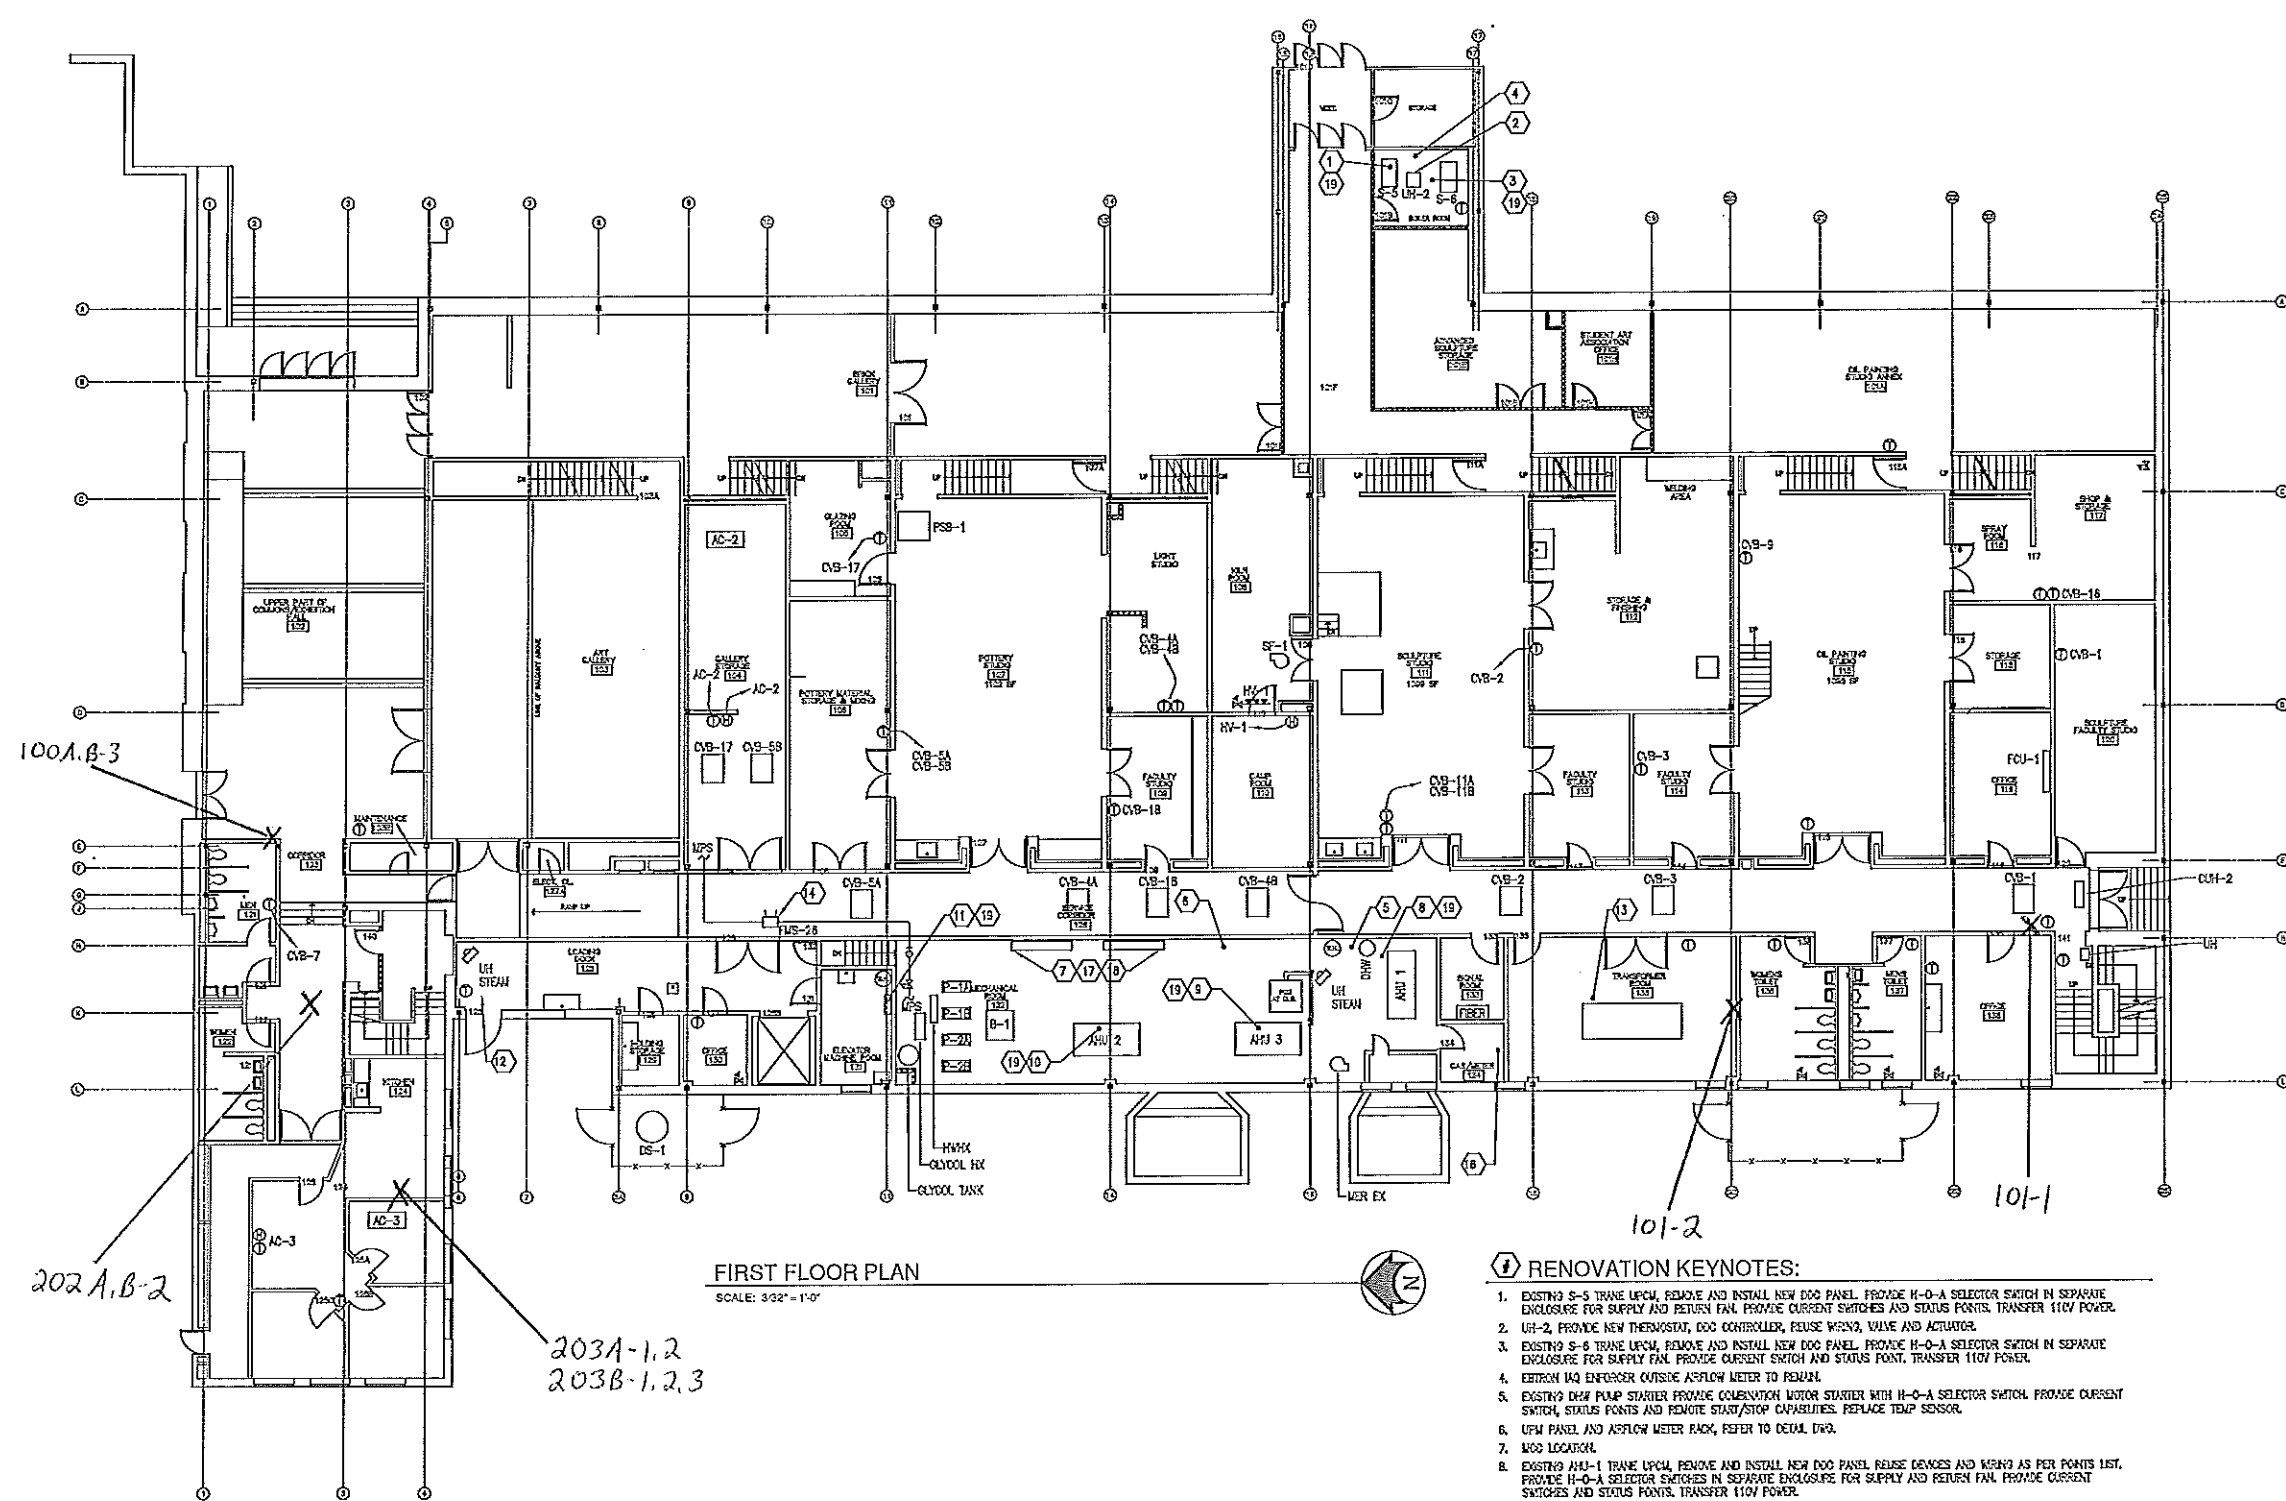

**FIRST FLOOR PLAN**  
SCALE: 3/32" = 1'-0"

**RENOVATION KEYNOTES:**

- EXISTING S-5 TRANE UPFC, REMOVE AND INSTALL NEW DDC PANEL. PROVIDE H-O-A SELECTOR SWITCH IN SEPARATE ENCLOSURE FOR SUPPLY AND RETURN FAN. PROVIDE CURRENT SWITCHES AND STATUS POINTS. TRANSFER 110V POWER.
- UH-2, PROVIDE NEW THERMOSTAT, DDC CONTROLLER, REUSE WIRING, VALVE AND ACTUATOR.
- EXISTING S-6 TRANE UPFC, REMOVE AND INSTALL NEW DDC PANEL. PROVIDE H-O-A SELECTOR SWITCH IN SEPARATE ENCLOSURE FOR SUPPLY FAN. PROVIDE CURRENT SWITCH AND STATUS POINT. TRANSFER 110V POWER.
- EBTRON IQ4 ENFORCER OUTSIDE AIRFLOW METER TO REMAIN.
- EXISTING DHW PUMP STARTER PROVIDE CONVENTION MOTOR STARTER WITH H-O-A SELECTOR SWITCH. PROVIDE CURRENT SWITCH, STATUS POINTS AND REMOTE START/STOP CAPABILITIES. REPLACE TEMP SENSOR.
- UPM PANEL AND AIRFLOW METER PACK, REFER TO DETAIL DWG.
- MSS LOCATION.
- EXISTING AHU-1 TRANE UPFC, REMOVE AND INSTALL NEW DDC PANEL. REUSE DEVICES AND WIRING AS PER POINTS LIST. PROVIDE H-O-A SELECTOR SWITCHES IN SEPARATE ENCLOSURE FOR SUPPLY AND RETURN FAN. PROVIDE CURRENT SWITCHES AND STATUS POINTS. TRANSFER 110V POWER.
- EXISTING AHU-3 TRANE UPFC, REMOVE AND INSTALL NEW DDC PANEL. REUSE DEVICES AND WIRING AS PER POINTS LIST. PROVIDE H-O-A SELECTOR SWITCHES IN SEPARATE ENCLOSURE FOR SUPPLY AND RETURN FAN. PROVIDE CURRENT SWITCHES AND STATUS POINTS. TRANSFER 110V POWER.
- EXISTING AHU-2 TRANE UPFC, REMOVE AND INSTALL NEW DDC PANEL. REUSE DEVICES AND WIRING AS PER POINTS LIST. PROVIDE H-O-A SELECTOR SWITCH IN SEPARATE ENCLOSURE FOR SUPPLY FAN. PROVIDE CURRENT SWITCH AND STATUS POINT. TRANSFER 110V POWER.
- EXISTING DELTA PANEL #3 EXCEL 8000 INCLUDES: BLDG STM PRESSURE, BLDG AIR ALARM, ELEVATOR RM H2O WATER ALARM, FIRE ALARM, FIRE ALARM TROUBLE, LAB AIR ALARM, PHONE CELL STATUS, ROADWAY LINES STATUS, ROADWAY LINES, -- ALL TO REMAIN. PROVIDE 3/4" EMT CONDUIT WITH 2-MULTIMODE FIBER OPTIC CABLES TO FIBER PATCH PANEL.
- REPLACE TEMP SENSOR WITH NEW, REUSE VALVE ACTUATOR, ADJUST.
- EXISTING POWER QUALITY METER. PROVIDE TIE-INS TO DDC PANEL. REFER TO WIRING DIAGRAM #20 ON DRAWING A10-054.
- LOCATION OF NEW STEAM SENSOR FLASER. PROVIDE 3/4" EMT CONDUIT WITH 2-#12 AND 1-#12 GROUND FROM 110V POWER SUPPLY IN KEYNOTE #11.
- PROVIDE CURRENT SWITCH AND START/STOP DELAY FOR BOILER B-1. PROVIDE ALARM WIRING TO DDC PANEL AND CONNECT TO ALARM CONTACT IN BOILER CONTROL BOARD.
- CW METER, REPLACE REGISTER WITH NEW PURSE TYPE. REFER TO METER SCHEDULE.
- PROVIDE CURRENT SWITCHES AND STATUS POINTS FOR P-1A, P-1B, P-2A AND P-2B. PROVIDE H-O-A SELECTOR SWITCHES IN EXISTING VSO'S LOCATED IN MOC. REFER TO POINTS LIST FOR QUANTITIES.
- RECONNECT WIRING FOR EXHAUST FANS LOCATED IN MOC. REFER TO POINTS LIST FOR QUANTITIES.
- PROVIDE 3/4" EMT CONDUIT WITH 1-#22 UTP TO INDIVIDUAL CONTROL PANELS.
- FIELD VERIFY LOCATION OF SUPPLY FAN S-8. PROVIDE H-O-A SELECTOR SWITCH IN SEPARATE ENCLOSURE. PROVIDE CURRENT SWITCH AND STATUS POINTS AS PER POINTS LIST.
- FIELD VERIFY THE LOCATION OF THE FOLLOWING EQUIPMENT: AC-1, AC-2, CORRIDOR CHU, UH-101B, FAN COOL 1, UH-102, UH-103, UH-104 AND SUPPLY FAN SF1. REPLACE DEVICES ON POINTS LIST AND TRANSFER WIRING.

**GENERAL NOTES:**

- EXISTING SENSORS ARE NOT COMPATIBLE WITH NEW DDC, REPLACE ALL SENSORS WITH NEW REUSE WIRING UNLESS OTHERWISE INDICATED. VERIFY INTEGRITY OF WIRING BEFORE REUSE. SENSOR LOCATIONS SHOWN BASED ON AS-BUILT DRAWINGS, ACTUAL LOCATION MAY VARY SLIGHTLY.
- EXISTING POINT UPM POINT ID'S ARE BASED ON AS BUILT DRAWINGS. FIELD VERIFICATION HAS SHOWN MOST TO BE ACCURATE HOWEVER APPROXIMATELY 10% WERE FOUND TO BE TEMPORARY LOCATIONS. EACH POINT WILL REQUIRE VERIFICATION PRIOR TO REUSE. ADVISE IF DEVICE IS NON-REUSEABLE OR WIRING CANNOT BE REUSED.

100A.B-3

202A.B-2

203A-1.2  
203B-1.2,3

**S.U.C.F. PROJECT  
NO. 12294**  
**UPGRADE ENERGY  
MANAGEMENT SYSTEMS -  
VARIOUS BUILDINGS**  
The State University  
of New York at Potsdam  
Potsdam, New York

**STATE UNIVERSITY  
CONSTRUCTION  
FUND**  
STATE UNIVERSITY PLAZA  
353 BROADWAY  
ALBANY, NY 12246



www.bergmannpc.com  
20 East Main Street  
200 First Federal Plaza  
Rochester, New York 14614  
585.232.5135 / 585.232.4652 fax  
Engineers / Architects / Planners / Surveyors

REVISIONS				
NO.	DATE	DESCRIPTION	REV.	CKD.

**PRE-BID  
SUBMISSION**


NOTE:  
Unauthorized alteration or addition to this drawing is a  
violation of the New York State Education Law Article  
145, Section 7209.

**BRAINERD  
SECOND FLOOR PLAN**

Project Manager	D. PORTER
Designer	D. PORTER
Drawn by	M. ELLER
Checked by	
Scale	AS NOTED

Project Number: 7771.00  
Drawing Number: ATC101-26

**ATC101-26**

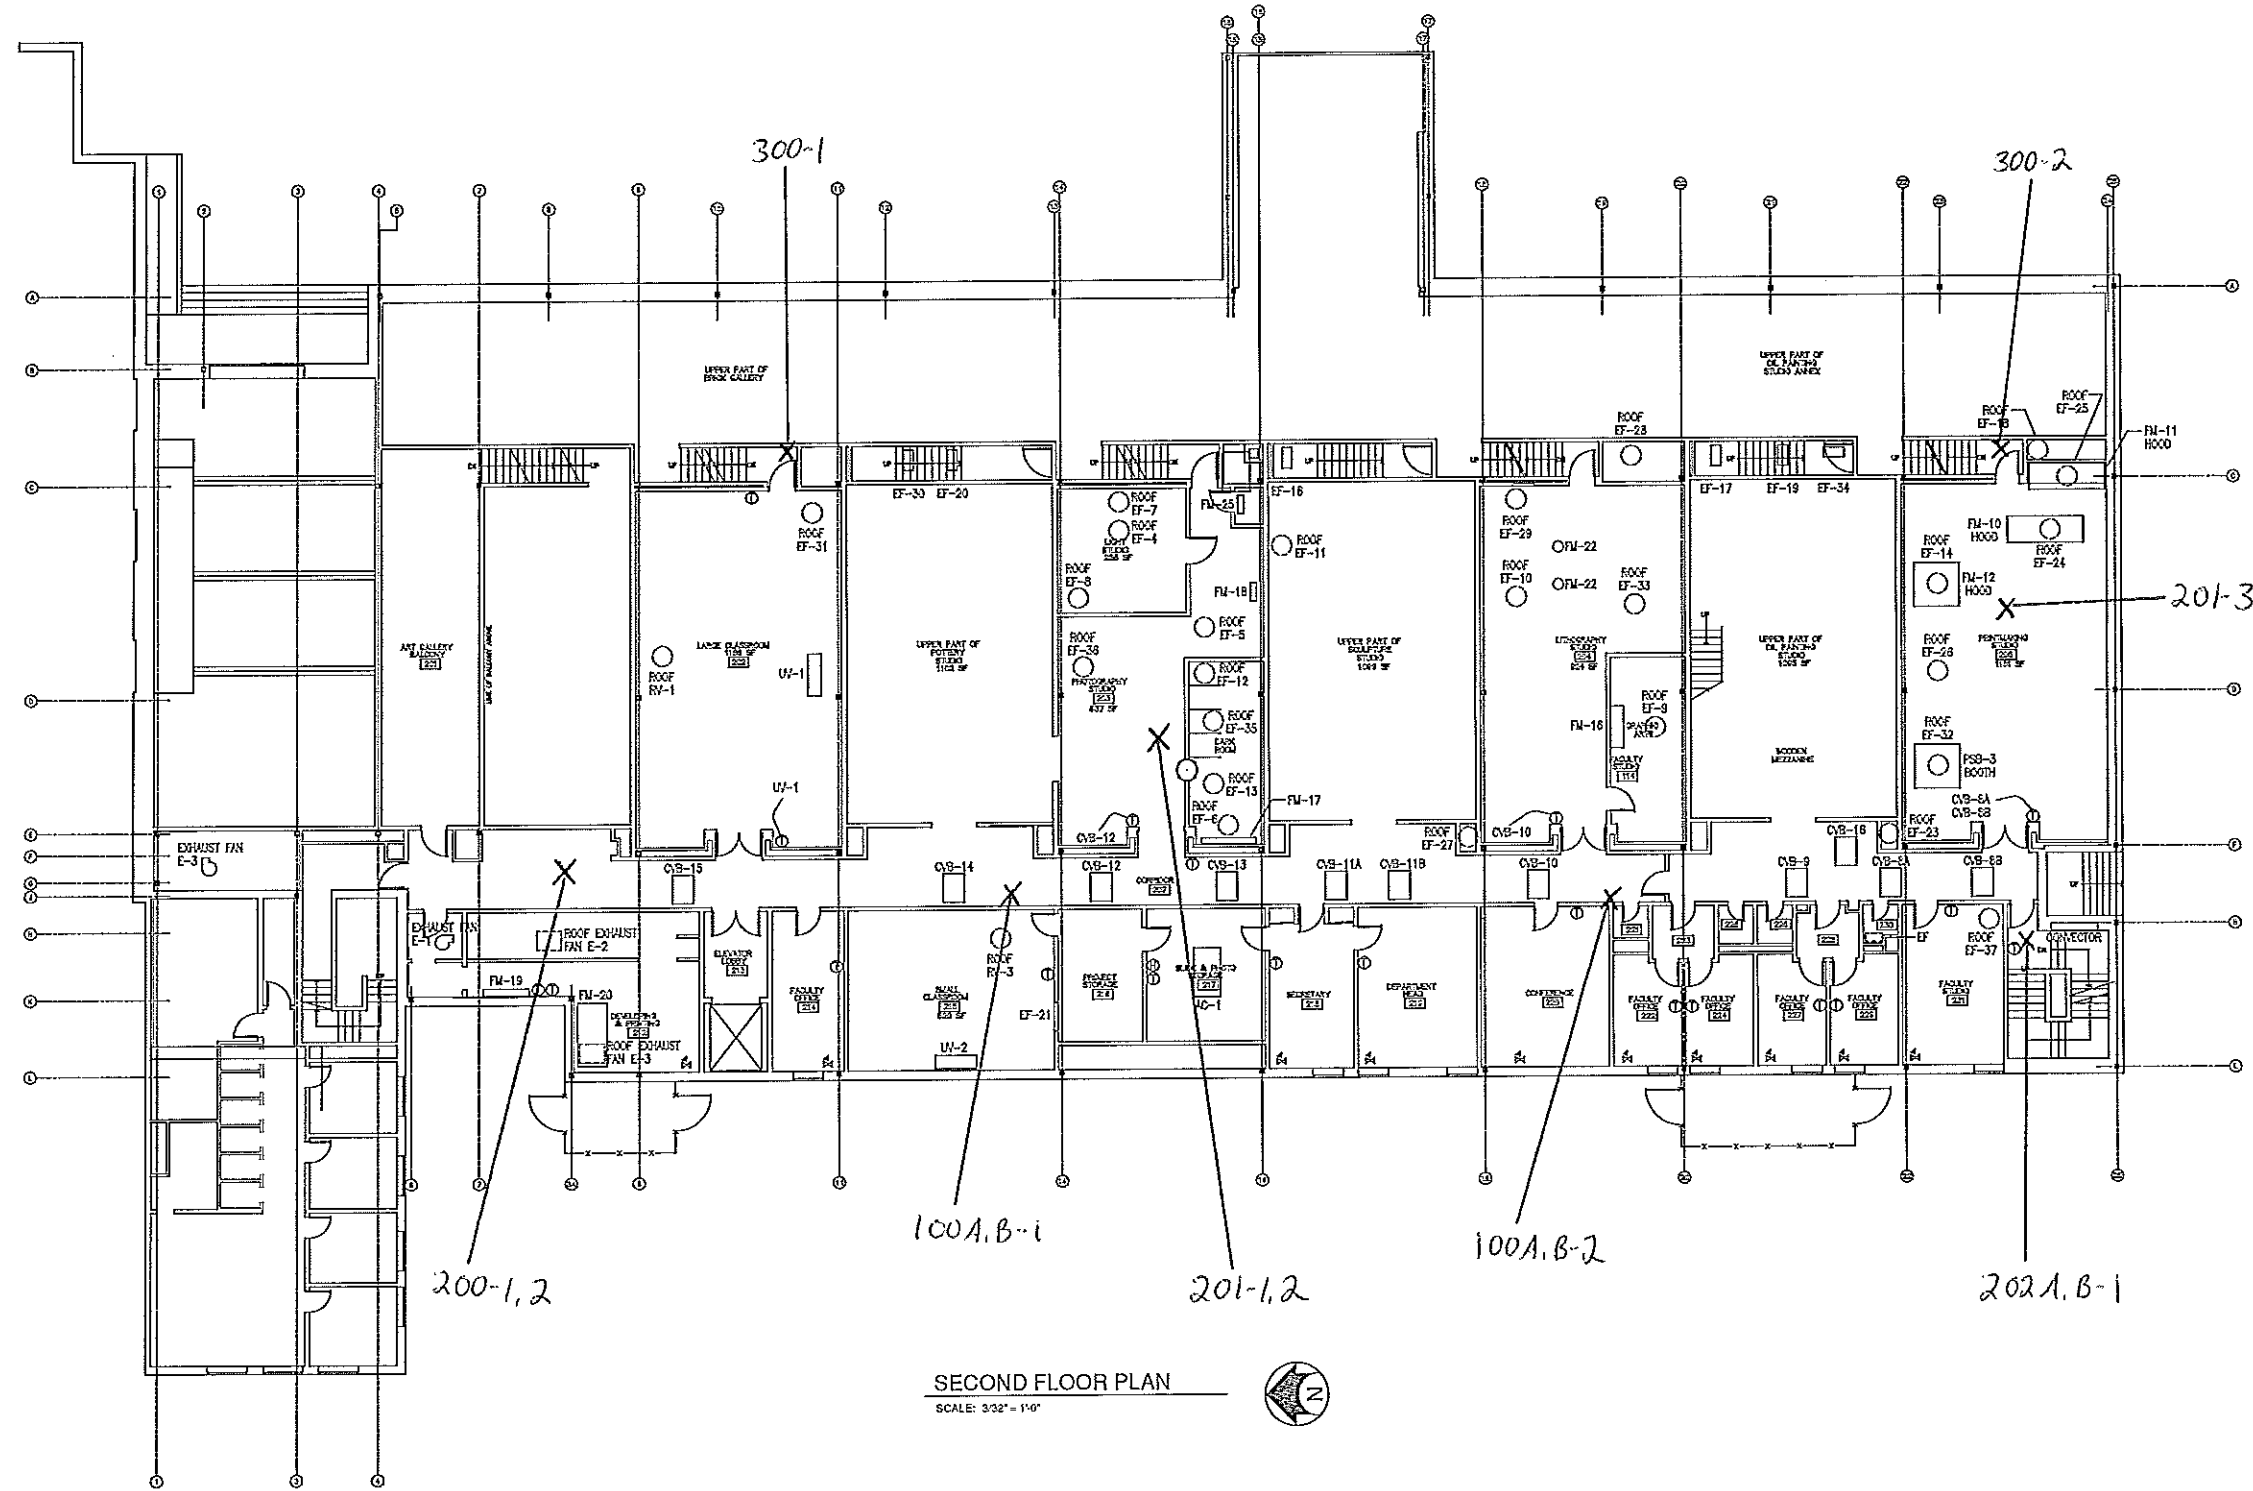


**SECOND FLOOR PLAN**  
SCALE: 3/32" = 1'-0"

- GENERAL NOTES:**
- EXISTING SENSORS ARE NOT COMPARABLE WITH NEW DDC, REPLACE ALL SENSORS WITH NEW, PLEASE VERIFY SENSORS UNLESS OTHERWISE INDICATED. VERIFY INTEGRITY OF WIRING BEFORE REUSE. SENSOR LOCATIONS SHOWN BASED ON AS-BUILT DRAWINGS, ACTUAL LOCATION MAY VARY SLIGHTLY.
  - EXISTING POINT UFM POINT ID'S ARE BASED ON AS BUILT DRAWINGS. FIELD VERIFICATION HAS SHOWN MOST TO BE ACCURATE HOWEVER APPROXIMATELY 10% WERE FOUND TO BE IMPRECISE LOCATIONS. EACH POINT WILL REQUIRE VERIFICATION PRIOR TO REUSE. ADVISE IF REUSE IS NECESSARY OR WIRING CANNOT BE REUSED.


- RENOVATION KEYNOTES:**
- PROVIDE



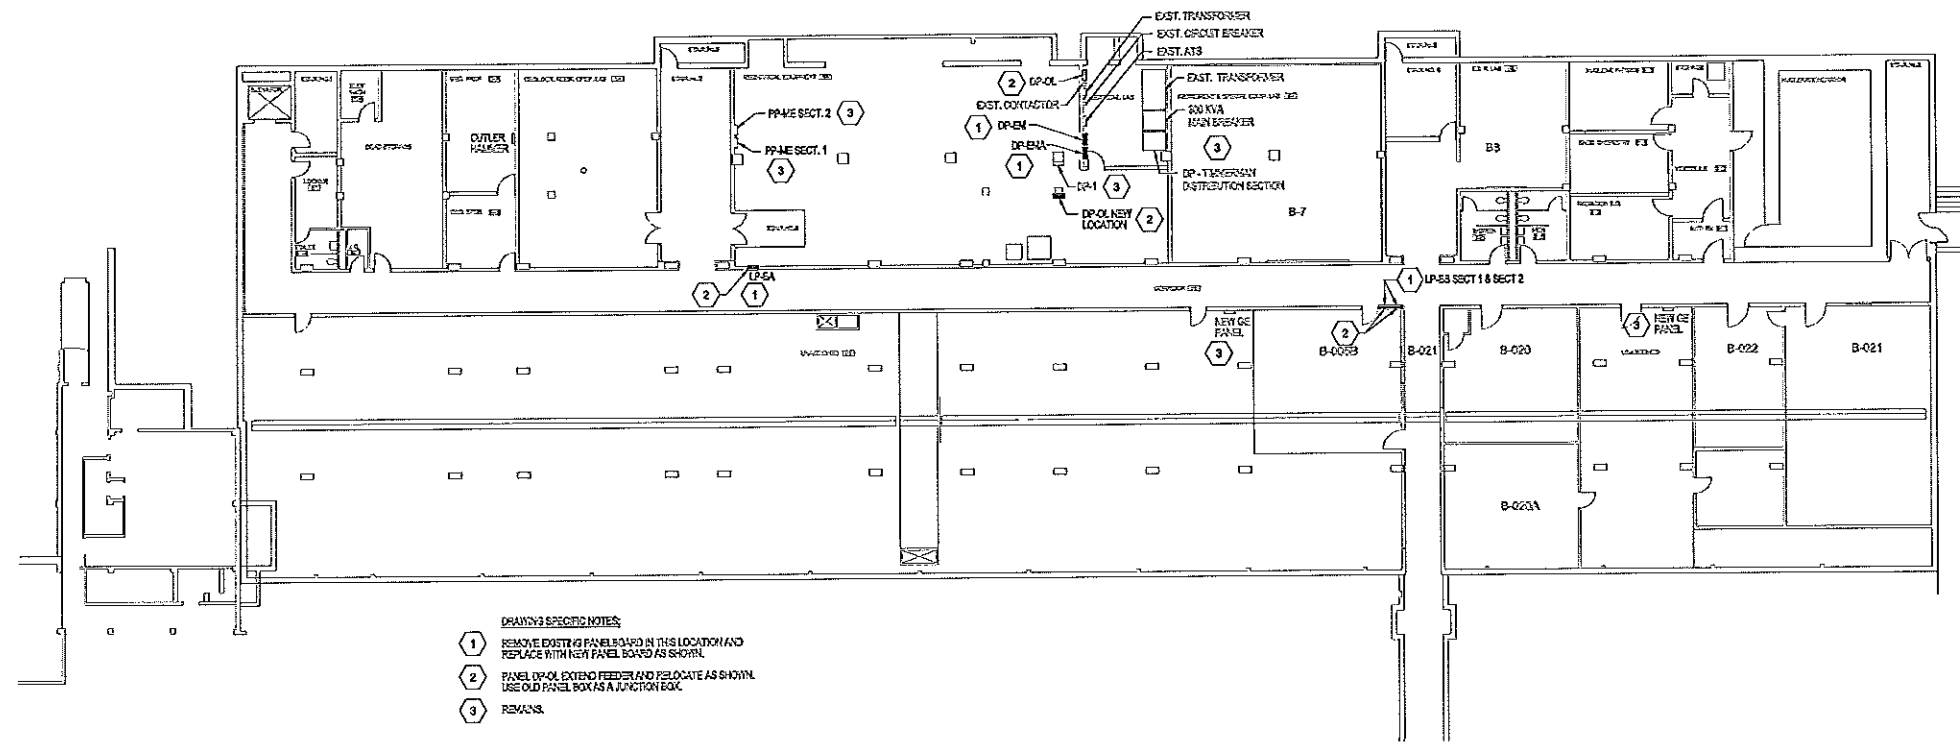

- DRAWING SPECIFIC NOTES:**
- 1 REMOVE EXISTING PANELBOARD IN THIS LOCATION AND REPLACE WITH NEW PANEL BOARD AS SHOWN.
  - 2 PANEL UP-OL EXTEND FEEDER AND RELOCATE AS SHOWN. USE OLD PANEL BOX AS A JUNCTION BOX.
  - 3 REMOVE.

**C1** **TIMMERMAN - BASEMENT PLAN**  
SCALE: 1/4" = 1'-0"

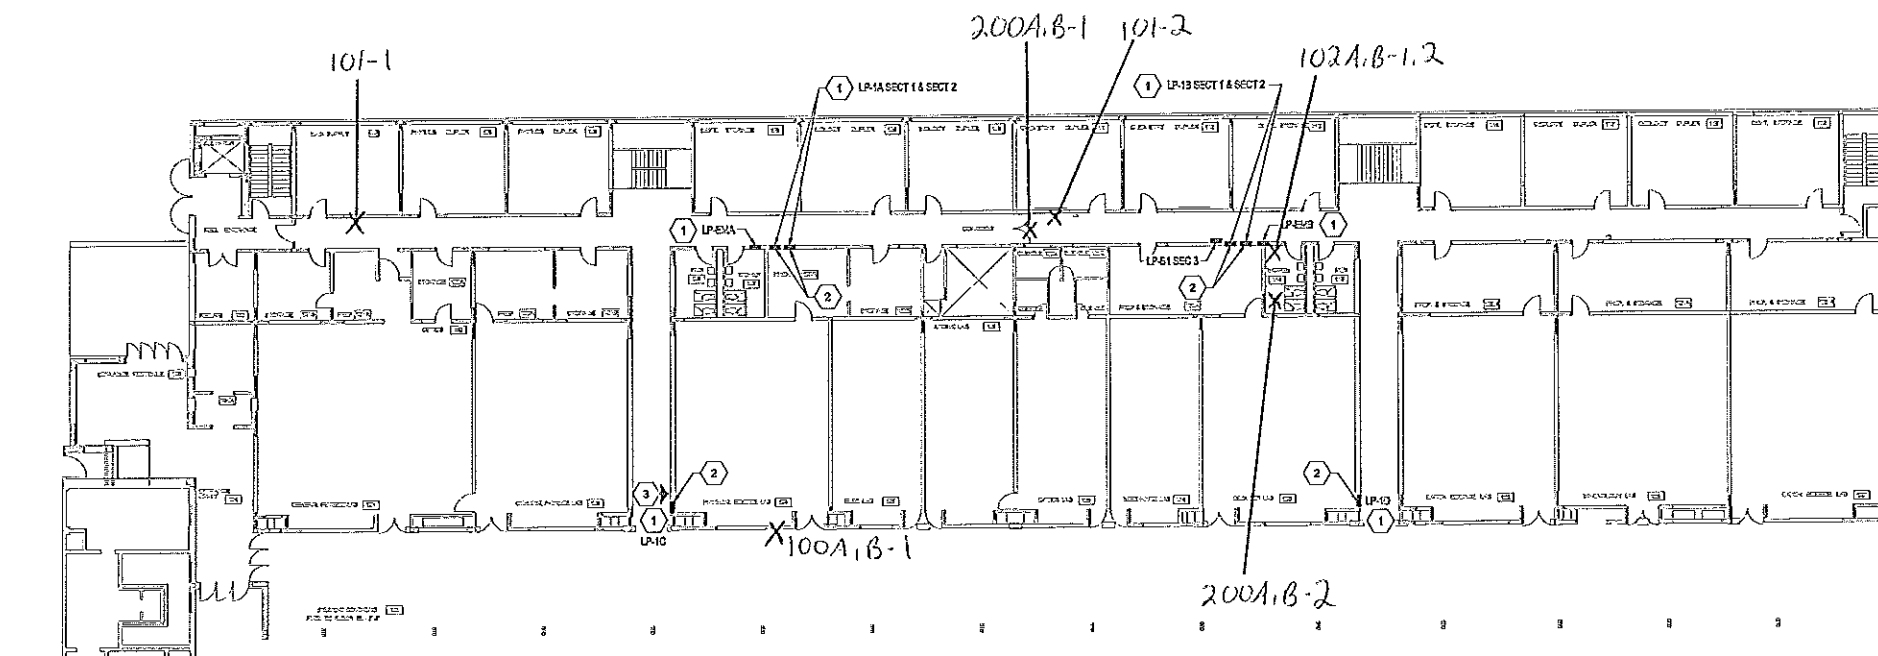


- DRAWING SPECIFIC NOTES:**
- 1 REMOVE EXISTING PANELBOARD IN THIS LOCATION AND REPLACE WITH NEW PANEL BOARD AS SHOWN.
  - 2 SEE DETAIL 04-1511 FOR ARCHITECTURAL WORK.
  - 3 SEE PHOTO B1.A.5/1

**A1** **TIMMERMAN - FIRST FLOOR PLAN**  
SCALE: 1/4" = 1'-0"



**C&S Engineers, Inc.**  
499 Col. Elken Collins Blvd.  
Syosset, New York 11212  
Phone: 315-455-2000  
Fax: 315-455-6687  
www.ccsos.com

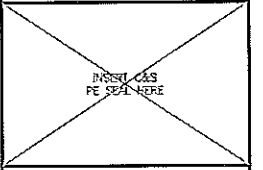


**STATE UNIVERSITY CONSTRUCTION FUND**  
SUCF PROJECT NO. 12290  
STATE UNIVERSITY OF NEW YORK AT POITSDAM  
PRE-BID SUBMISSION - NOT FOR CONSTRUCTION  
UPGRADE ELECTRICAL DISTRIBUTION SYSTEMS  
VARIOUS BUILDINGS

MARK	DATE	DESCRIPTION
REVISIONS		
		PROJECT NO: 194433001
		DATE: DECEMBER 5, 2008
		SCALE: AS SHOWN
		DRAWN BY: P.H. LUJ
		DESIGNED BY: T.G. KLUKIEWICZ
		CHECKED BY: J.L. ROBBINS, P.E.
NO ALTERATION PERMITTED HEREON EXCEPT AS PROVIDED UNDER SECTION 7209 SUBDIVISION 2 OF THE NEW YORK EDUCATION LAW		

**ELECTRICAL**

**TIMMERMAN  
BASEMENT & FIRST  
FLOOR PLANS**

**E-100-27a**

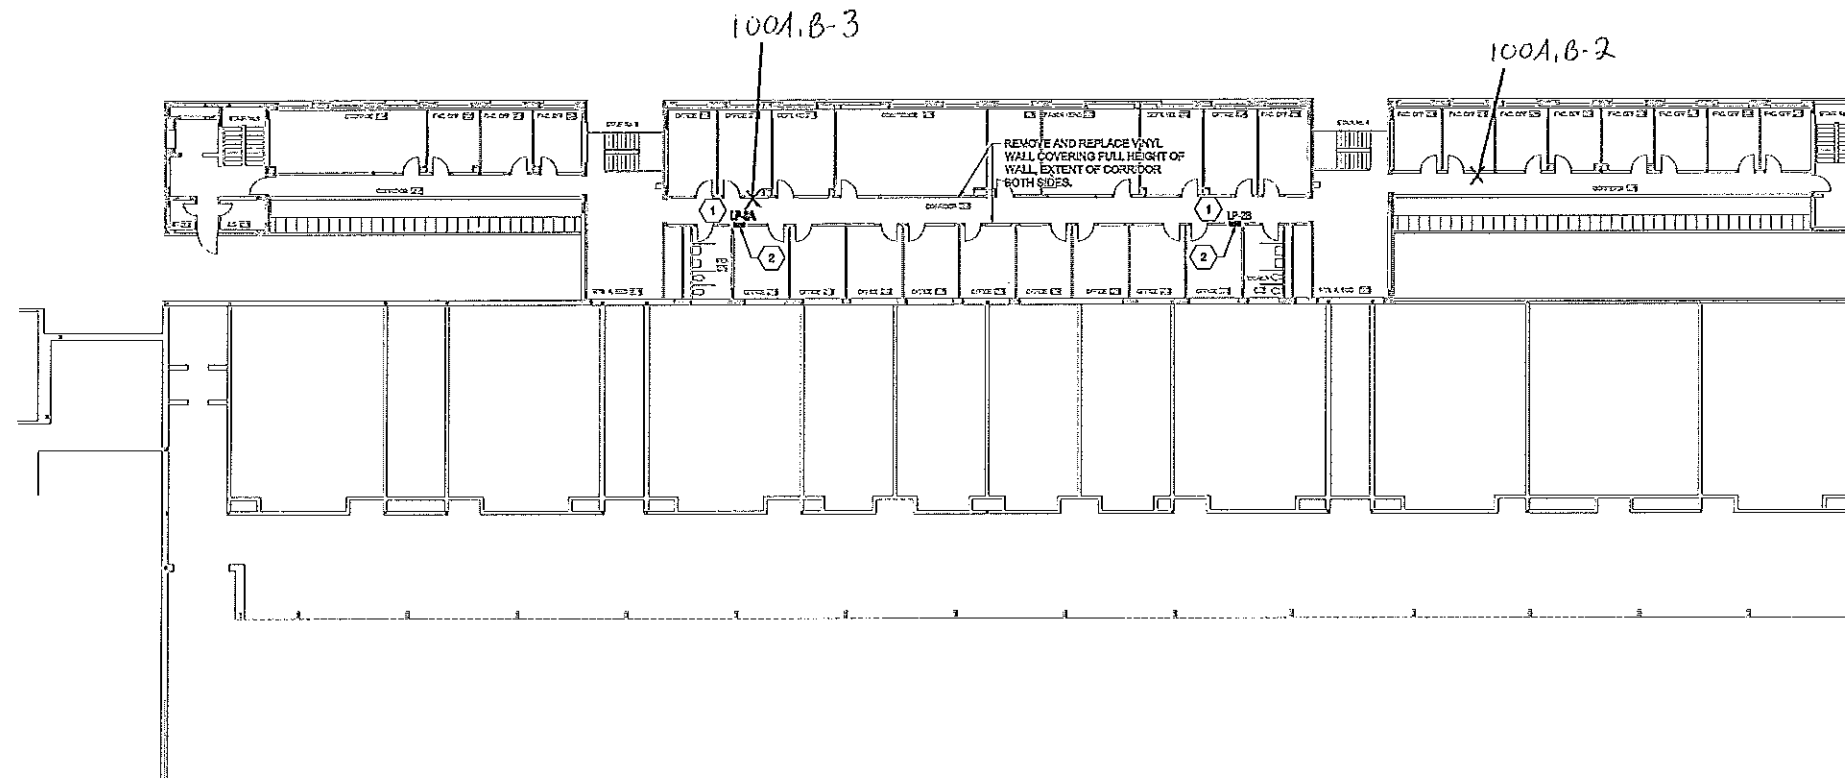

- DRAWING SPECIFIC NOTES:**
- 1 REMOVE EXISTING PANEL BOARDS IN THIS LOCATION AND REPLACE WITH NEW PANEL BOARDS AS SHOWN.
  - 2 SEE DETAIL E22-A-S11 FOR ARCHITECTURAL WORK.


**A1** TIMMERMAN - SECOND FLOOR PLAN  
SCALE: 1/8" = 1'-0"



0 8 16 32



**C&S Engineers, Inc.**  
499 Col. Elleen Collins Blvd.  
Syracuse, New York 13212  
Phone: 315-455-2000  
Fax: 315-455-9687  
www.cscos.com

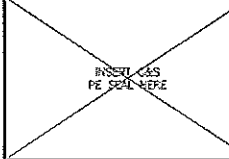

STATE UNIVERSITY CONSTRUCTION FUND  
NEW YORK

STATE UNIVERSITY CONSTRUCTION FUND  
SUCF PROJECT NO. 12290  
STATE UNIVERSITY OF NEW YORK AT POTSDAM  
PRE-BID SUBMISSION - NOT FOR CONSTRUCTION  
UPGRADE ELECTRICAL DISTRIBUTION SYSTEMS  
VARIOUS BUILDINGS

MARK	DATE	DESCRIPTION
REVISIONS		
PROJECT NO: 100-453-001		
DATE: DECEMBER 5, 2003		
SCALE: AS SHOWN		
DRAWN BY: P. N. LUJ		
DESIGNED BY: T. A. KILMERKAWZ		
CHECKED BY: J. L. ROSSINI, P.E.		
NO ALTERATION PERMITTED HEREOF EXCEPT AS PROVIDED UNDER SECTION 7209 SUBDIVISION 2 OF THE NEW YORK EDUCATION LAW		

**ELECTRICAL**  
**TIMMERMAN**  
**SECOND FLOOR**  
**PLAN**

**E-100-27b**

**S.U.C.F. PROJECT  
NO. 12294**

**UPGRADE ENERGY  
MANAGEMENT SYSTEMS -  
VARIOUS BUILDINGS**

The State University  
of New York at Potsdam  
Potsdam, New York

**STATE UNIVERSITY  
CONSTRUCTION  
FUND**

STATE UNIVERSITY PLAZA  
353 BROADWAY  
ALBANY, NY 12246



www.bergmannpc.com


28 East Main Street  
200 First Federal Plaza  
Rochester, New York 14614  
685.232.5135 / 685.232.4652 fax

Engineers / Architects / Planners / Surveyors

REVISIONS				
NO.	DATE	DESCRIPTION	REV.	CKD

**PRE-BID  
SUBMISSION**

NOTE:  
Unauthorized alteration or addition to this drawing is a  
violation of the New York State Education Law Article  
145, Section 7209.

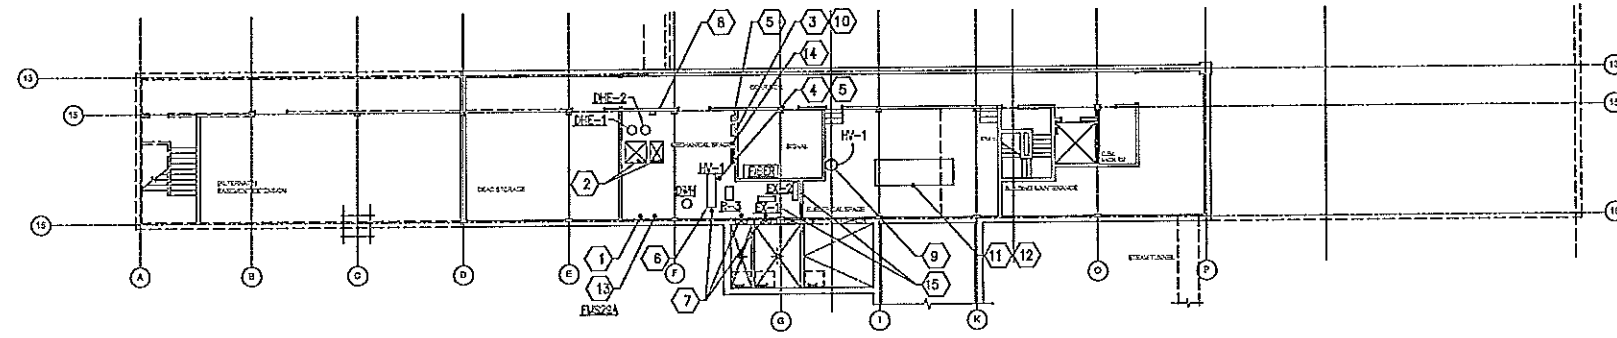

**BASEMENT PLAN**  
SCALE: 1/16" = 1'-0"

**RENOVATION KEYNOTES:**

1. EXISTING WATER METER.
2. EXISTING SNAP FITS.
3. HONEYWELL CONTROL PANEL TO BE REMOVED. TRANSFER 110V POWER TO NEW PANEL IN SAME LOCATION. PROVIDE 3/4" EMT CONDUIT WITH (3) MULTI-WIRE PFCR CTRD. CABLES FROM FEEDER PATCH PANEL TO NEW CONTROL PANEL.
4. HV-1 HEATING COIL CONTROL VALVES. REUSE VALVE ACTUATORS. INSTALL EP TRANSDUCERS AND LOCATE IN NEW CONTROL PANEL.
5. RECIRCULATION PUMP P-ENH FOR PREHEAT COIL. PROVIDE CONVECTION MOTOR STARTER WITH H-0-A SELECTOR SWITCH. PROVIDE STATUS POINTS AND DOO START/STOP CAPABILITIES. SEE FLOW DIAGRAM.
6. REMOVE EXISTING SENSORS AND INSTALL NEW TEMPERATURE, HUMIDITY AND LOW LIMIT SENSORS FOR HV-1. REFER TO FLOW DIAGRAM AND POINTS LIST. CONNECT TO NEW CONTROL PANEL IN THIS ROOM. PATCH HOLES IN DUCTWORK FROM SENSOR REMOVALS.
7. EXISTING VALVES FOR HV-1 SYSTEM. REUSE ACTUATORS. INSTALL TRANSDUCERS AS REQUIRED BY POINTS LIST AND LOCATE IN NEW CONTROL PANEL IN THIS ROOM.
8. DOMESTIC HOT WATER SYSTEM. REFER TO FLOW DIAGRAM AND POINTS LIST FOR DETAILS. PROVIDE CONVECTION MOTOR STARTER WITH H-0-A SELECTOR SWITCH FOR P-ENH. PROVIDE STATUS POINTS AND DOO START/STOP CAPABILITIES. SEE FLOW DIAGRAM.
9. EXISTING TEMPERATURE SENSOR ON WALL. REMOVE AND REPLACE WITH NEW SENSOR AND REUSE TO NEW CONTROL PANEL.
10. SUGGESTED LOCATION FOR NEW CONTROL PANEL.
11. EXISTING 3 PHASE TEMPERATURE MONITOR. PROVIDE TIE-INS TO DOO PANEL.
12. PROVIDE OUTLET WARMER POWER QUALITY METER. PROVIDE TIE-INS TO DOO PANEL. SEE WIRING DIAGRAM #19 ON DRAWING AIG-064.
13. EXISTING STEAM ENTRY. PROVIDE NEW FLOW METER FMS-23A. PROVIDE 3/4" EMT CONDUIT WITH 2-#12 AND 1-#12 GROUND FROM 110V POWER SUPPLY IN KEYNOTE #3.
14. PROPOSED LOCATION OF SEPARATE STEAM METER DISPLAY AND FLOW PROCESSOR. PROVIDE 3/4" EMT CONDUIT BETWEEN SEPARATE METER AND STEAM ENTRY IN KEYNOTE #13. INSTALL FACTORY SUPPLIED CASING.
15. PROVIDE CONVECTION MOTOR STARTERS WITH H-0-A SELECTOR SWITCH FOR EXHAUST FANS EX-1 AND EX-2. PROVIDE STATUS POINTS AND DOO START/STOP CAPABILITIES. REFER TO FLOW DIAGRAM AND POINTS LIST FOR DETAILS.

**BARRINGTON  
BASEMENT PLAN**

Project Manager	D. PORTER
Designer	M. SOMMERMAN
Checker	G. FAJER
Drawn by	
Date	JANUARY 18, 2012
Scale	AS NOTED

Project Number: 7771.00  
Drawing Number: ATC100-29

**ATC100-29**



www.bergmannpc.com

28 East Main Street  
200 First Federal Plaza  
Rochester, New York 14614  
685.232.5135 / 685.232.4652 fax

Engineers / Architects / Planners / Surveyors

REVISIONS				
NO.	DATE	DESCRIPTION	REV.	CKD

**PRE-BID  
SUBMISSION**


NOTE:  
Unauthorized alteration or addition to this drawing is a  
violation of the New York State Education Law Article  
145, Section 7209.

**BARRINGTON  
FIRST FLOOR PLAN**

Project Manager:  
**D. PORTER**  
Designer:  
**M. SCHWEMERMAN**  
Drawn by:  
**G. PARKER**  
Checked by:  
  
Date Issued:  
JANUARY 18, 2008  
Scale:  
**AS NOTED**

Project Number: 7711.00 File Name:   
Drawing Number:   
© 2008 Bergmann Associates, Inc. All rights reserved. Printed in the U.S.A.

**ATC101-29**

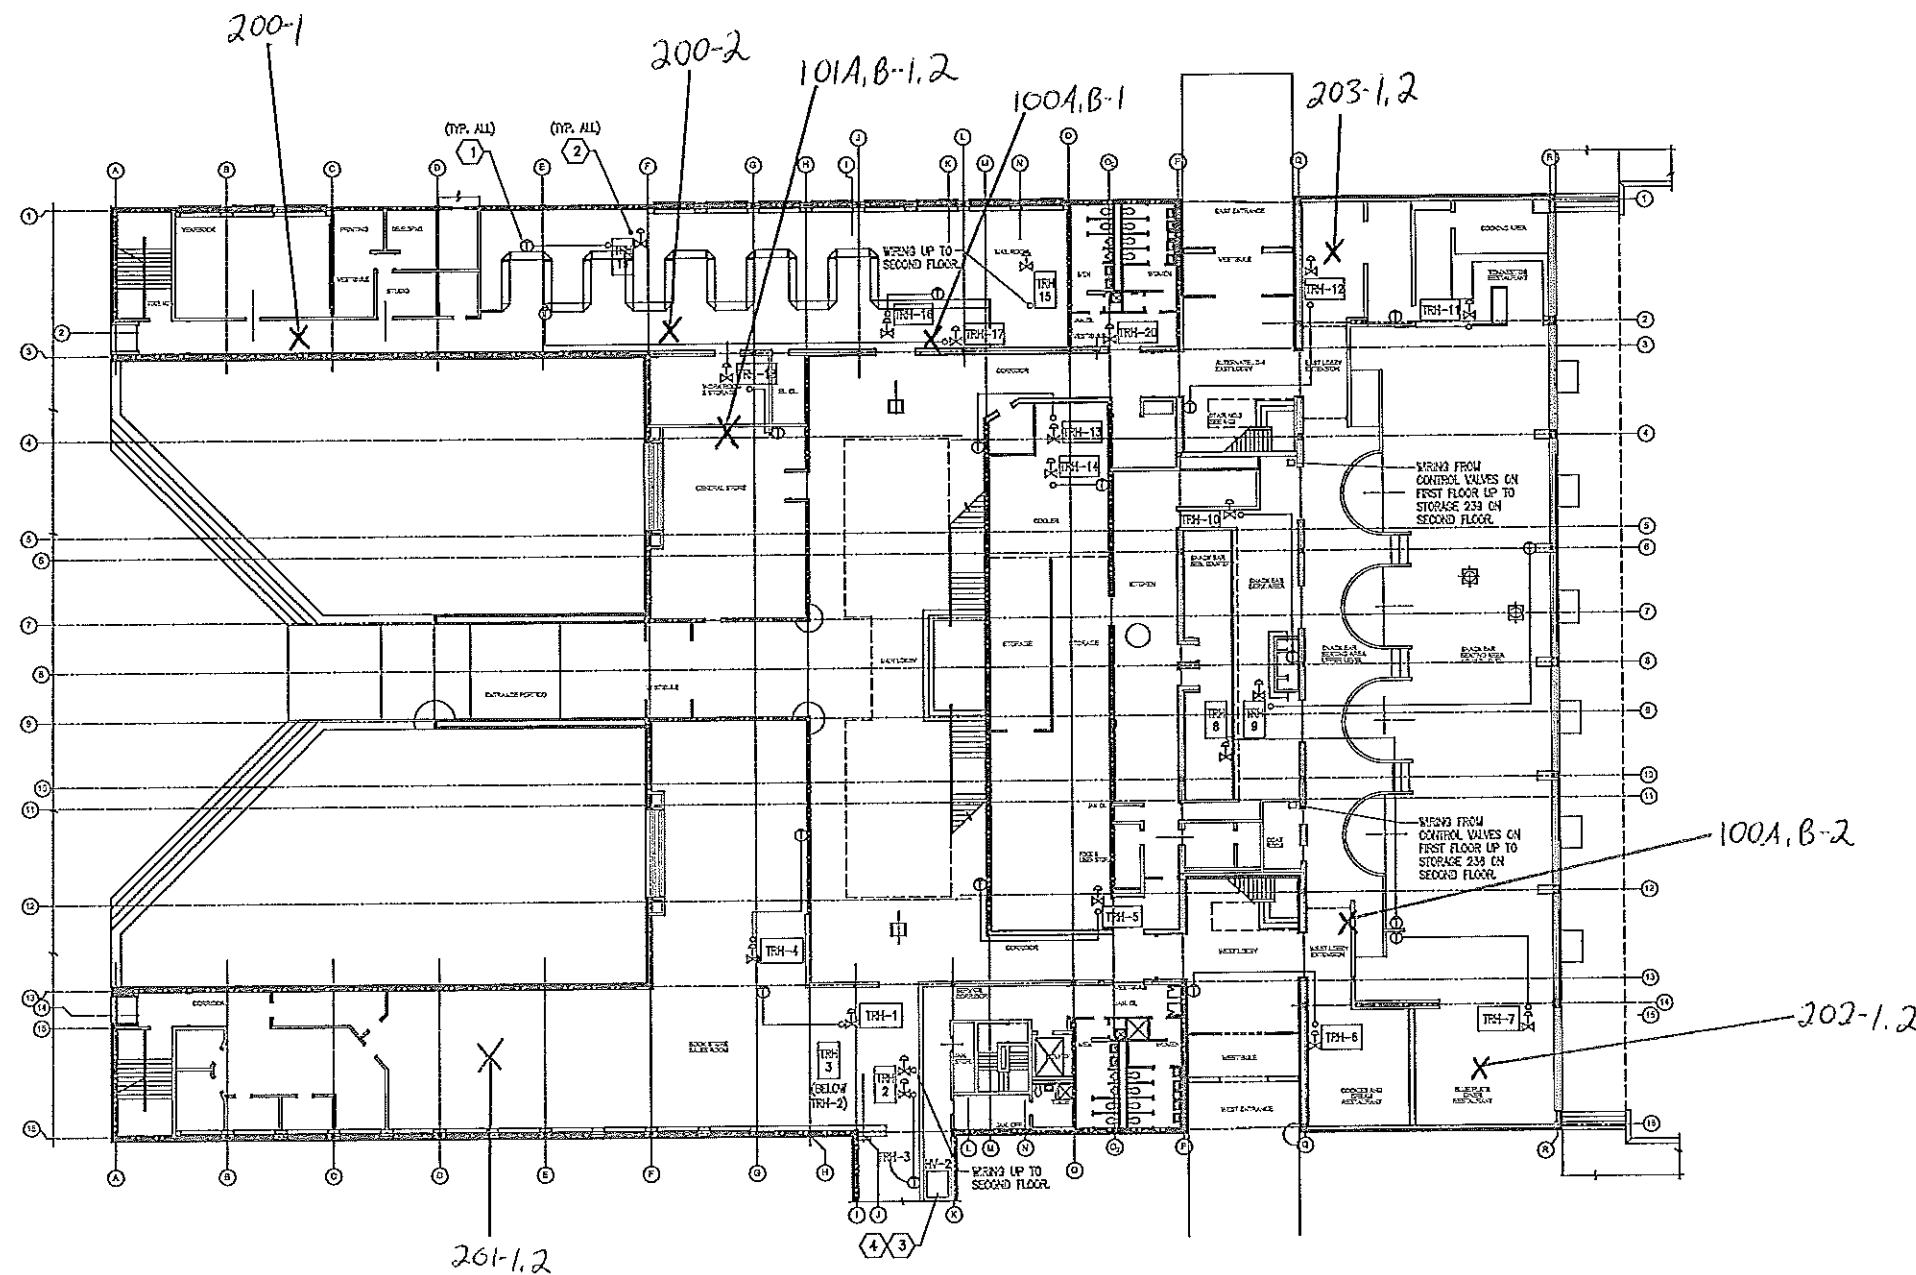

**FIRST FLOOR PLAN**  
SCALE: 1/16" = 1'-0"

**GENERAL NOTES:**

1. TYPICALLY RUN NEW WIRE/PIPE FROM NEW SENSORS UP ALONG WALL AND ACROSS CEILING TO REHEAT/COOL CONTROL VALVE ABOVE CEILING. FIELD VERIFY EXACT LOCATION OF CONTROL VALVE BEFORE START OF WORK.
2. RUN WIRE/PIPE IN CORRIDOR CLOSE TO WALL, NOT DOWN MIDDLE OF CORRIDOR.

**RENOVATION KEYNOTES:**

1. EXISTING TEMPERATURE SENSOR FOR SPACE. REMOVE AND REPLACE WITH NEW SENSOR. RUN WIRE/PIPE IN NEW WIRE/PIPE IN FINISHED SPACES. CONNECT TO NEW EP TRANSDUCER AT CONTROL VALVE AND NEW CONTROL PANEL IN MECHANICAL ROOM IN ATTIC.
2. EXISTING REHEAT VALVE ABOVE CEILING. REUSE EXISTING ACTUATOR. INSTALL EP TRANSDUCER AND CONDUIT TO NEW CONTROL PANEL IN MECHANICAL ROOM IN ATTIC.
3. PROVIDE H-O-A SELECTOR SWITCH IN EXISTING COMMUNICATION MOTOR STARTER FOR H-2. PROVIDE STATUS POINTS AND REMOTE START/STOP CAPABILITIES. SEE FLOW DIAGRAM.
4. PROVIDE TEMPERATURE SENSORS AND EP TRANSDUCER FOR H-2. REUSE EXISTING PREHEAT VALVE ACTUATOR. REFER TO FLOW DIAGRAM AND POINTS LIST FOR DETAILS.



www.bergmannpo.com

28 East Main Street  
200 First Federal Plaza  
Rochester, New York 14614  
585.232.6135 / 585.232.4652 fax

Engineers / Architects / Planners / Surveyors

REVISIONS				
NO.	DATE	DESCRIPTION	REV.	CKD

**PRE-BID  
SUBMISSION**


NOTE:  
Unauthorized alteration or addition to this drawing is a  
violation of the New York State Education Law Article  
145, Section 7209.

**BARRINGTON  
SECOND FLOOR PLAN**

Project Manager:  
**D. POKRIS**  
Designer:  
**M. SCHWARTZ**  
Drawer:  
**G. PARKER**  
Date:  
JANUARY 18, 2009  
Scale:  
**AS NOTED**

Project Number: 7711.00 File Name: BARRINGTON SECOND FLOOR PLAN  
Drawing Number: ATC102-29

**ATC102-29**

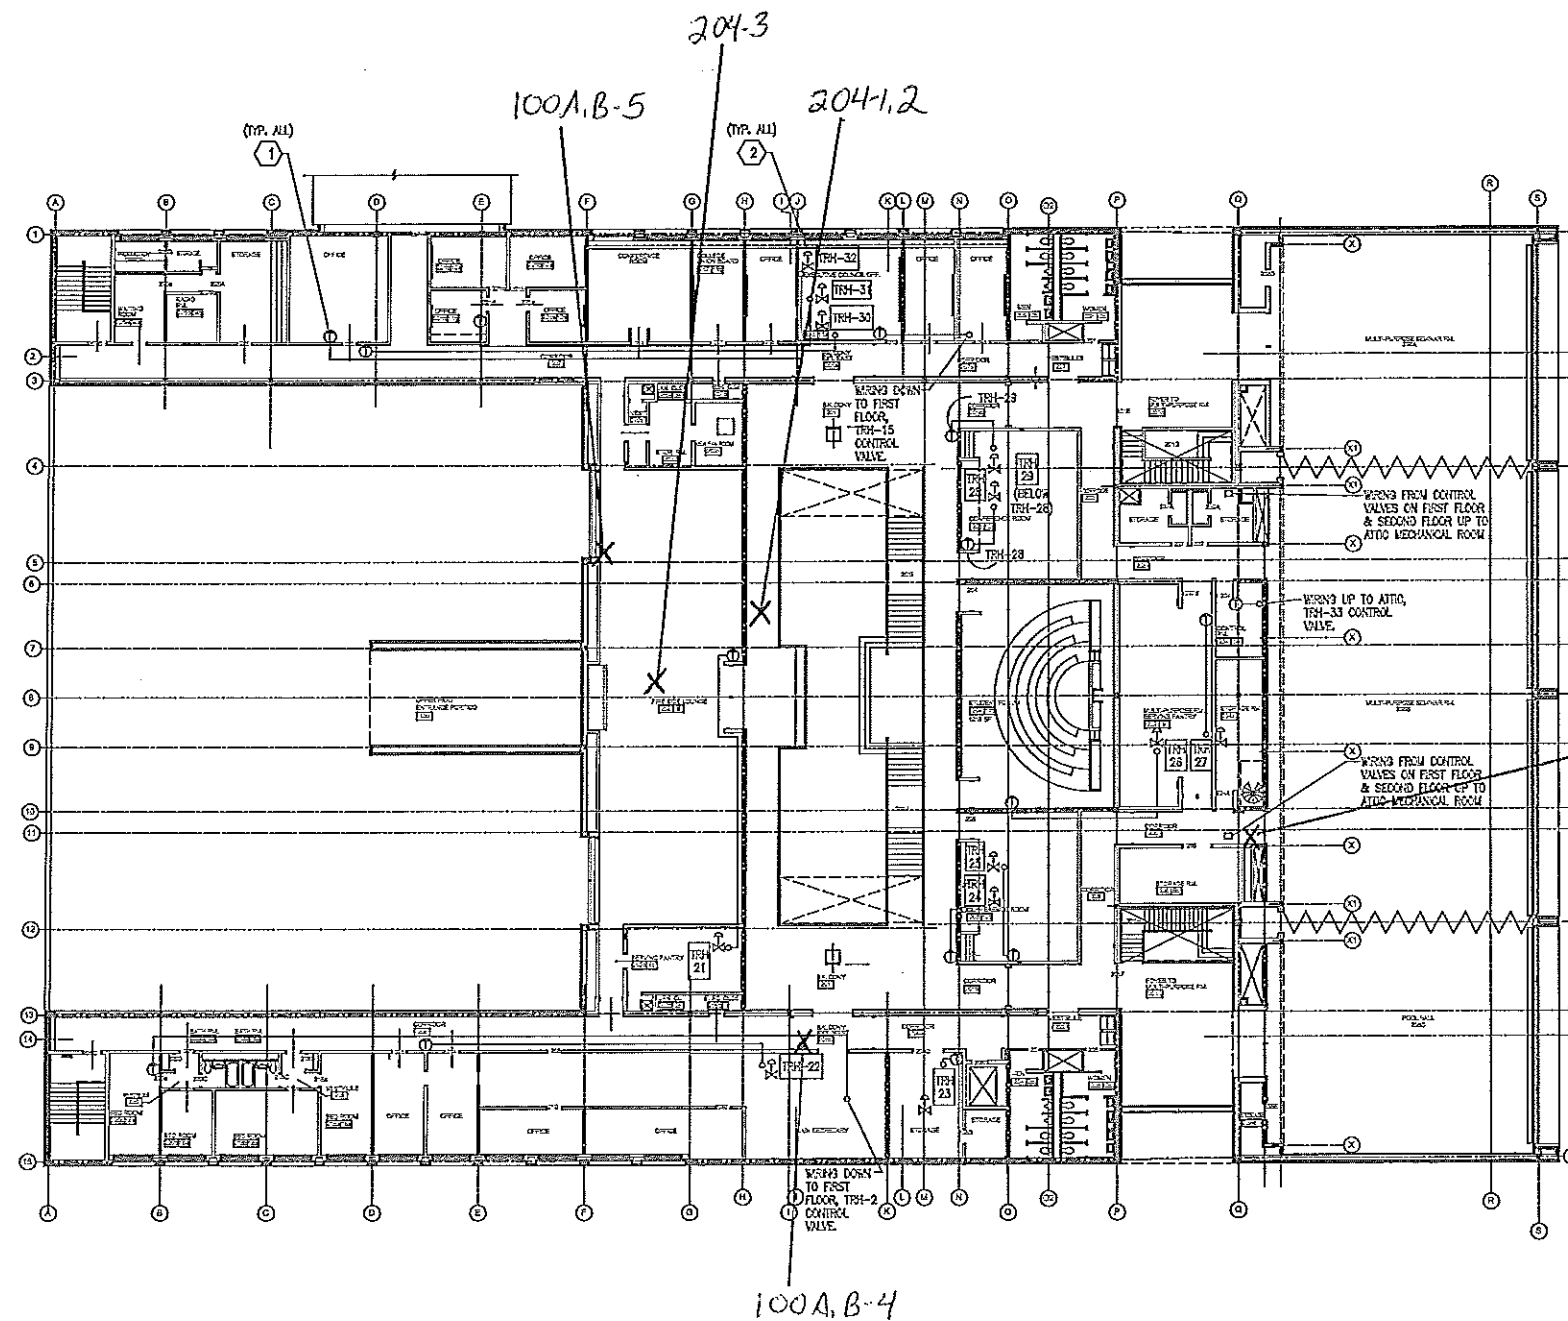

**SECOND FLOOR PLAN**  
SCALE: 1/16" = 1'-0"

**GENERAL NOTES:**


1. TOPICALLY RUN NEW WIREMOLD FROM NEW SENSORS UP ALONG WALL AND ACROSS CEILING TO REHEAT COIL CONTROL VALVE ABOVE CEILING. FIELD VERIFY EXACT LOCATION OF CONTROL VALVE BEFORE START OF WORK.
2. RUN WIREMOLD IN CORRIDOR CLOSE TO WALL, HIT DOWN MIDDLE OF CORRIDOR.

**RENOVATION KEYNOTES:**

1. EXISTING TEMPERATURE SENSOR FOR SPACE, REMOVE AND REPLACE WITH NEW SENSOR. RUN WIRING IN NEW WIREMOLD IN FINISHED SPACES. CONNECT TO NEW IP TRANSDUCER AT CONTROL VALVE AND NEW CONTROL PANEL IN MECHANICAL ROOM IN ATTIC.
2. EXISTING REHEAT VALVE ABOVE CEILING, REMOVE EXISTING ACTUATOR, INSTALL IP TRANSDUCER AND CONNECT TO NEW CONTROL PANEL IN MECHANICAL ROOM IN ATTIC.



**C&S Engineers, Inc.**  
 499 Col. Eileen Collins Blvd.  
 Syracuse, New York 13212  
 Phone: 315-455-2000  
 Fax: 315-455-9997  
 www.cscos.com

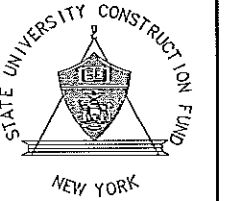



STATE UNIVERSITY CONSTRUCTION FUND  
 SUCF PROJECT NO. 12290  
 STATE UNIVERSITY OF NEW YORK AT POTSDAM  
**PRE-BID SUBMISSION - NOT FOR CONSTRUCTION**  
**UPGRADE ELECTRICAL DISTRIBUTION SYSTEMS**  
 VARIOUS BUILDINGS

MARK	DATE	DESCRIPTION
REVISIONS		

**ELECTRICAL**

**LEHMAN HALL  
 BASEMENT &  
 SECOND FLOOR  
 PLANS**

**E-100-30**

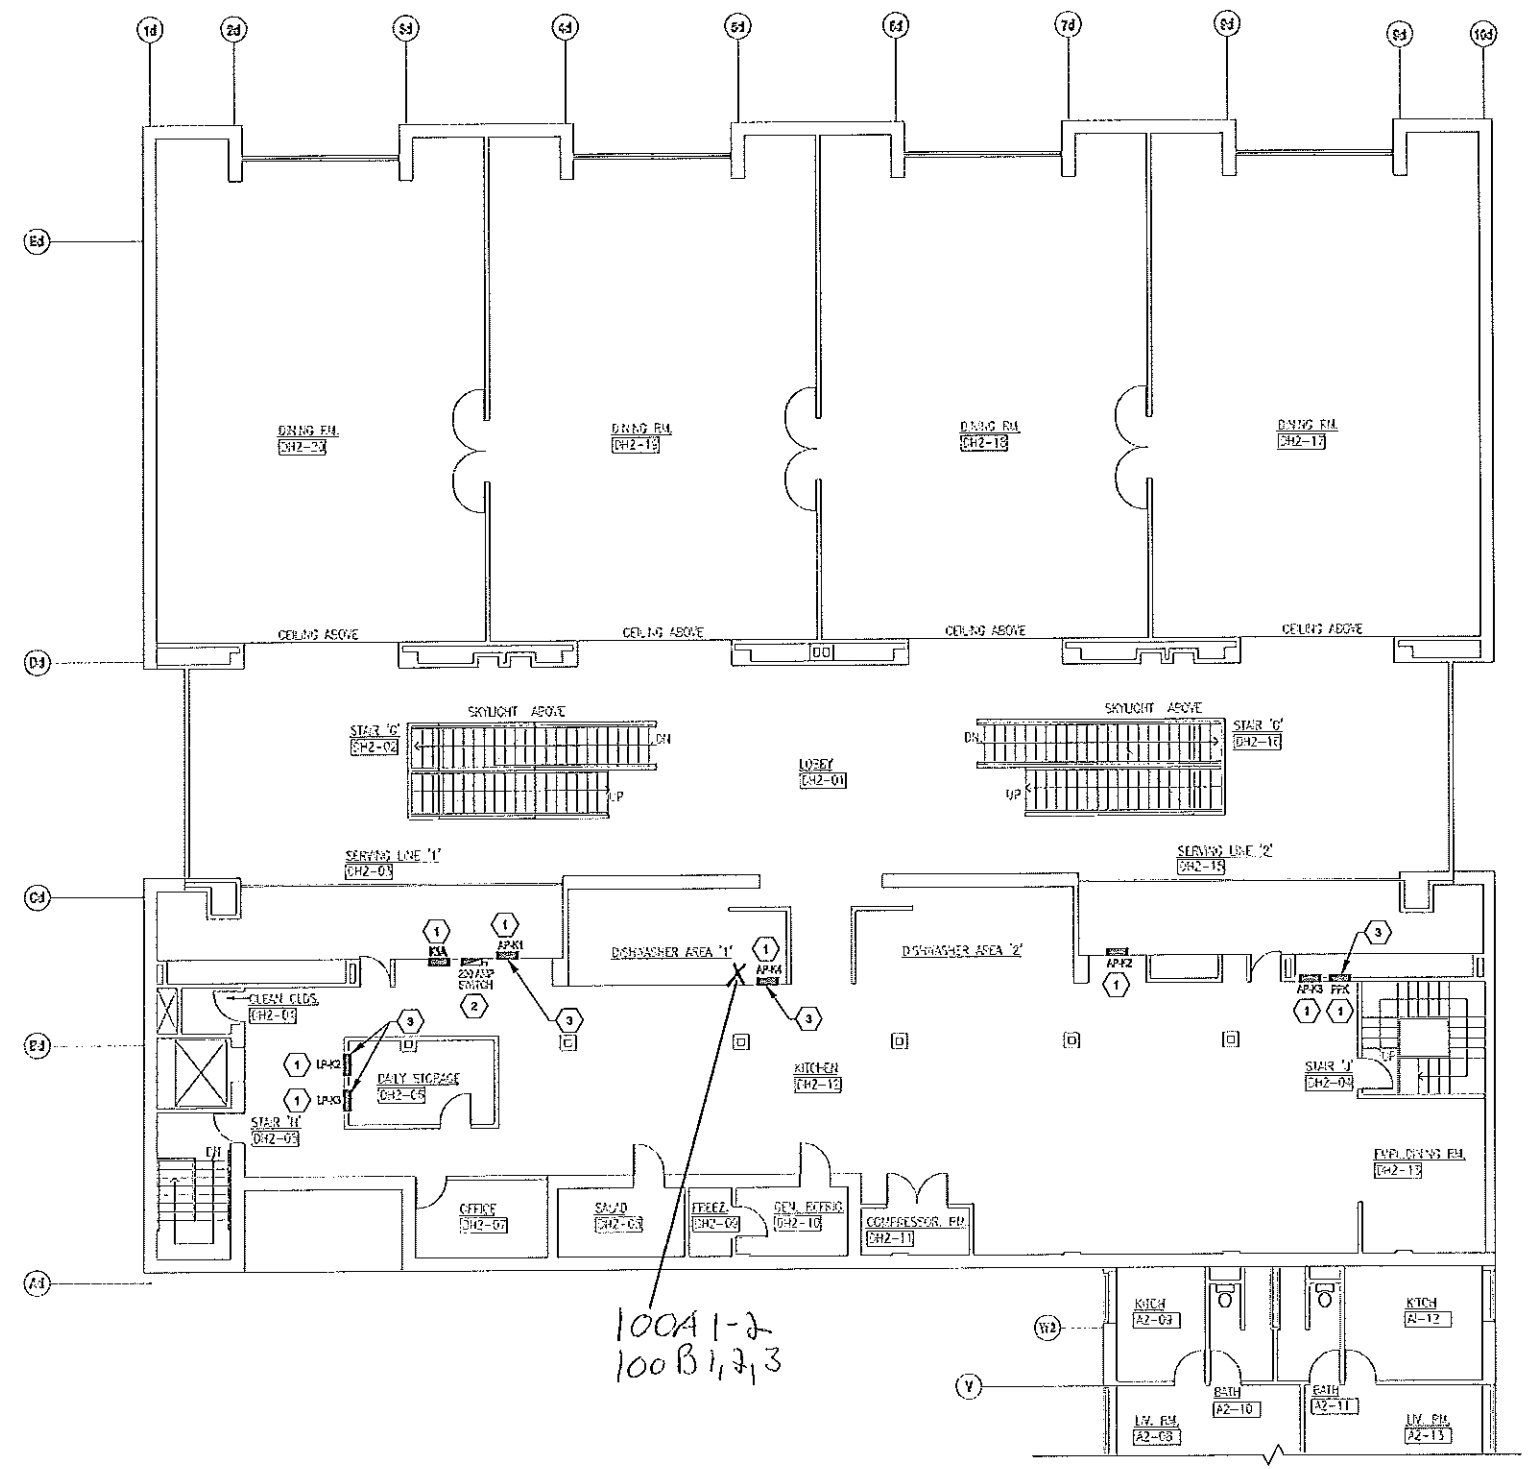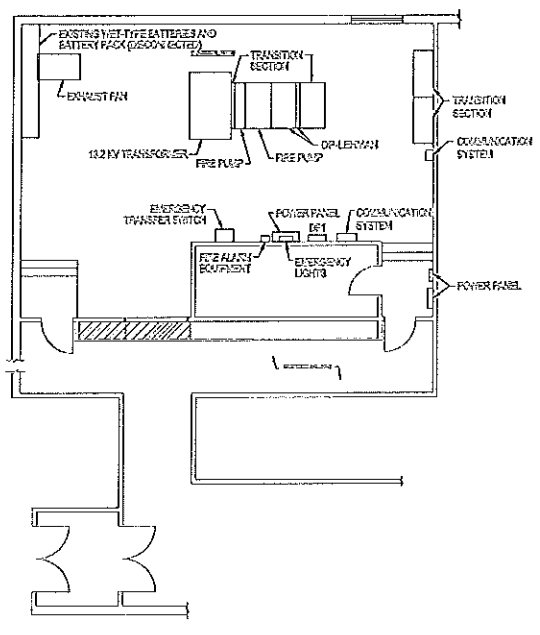

100A 1-2  
 100B 1, 2, 3

- DESIGNER SPECIFIC NOTES:**
- 1 REMOVE EXISTING PANELBOARD IN THIS LOCATION AND REPLACE WITH NEW PANEL BOARD AS SHOWN.
  - 2 REMOVE.
  - 3 SEE DETAIL DRAWING FOR ARCHITECTURAL WORK.

**A1 LEHMAN HALL - PARTIAL BASEMENT PLAN**  
 SCALE: 1/4" = 1'-0"

**A1 LEHMAN HALL - PARTIAL SECOND FLOOR PLAN**  
 SCALE: 1/4" = 1'-0"